
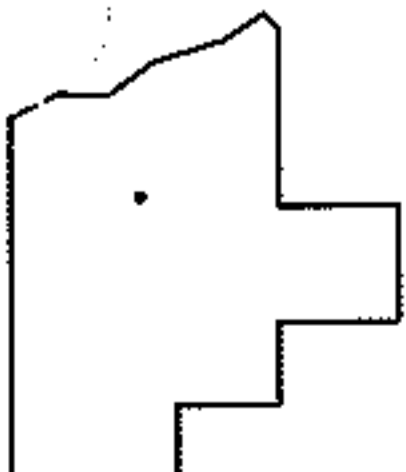
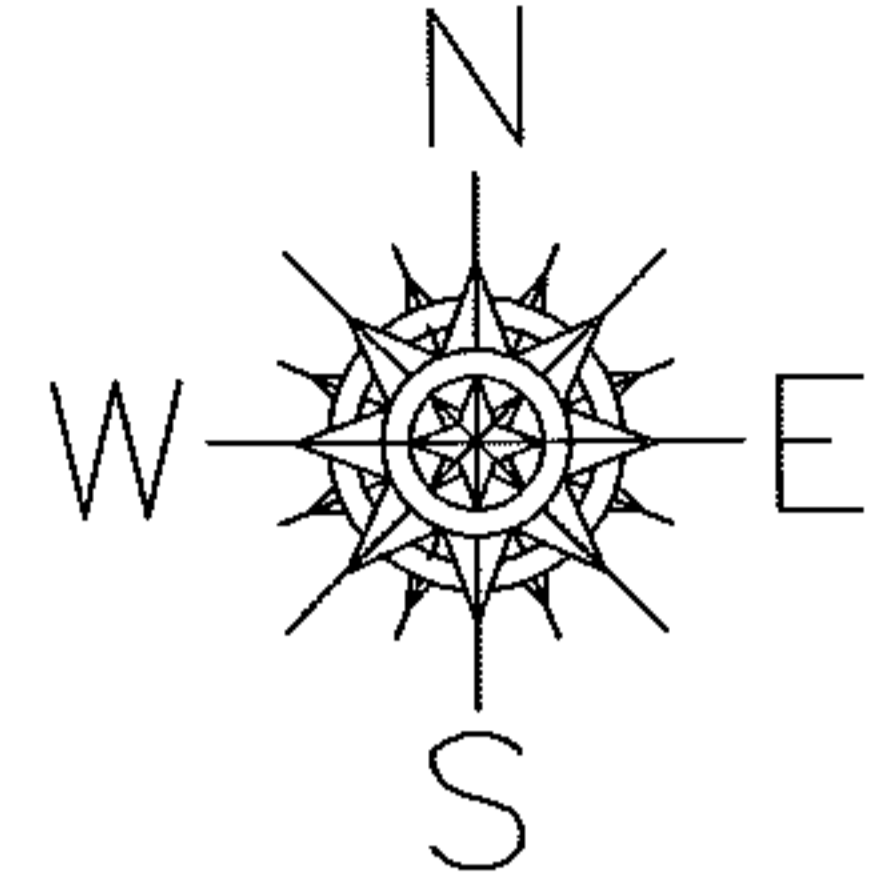


PARENT PARCEL: 04-00-023-108-124

CHILD PARCEL: 04-00-023-108-131, -132

STARTING POINT: CENTERLINE OF SCHWARTZ RD & SPRUCE CT

11-02971

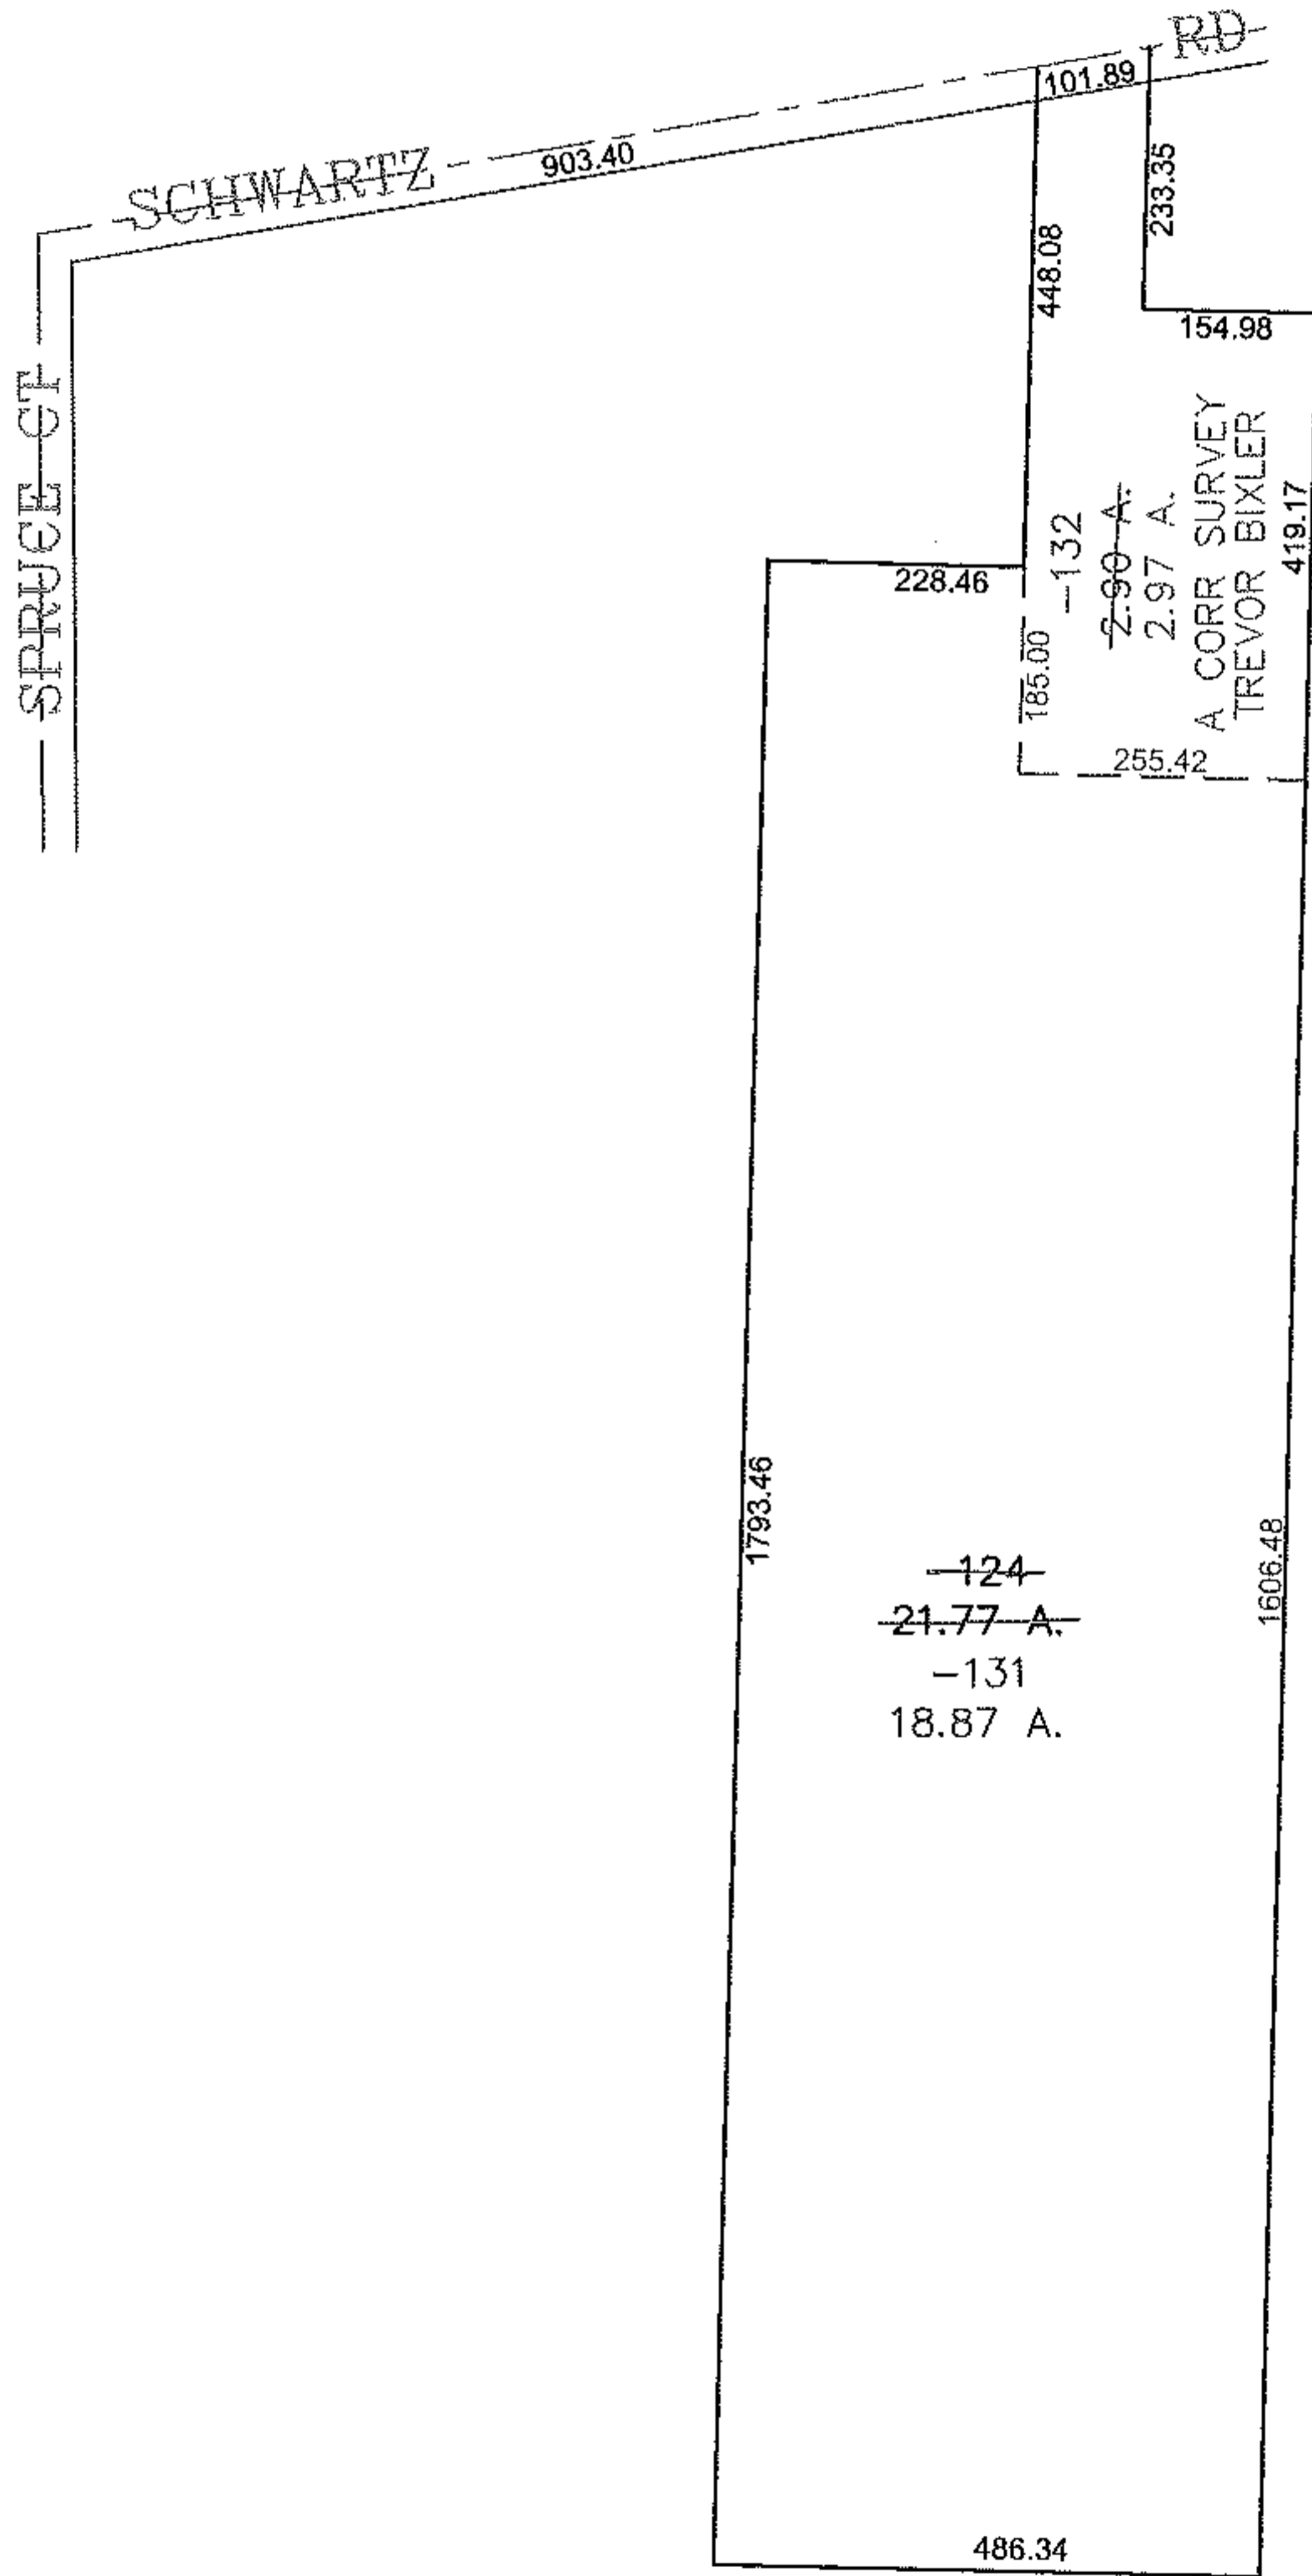

SPLITS/DEEDS PROCESSED
 LORAIN COUNTY TAX MAP DEPARTMENT
 226 MIDDLE AVE. ELYRIA, OHIO

SURVEYED BY: TREVOR BIXLER
 CLOSURE: 0.00 : 10.000
 MAP PAGE(S): 04-00-023-G
 APPROVED BY: JAH DATE: 11-22-2011
 SCALE: 1" = 300 PRIOR INSTRUMENT: 19980524199