
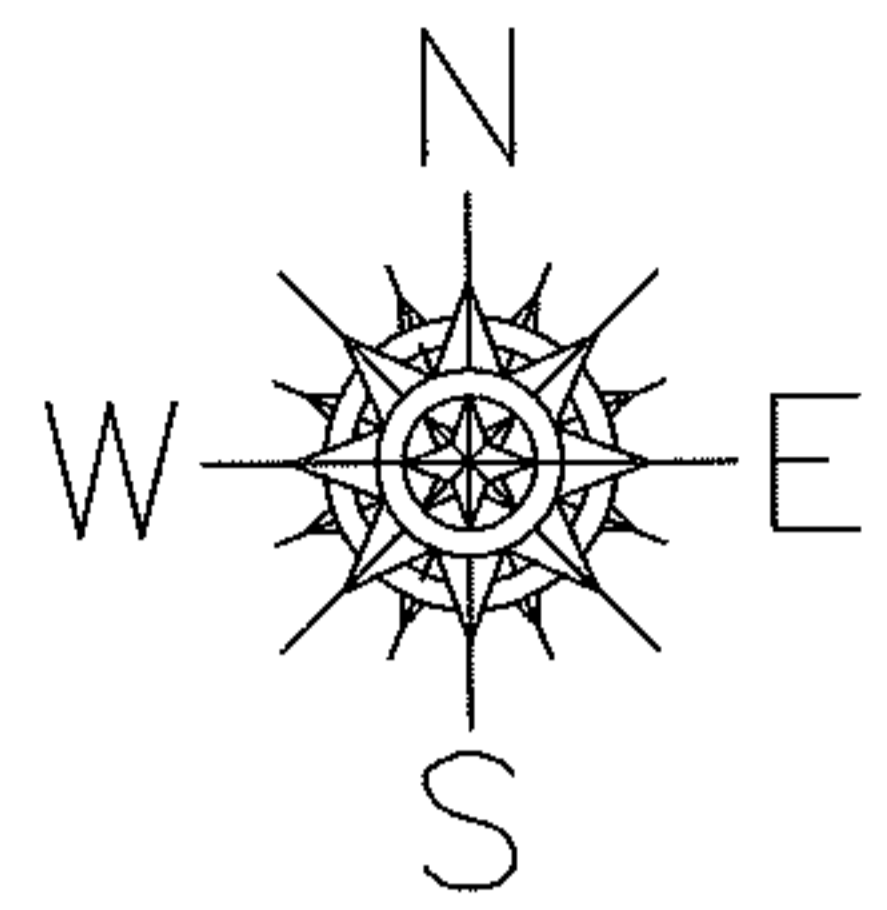


RASTER

PARENT PARCEL: 08-00-097-000-047, 08-20-025-000-021
CHILD PARCEL: 08-00-097-000-057, -058 08-20-025-000-037 THRU -039 **
STARTING POINT: CENTERLINE OF MILAN-ELYRIA RD & WEST LINE OF GORE STRIP O.L. 25
**08-14-001-000-011

11-02974

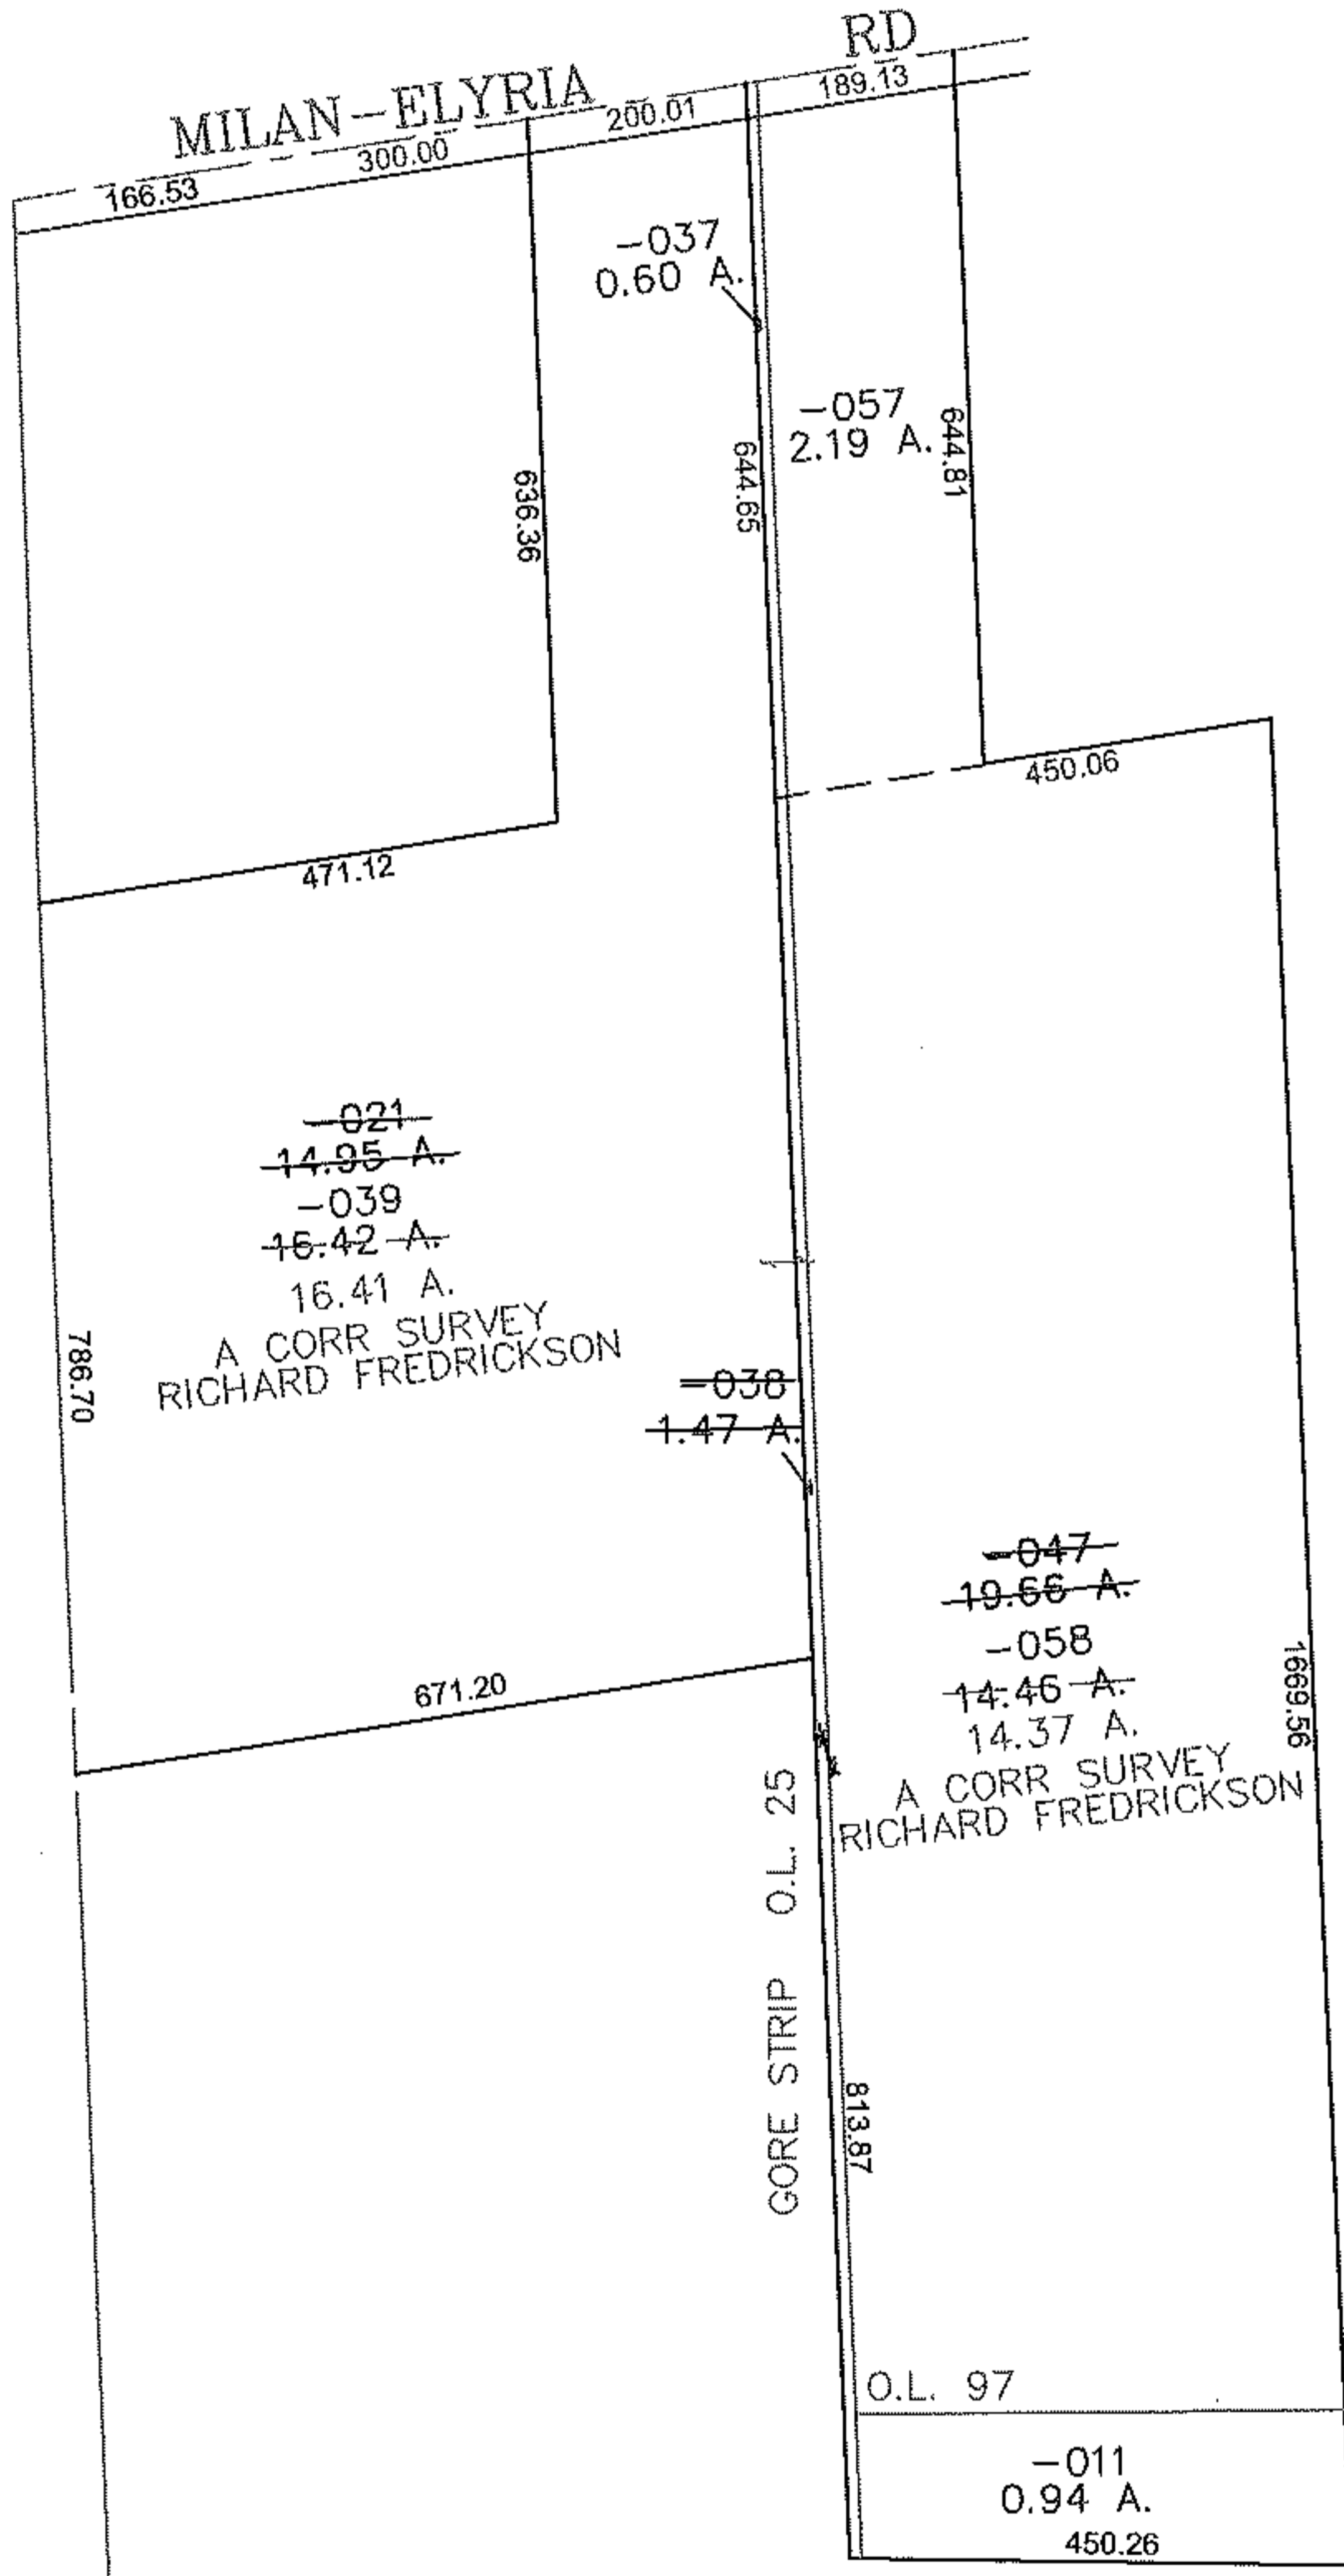

SPLITS/DEEDS PROCESSED
LORAIN COUNTY TAX MAP DEPARTMENT
 226 MIDDLE AVE. ELYRIA, OHIO

SURVEYED BY: RICHARD FREDRICKSON
 CLOSURE: 0.00 : 10.000
 MAP PAGE(S): 8-A
 APPROVED BY: JAH DATE: 12-1-2011
 SCALE: 1" = 300 PRIOR INSTRUMENT: 20000669786