
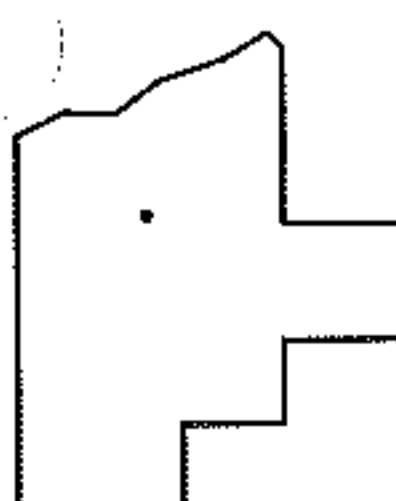
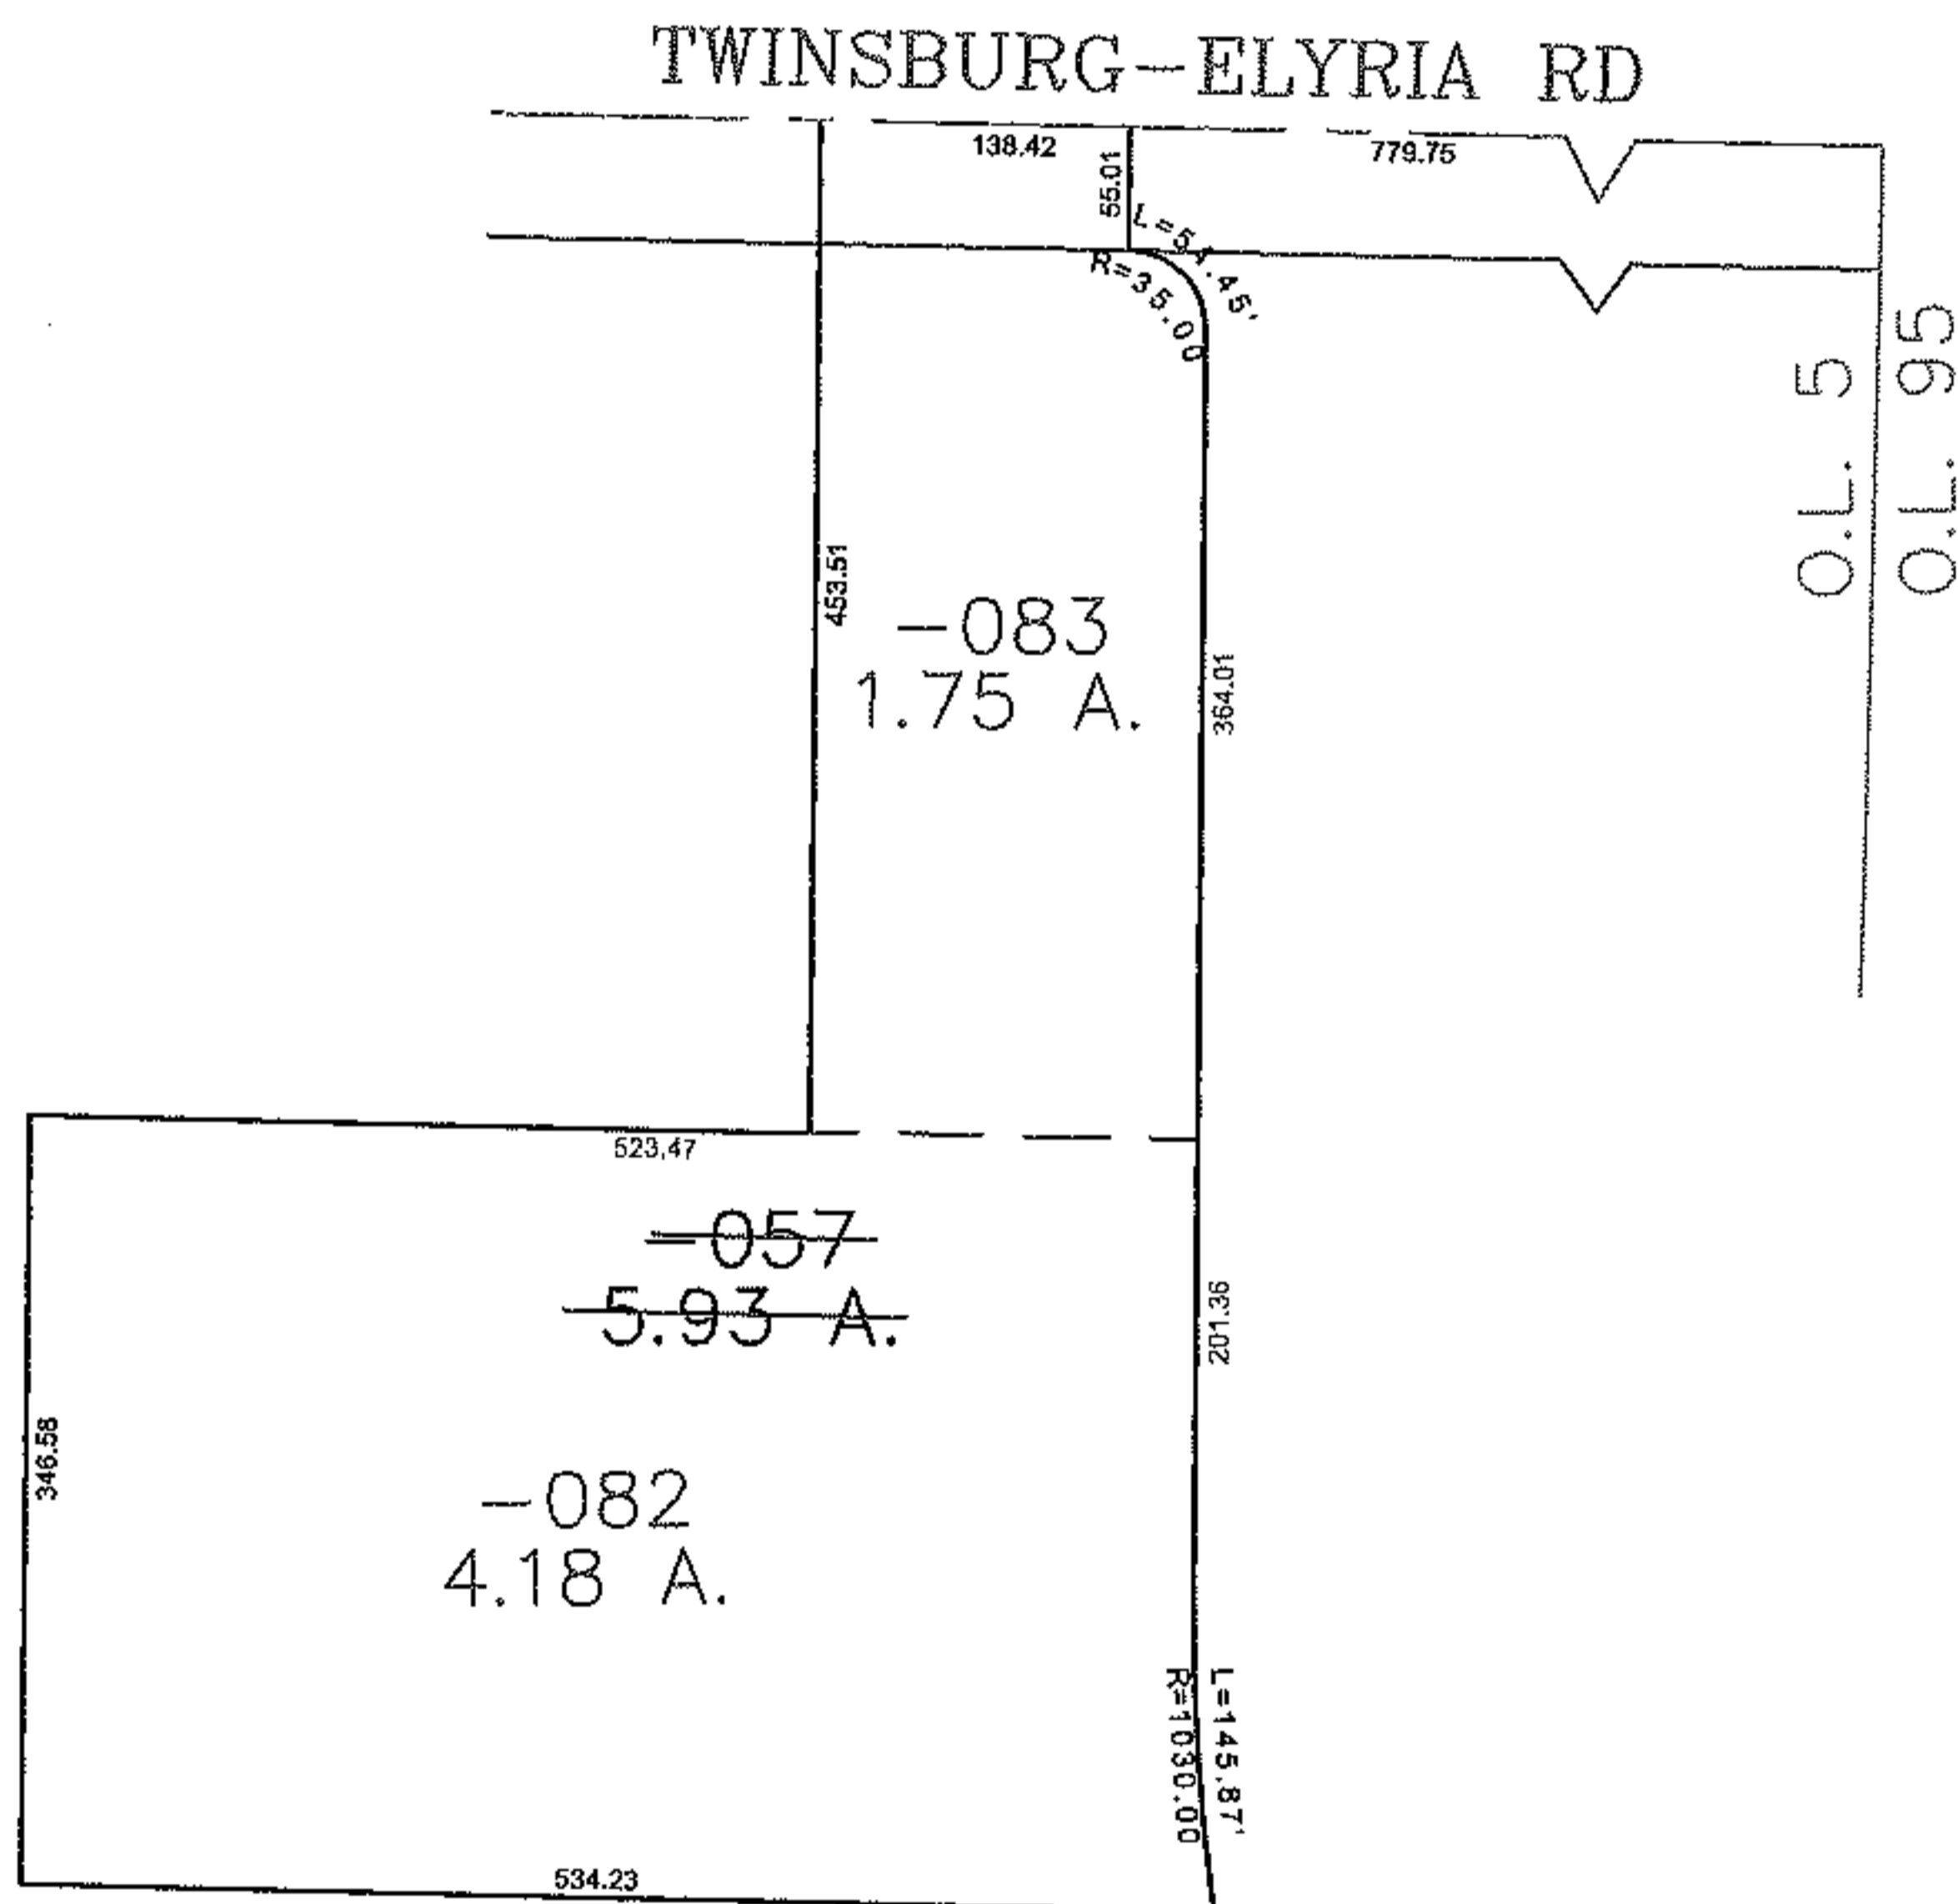


PARENT PARCEL: 11-00-005-000-057

CHILD PARCEL: 11-00-005-000-082, -083

STARTING POINT: CENTERLINE OF TWINSBURG-ELYRIA RD & O.L. 5

11-02975

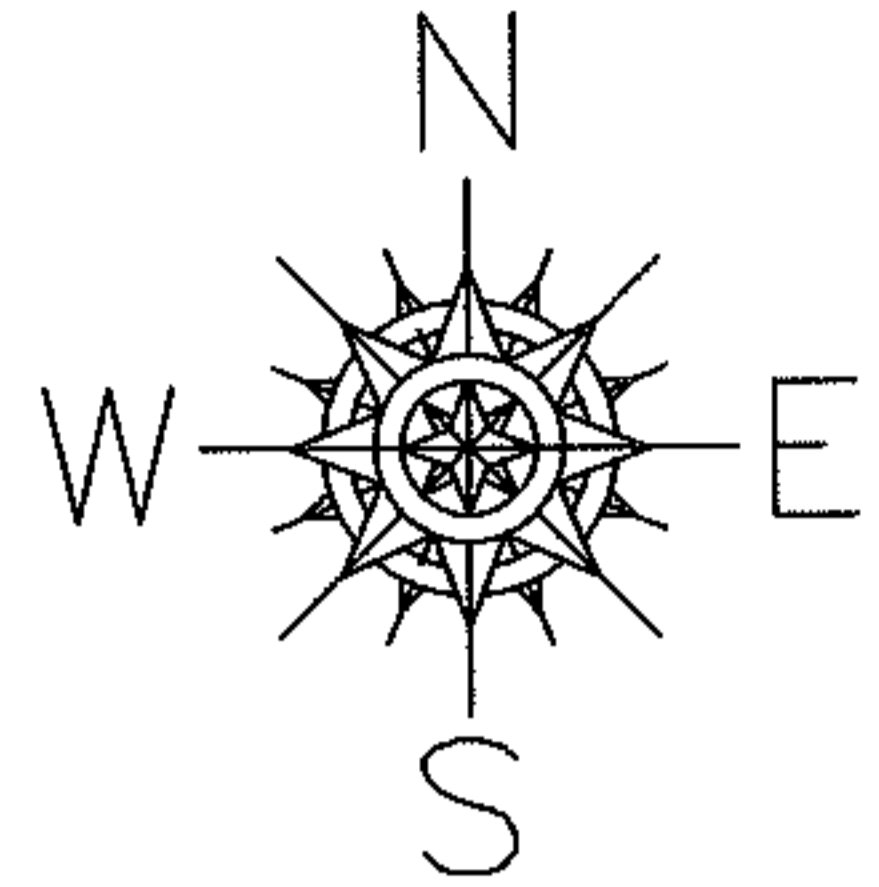

SPLITS/DEEDS PROCESSED
 LORAIN COUNTY TAX MAP DEPARTMENT
 226 MIDDLE AVE. ELYRIA, OHIO

SURVEYED BY: JAMES B ROOT
 CLOSURE: 0.00 : 10,000
 MAP PAGE(S): 11-00-005-B
 APPROVED BY: JAH DATE: 12/2/2011
 SCALE: 1" = 200 PRIOR INSTRUMENT: 20020829315