
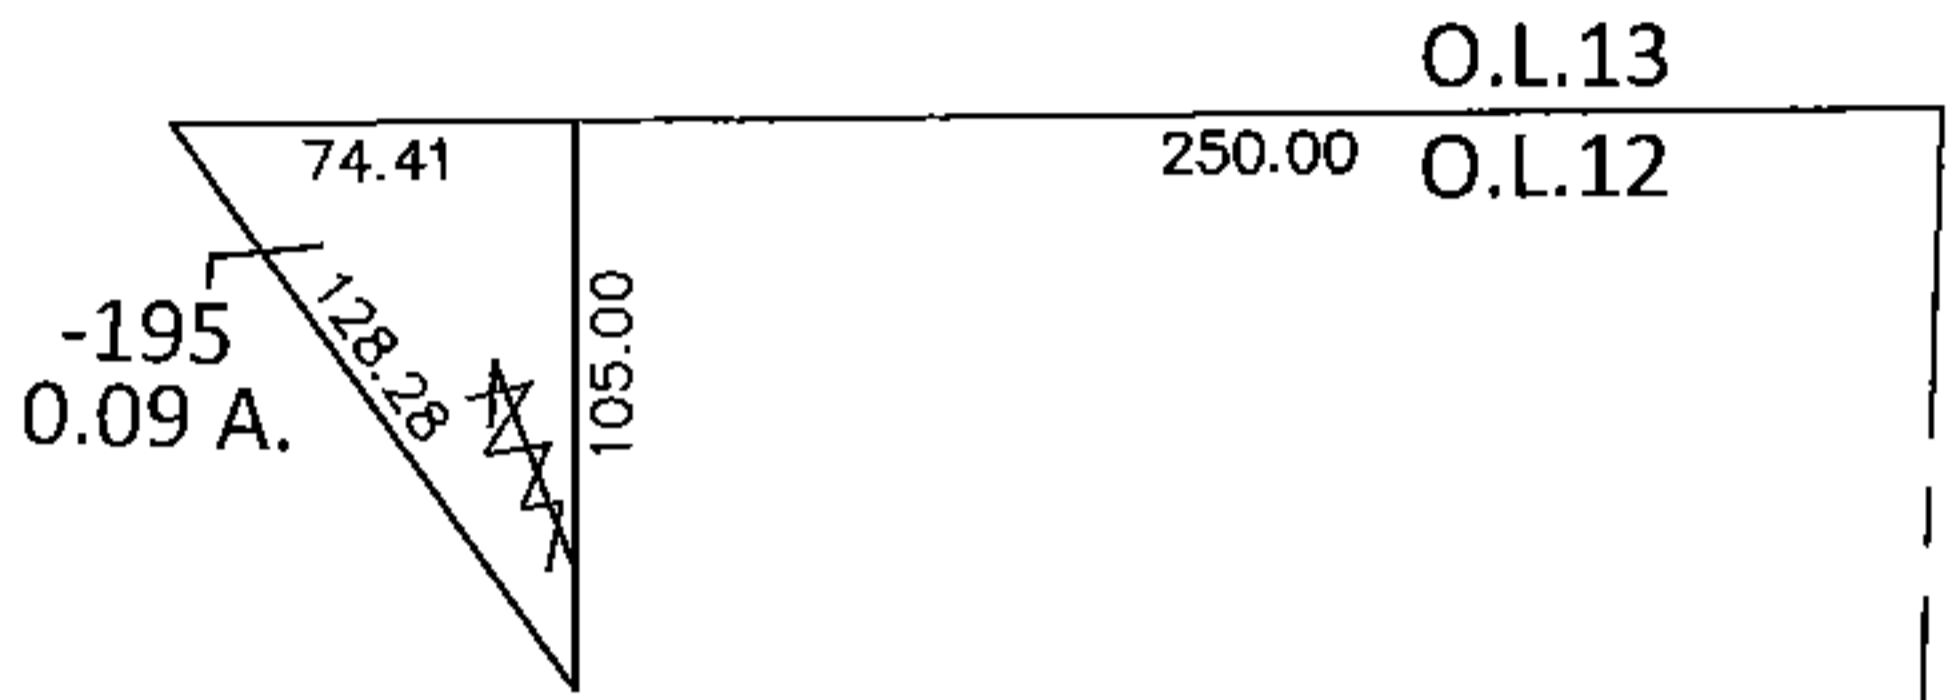


PARENT PARCEL: 03-00-012-000-155

CHILD PARCEL: 03-00-012-000-155, -195

STARTING POINT: NORTHEAST CORNER OF O.L.12

14-02976-C

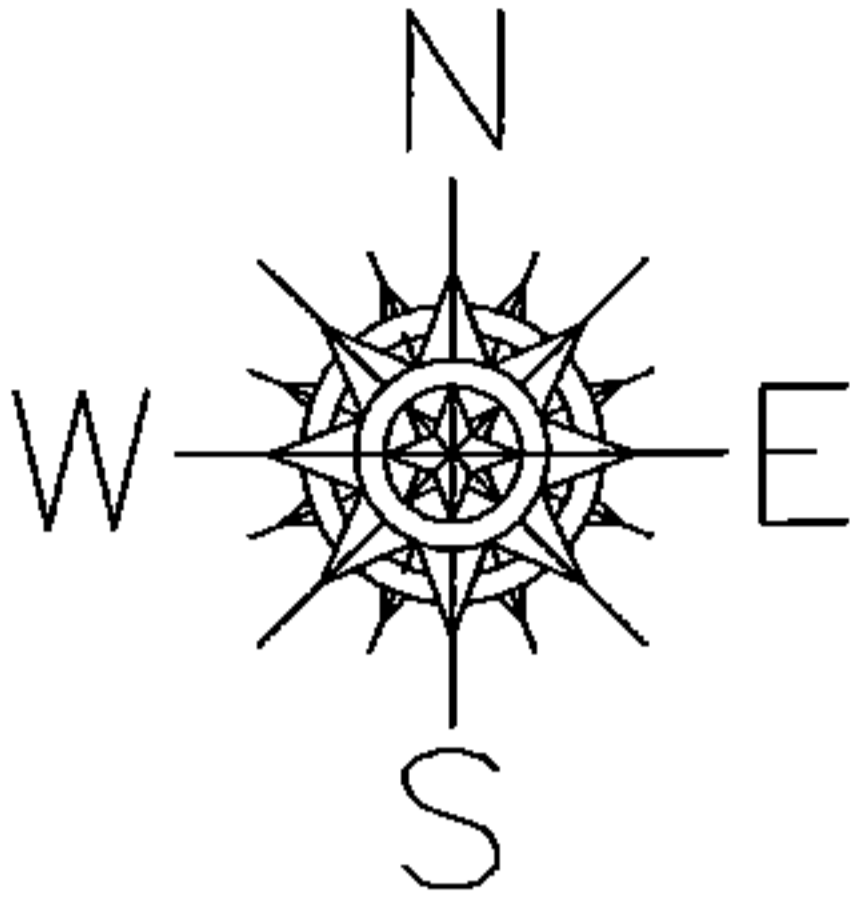

ADD TO DUPLICATE



03-00-012-000-195  
0.09 A.

LAST CONVEYED IN OR 479/728  
SHOULD HAVE BEEN A REMAINDER  
FROM A SPLIT CREATED BY OR 1122/380

IN THE NAMES OF

- HARRY R. GERENT
- CHRISTA E. GERENT
- ERNEST R. GERENT
- DAWN M. GERENT
- SCOTT M. DOANE
- KAREN G. DOANE

551.22  
ABBE RD.

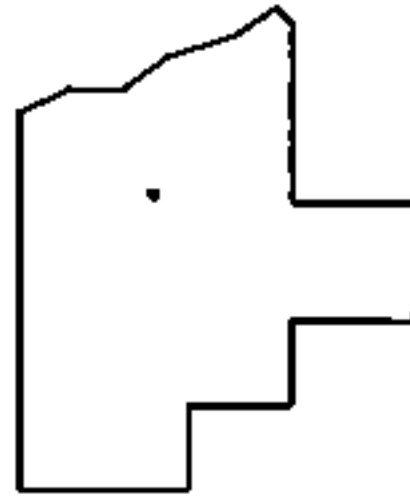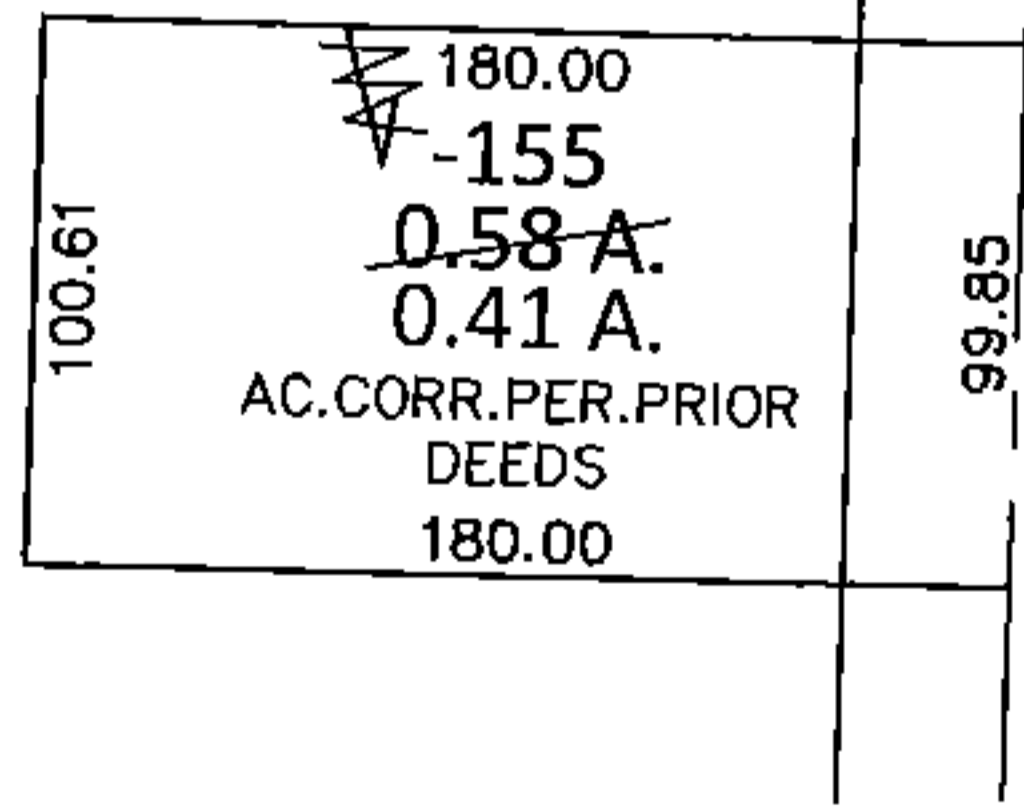

SPLITS/DEEDS PROCESSED

LORAIN COUNTY TAX MAP DEPARTMENT  
226 MIDDLE AVE. ELYRIA, OHIO

SURVEYED BY: M.G. HURA  
 CLOSURE: .00:10,000  
 MAP PAGE(S): 3-00-012-B  
 APPROVED BY: RRM DATE: 7-2-14  
 SCALE: 1"=100 PRIOR INST.: OR 1122/380