


PARENT PARCEL: 06-24-148-000-005, 06-24-149-000-005
CHILD PARCEL: _____
STARTING POINT: INTERSECTION OF NORTH LINE OF MONROE ST. AND WEST LINE OF FURNACE ST.

14-02977-D


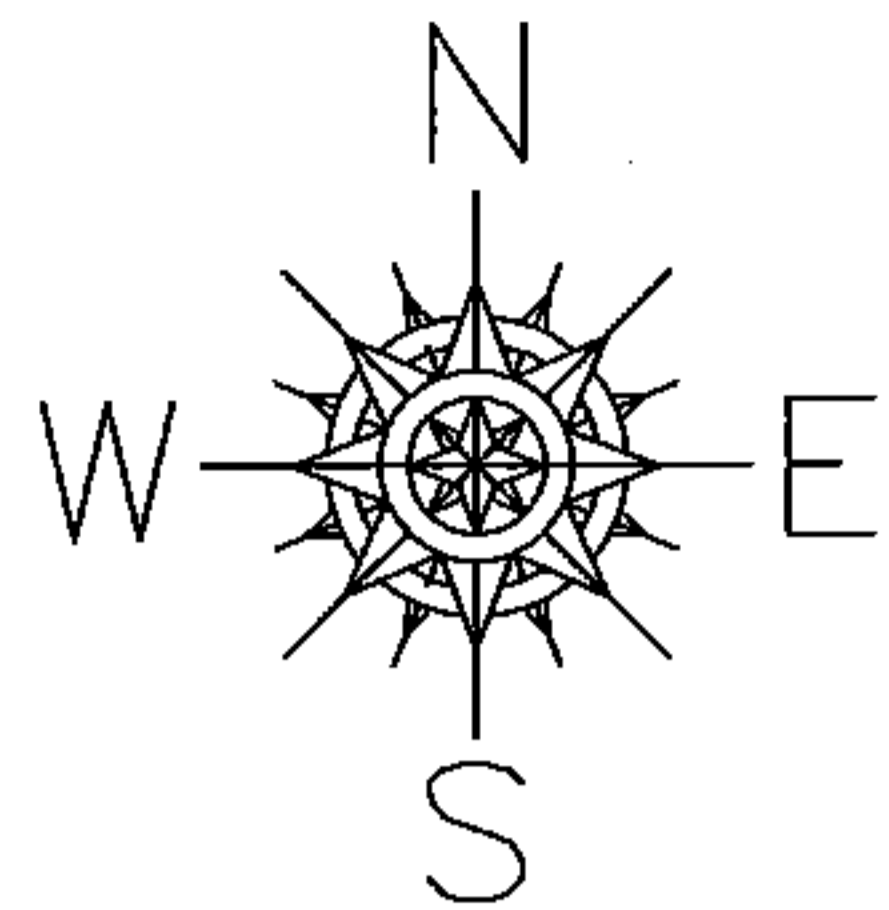


MAP CORRECTION ONLY

06-24-149-000-005
0.12 A.

FRONTAGE & DEPTH TO AC. CORR.

06-24-148-000-005
0.14 A.
~~40 X 148~~
PER SURV. D. HAYWOOD

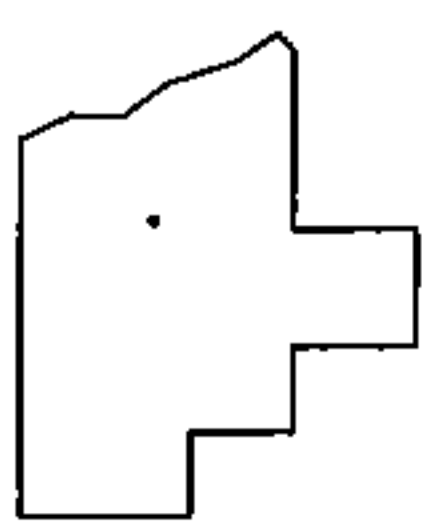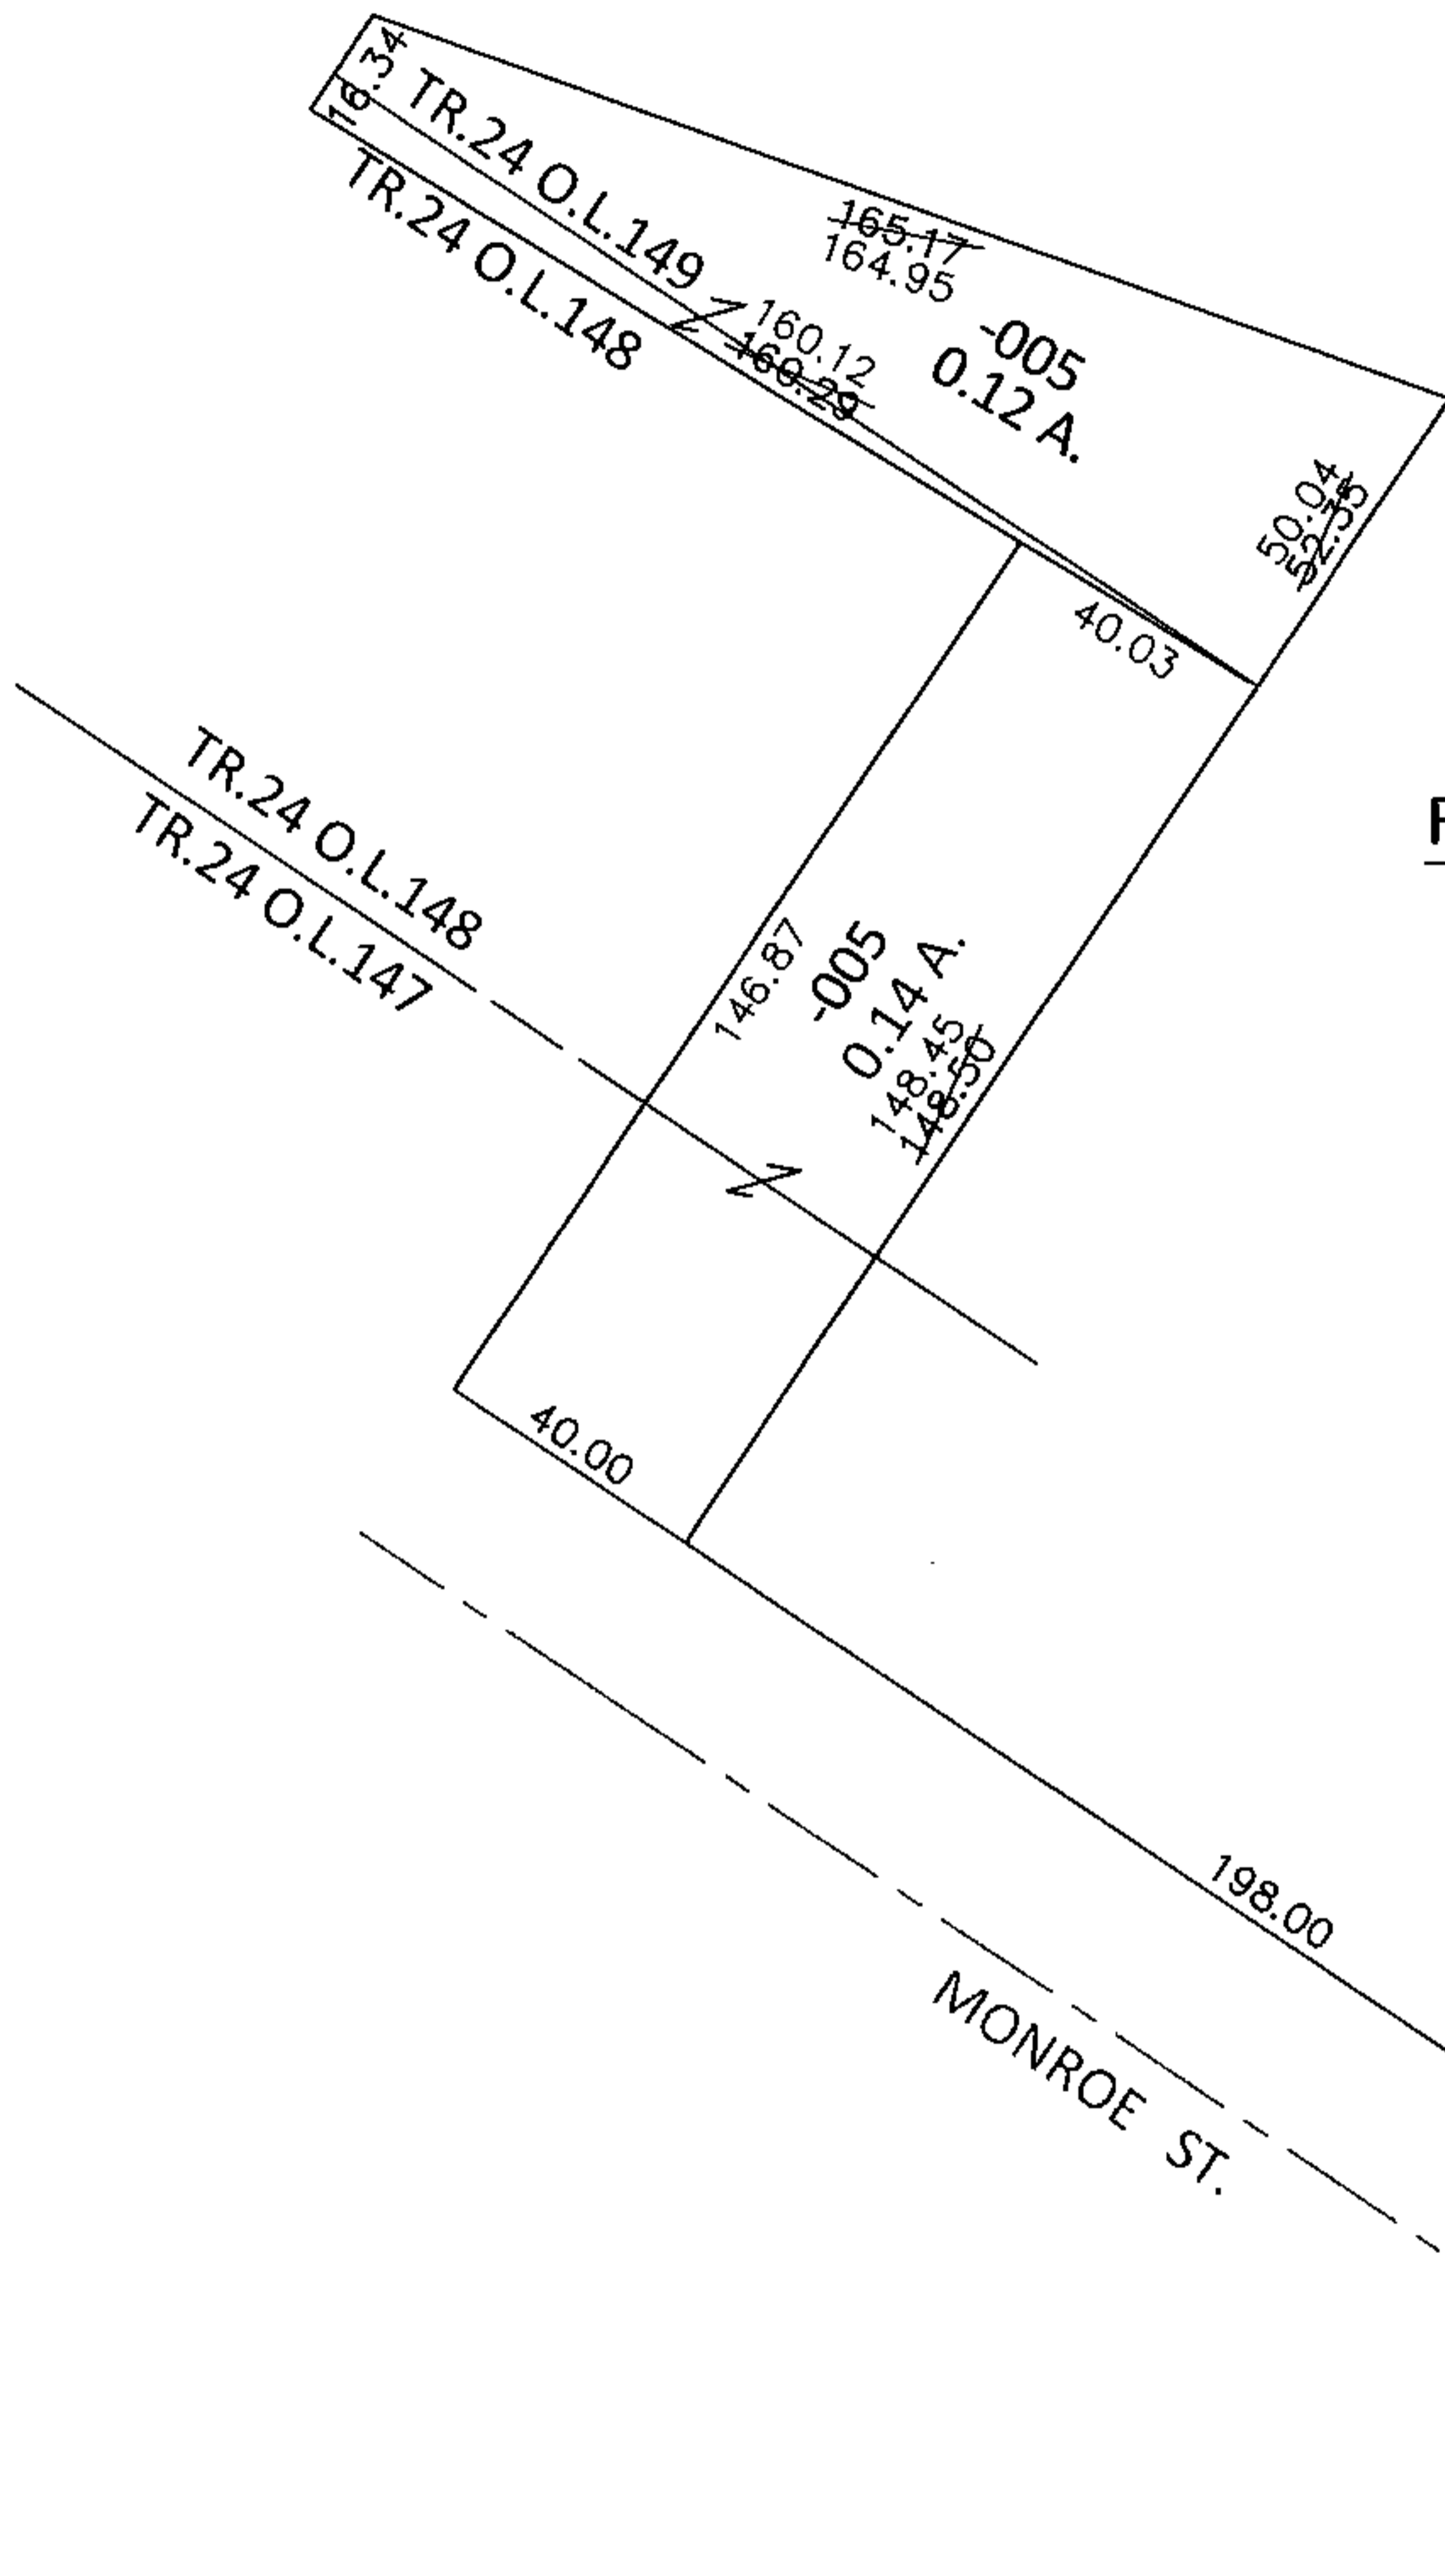

SPLITS/DEEDS PROCESSED

LORAIN COUNTY TAX MAP DEPARTMENT
226 MIDDLE AVE. ELYRIA, OHIO

SURVEYED BY: DALE R. HAYWOOD
CLOSURE: .00:10,000
MAP PAGE(S): 6-100
APPROVED BY: RRM DATE: 7-7-14
SCALE: 1"= 50' PRIOR INST.: 20120431883