
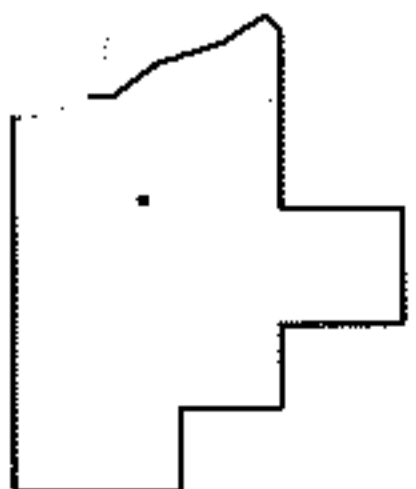
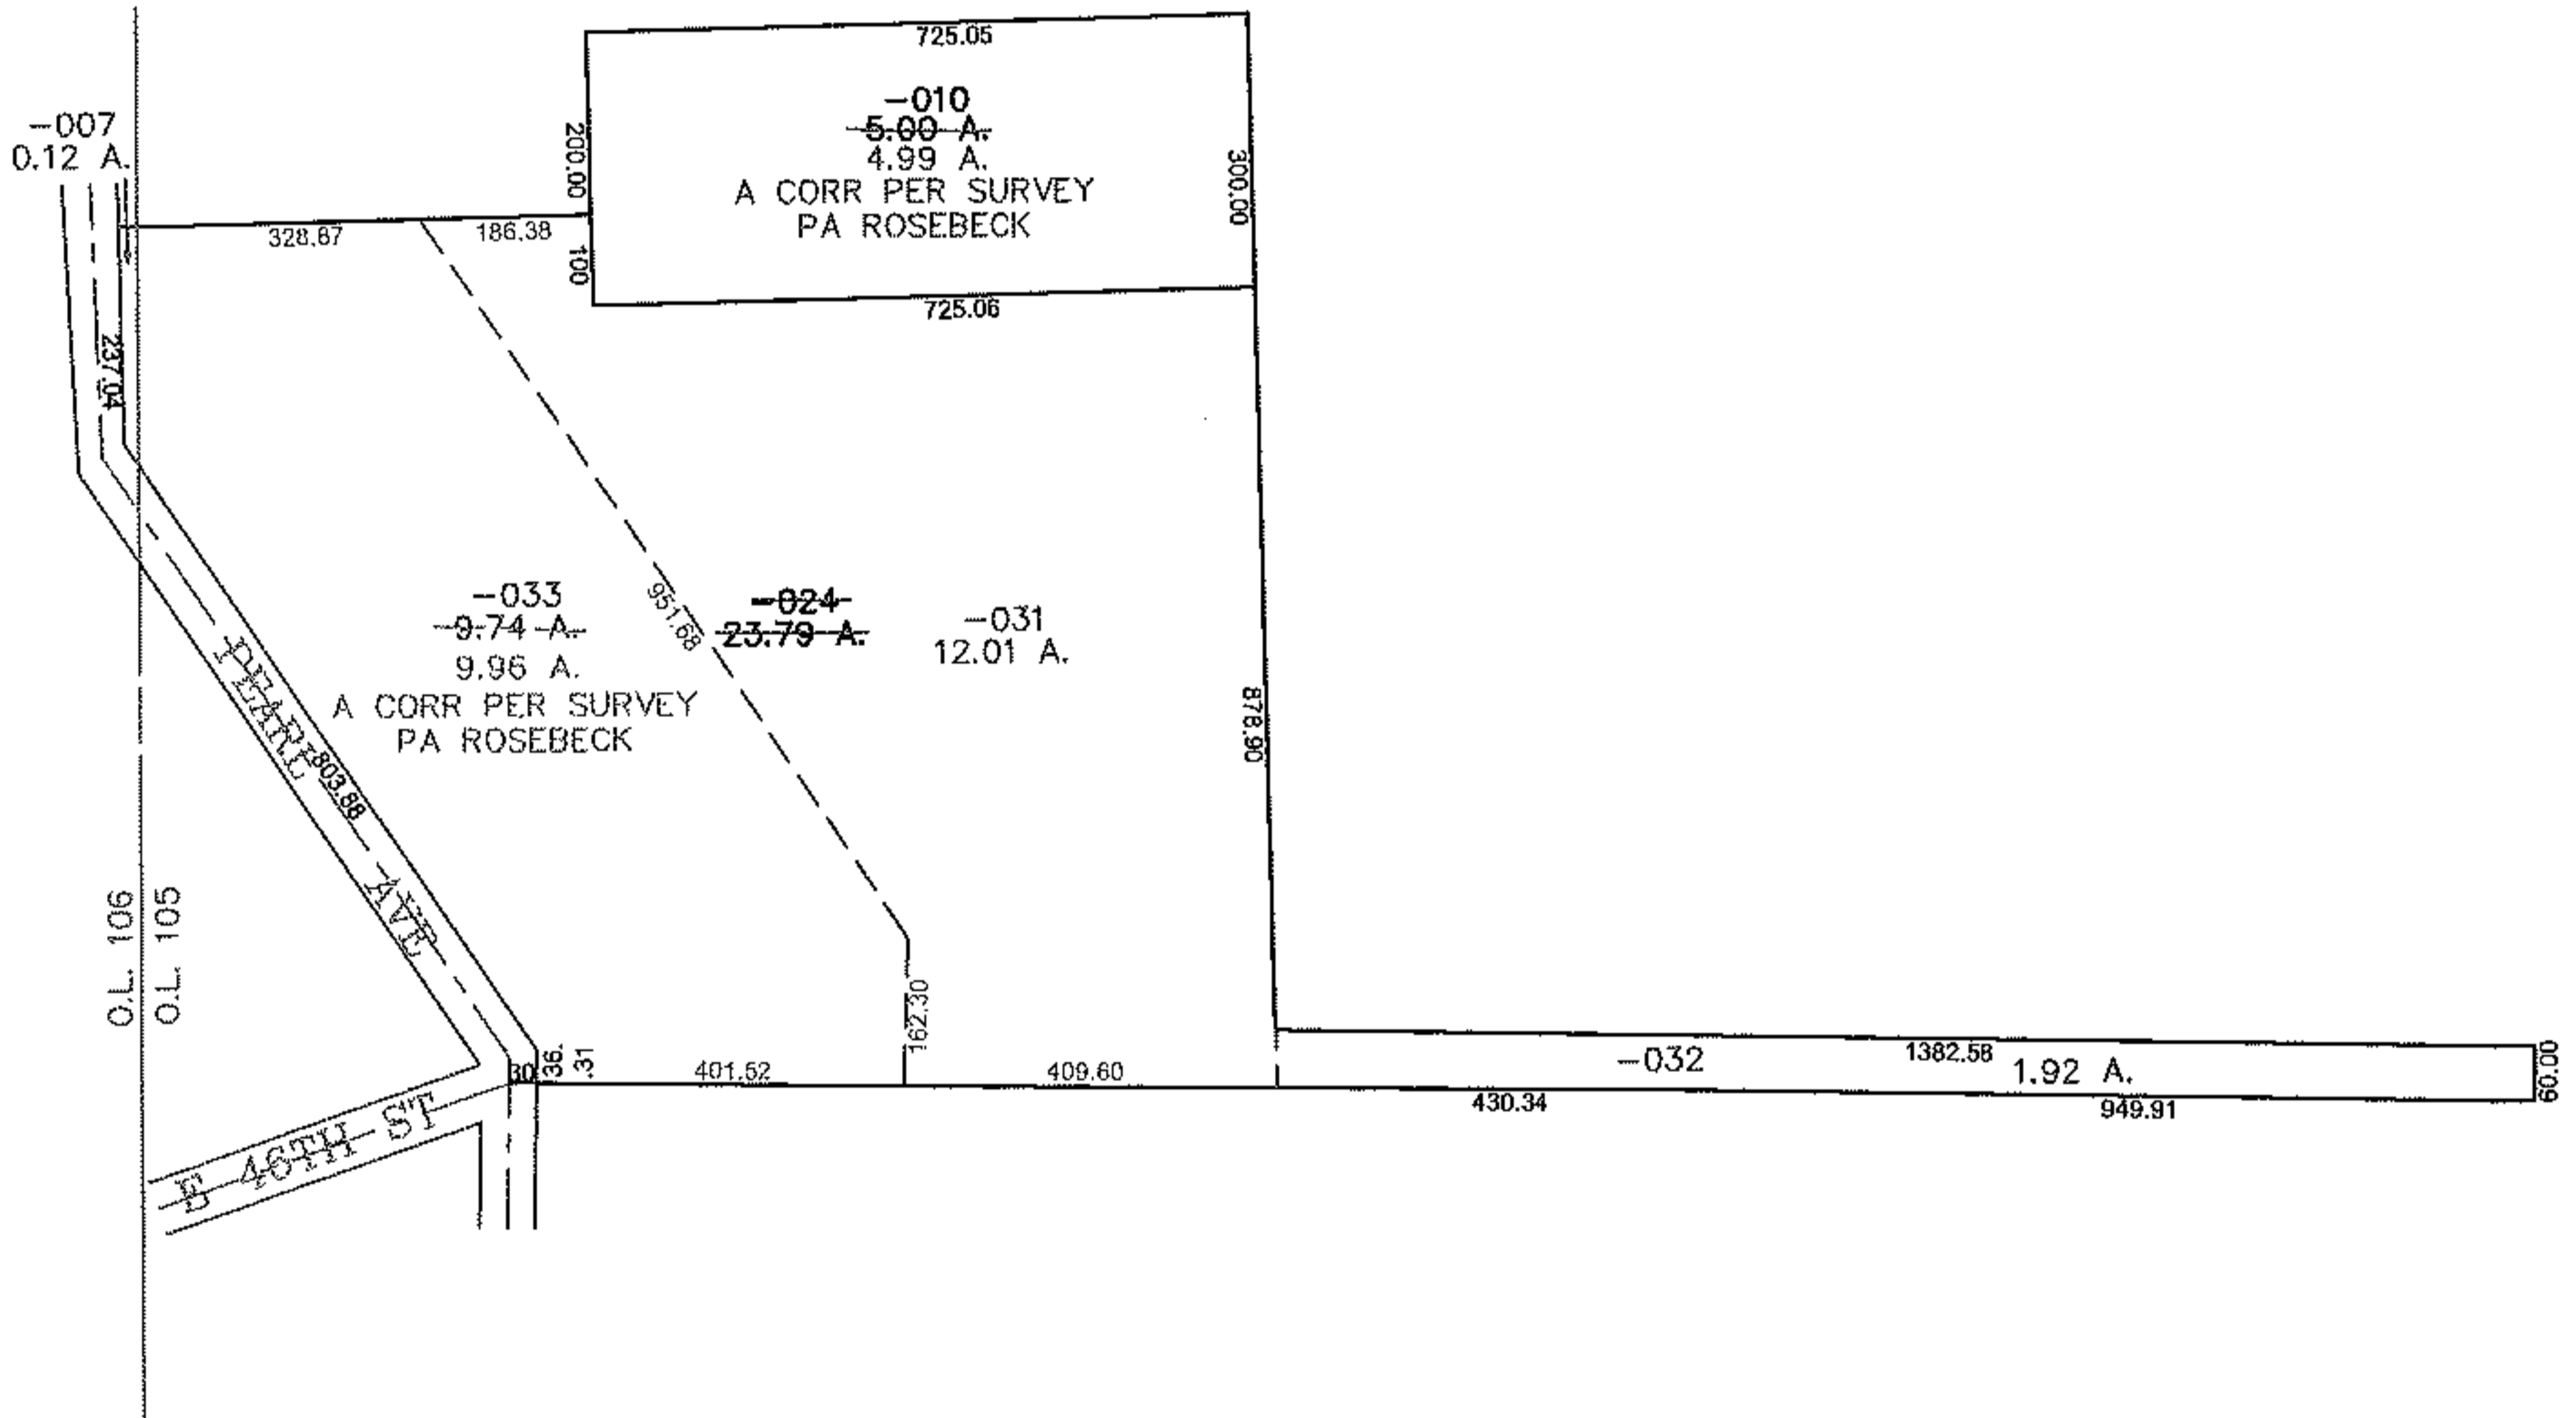


PARENT PARCEL: 03-00-105-101-024, -010

CHILD PARCEL: 03-00-105-101-031 THRU -033

STARTING POINT: CENTERLINE OF PEARL AVE & O.L. 105

11-02978

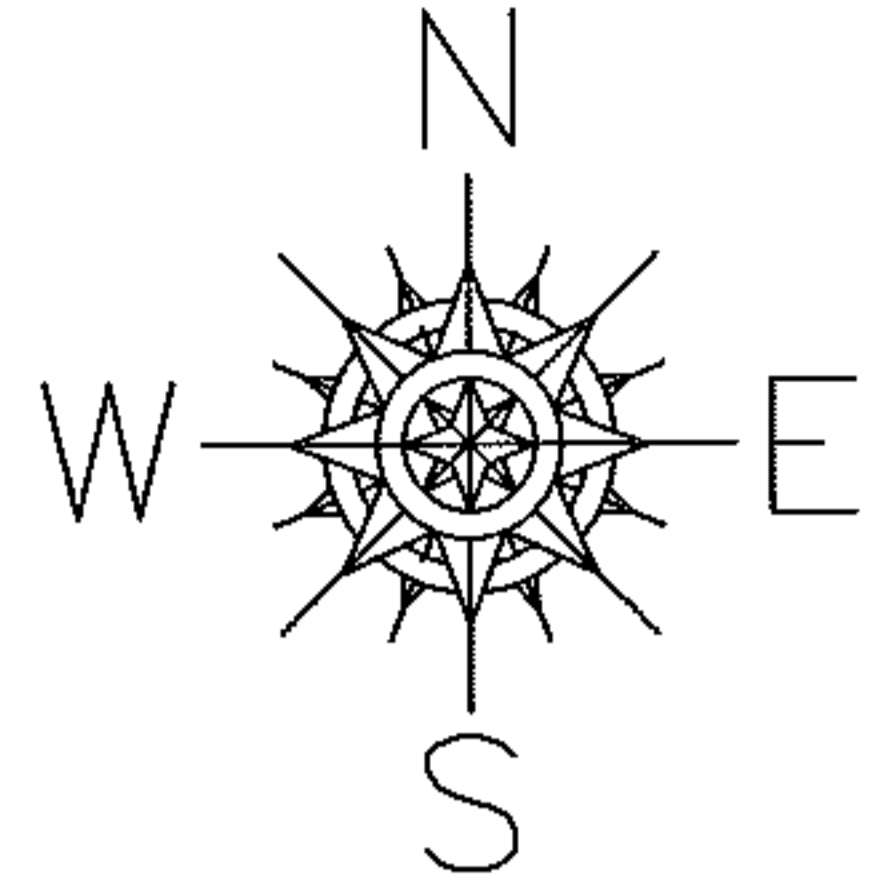

SPLITS/DEEDS PROCESSED

LORAIN COUNTY TAX MAP DEPARTMENT
226 MIDDLE AVE. ELYRIA, OHIO

SURVEYED BY: PA ROSEBECK

CLOSURE: 0.00 : 10,000

MAP PAGE(S): 03-00-105-A, B

APPROVED BY: JAH DATE: 12/20/2011

SCALE: 1" = 400 PRIOR INST.: DV XXXX/XXX