
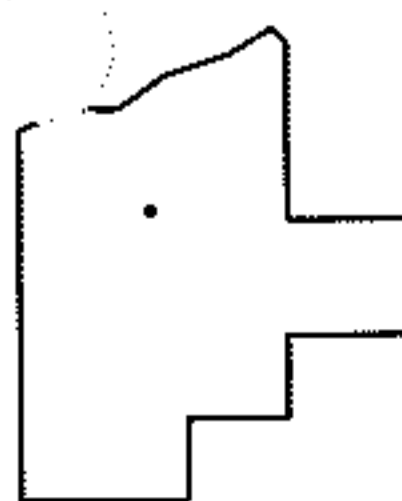
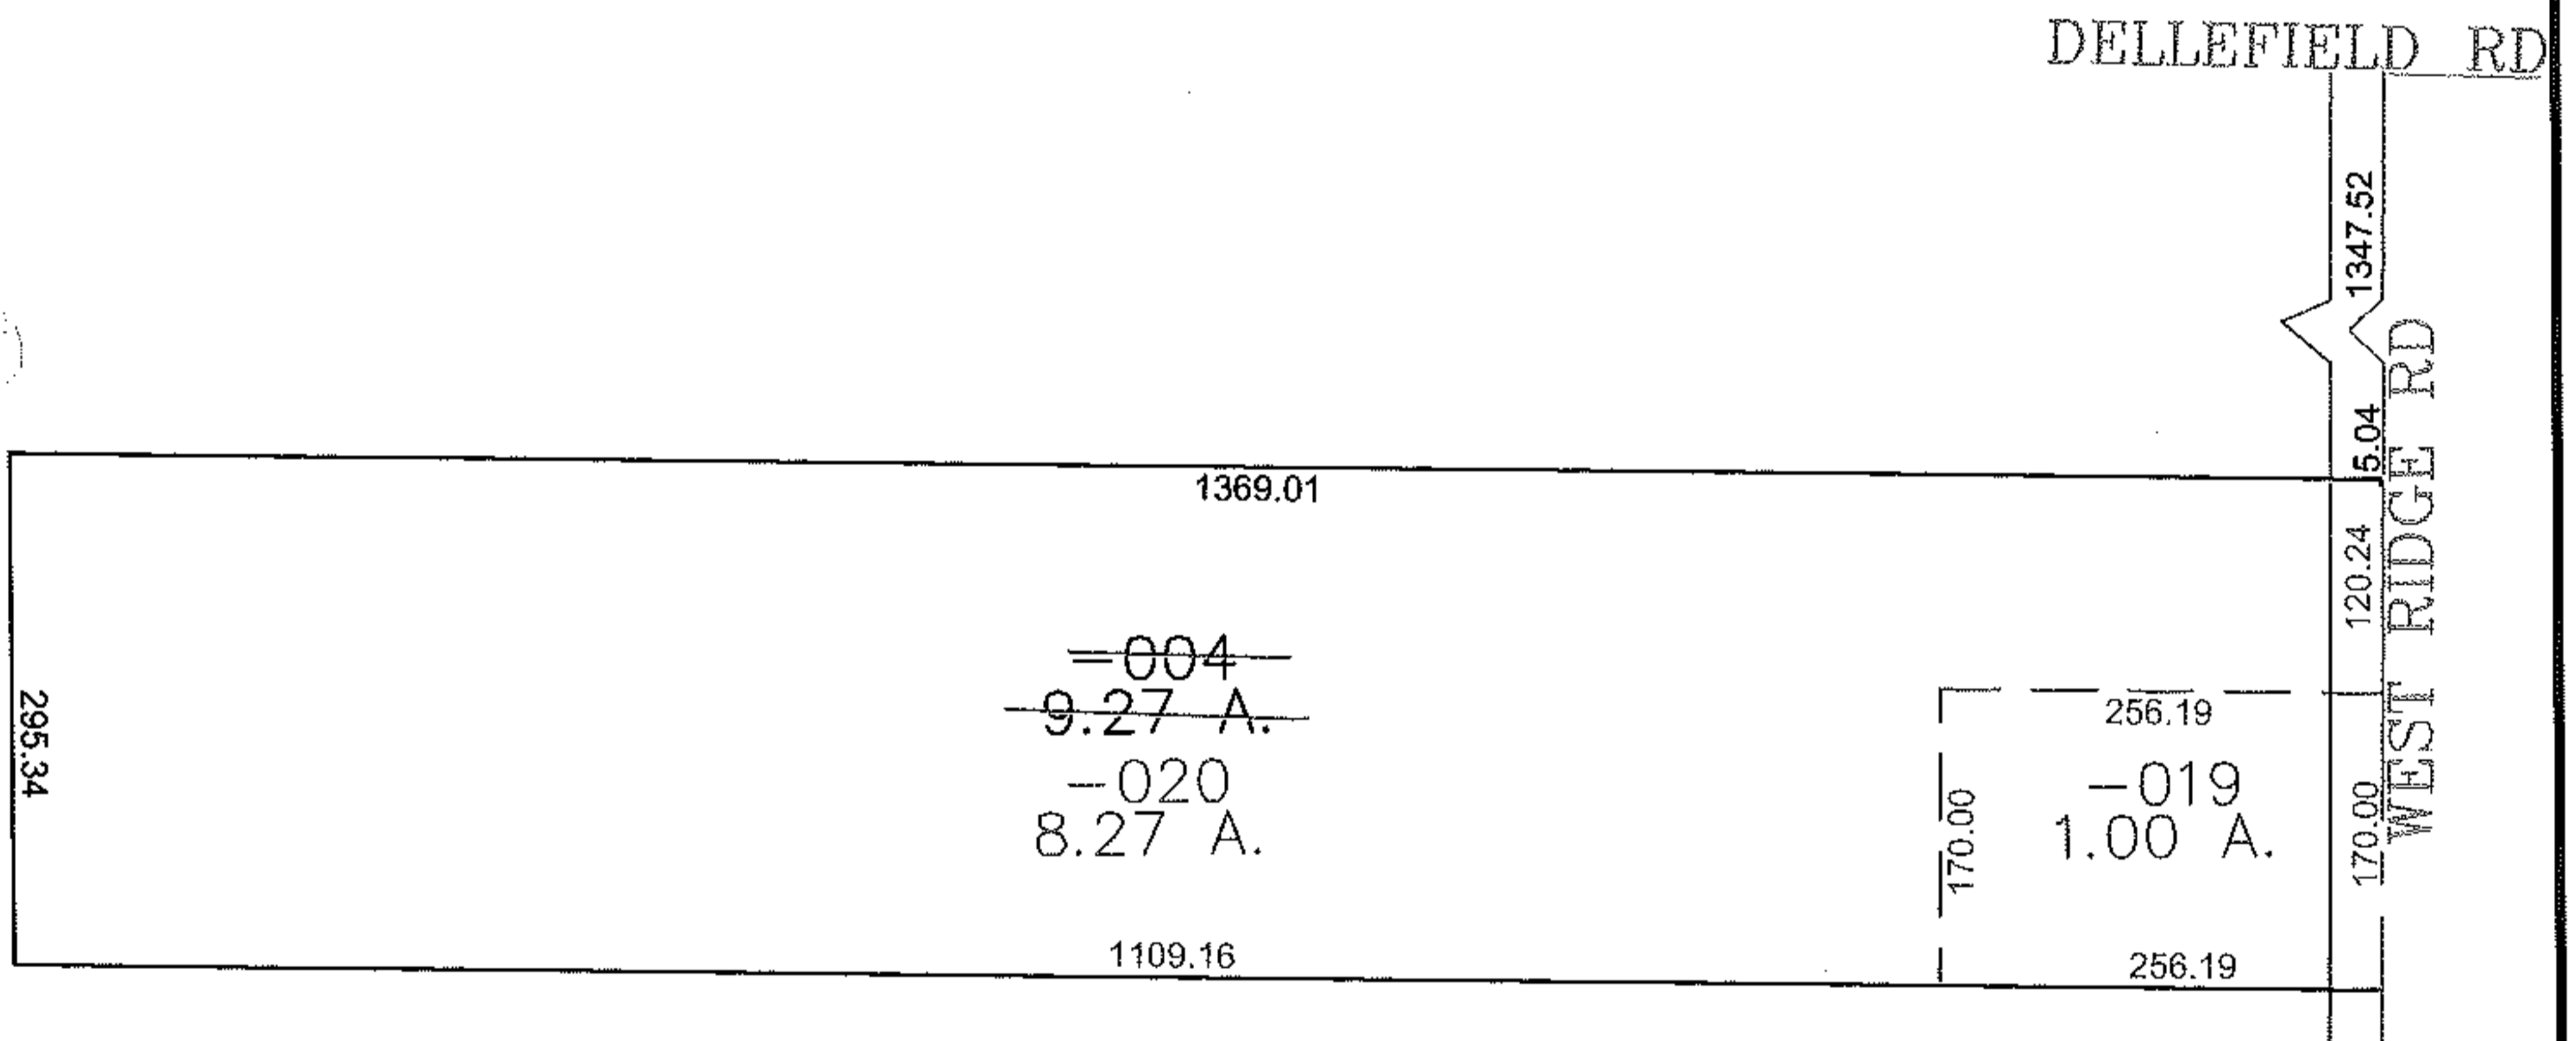


PARENT PARCEL: 05-00-083-000-004

CHILD PARCEL: 05-00-083-000-019, -020

STARTING POINT: CENTERLINE OF WEST RIDGE RD & DELLEFIELD RD

11-02979

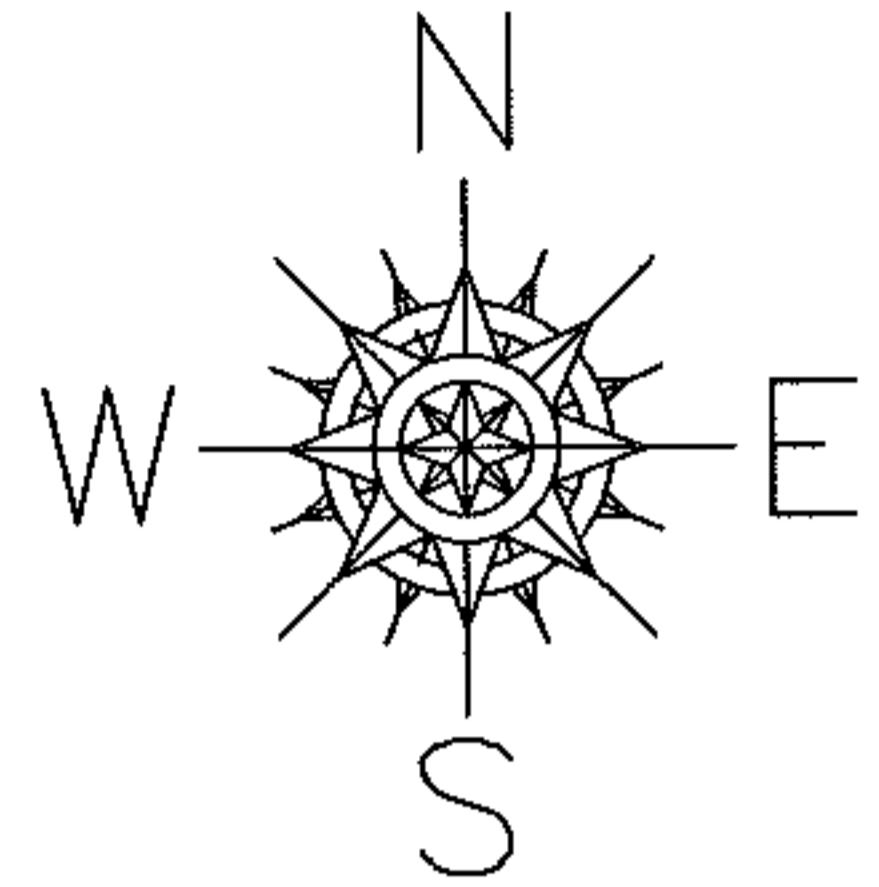

SPLITS/DEEDS PROCESSED
 LORAIN COUNTY TAX MAP DEPARTMENT
 226 MIDDLE AVE. ELYRIA, OHIO

SURVEYED BY: PATRICK MCGANNON
 CLOSURE: 0.00 : 10,000
 MAP PAGE(S): 05-00-083
 APPROVED BY: JAH DATE: 12/19/2011
 SCALE: 1" = 200 PRIOR INSTRUMENT: 20100345497