
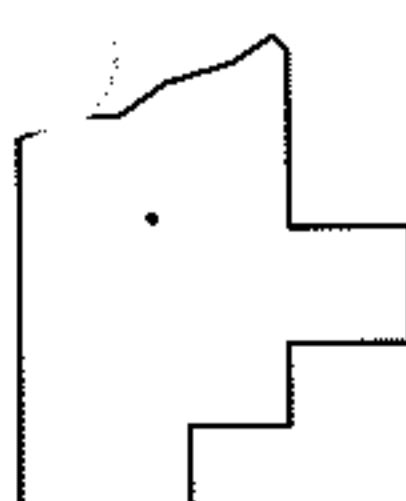
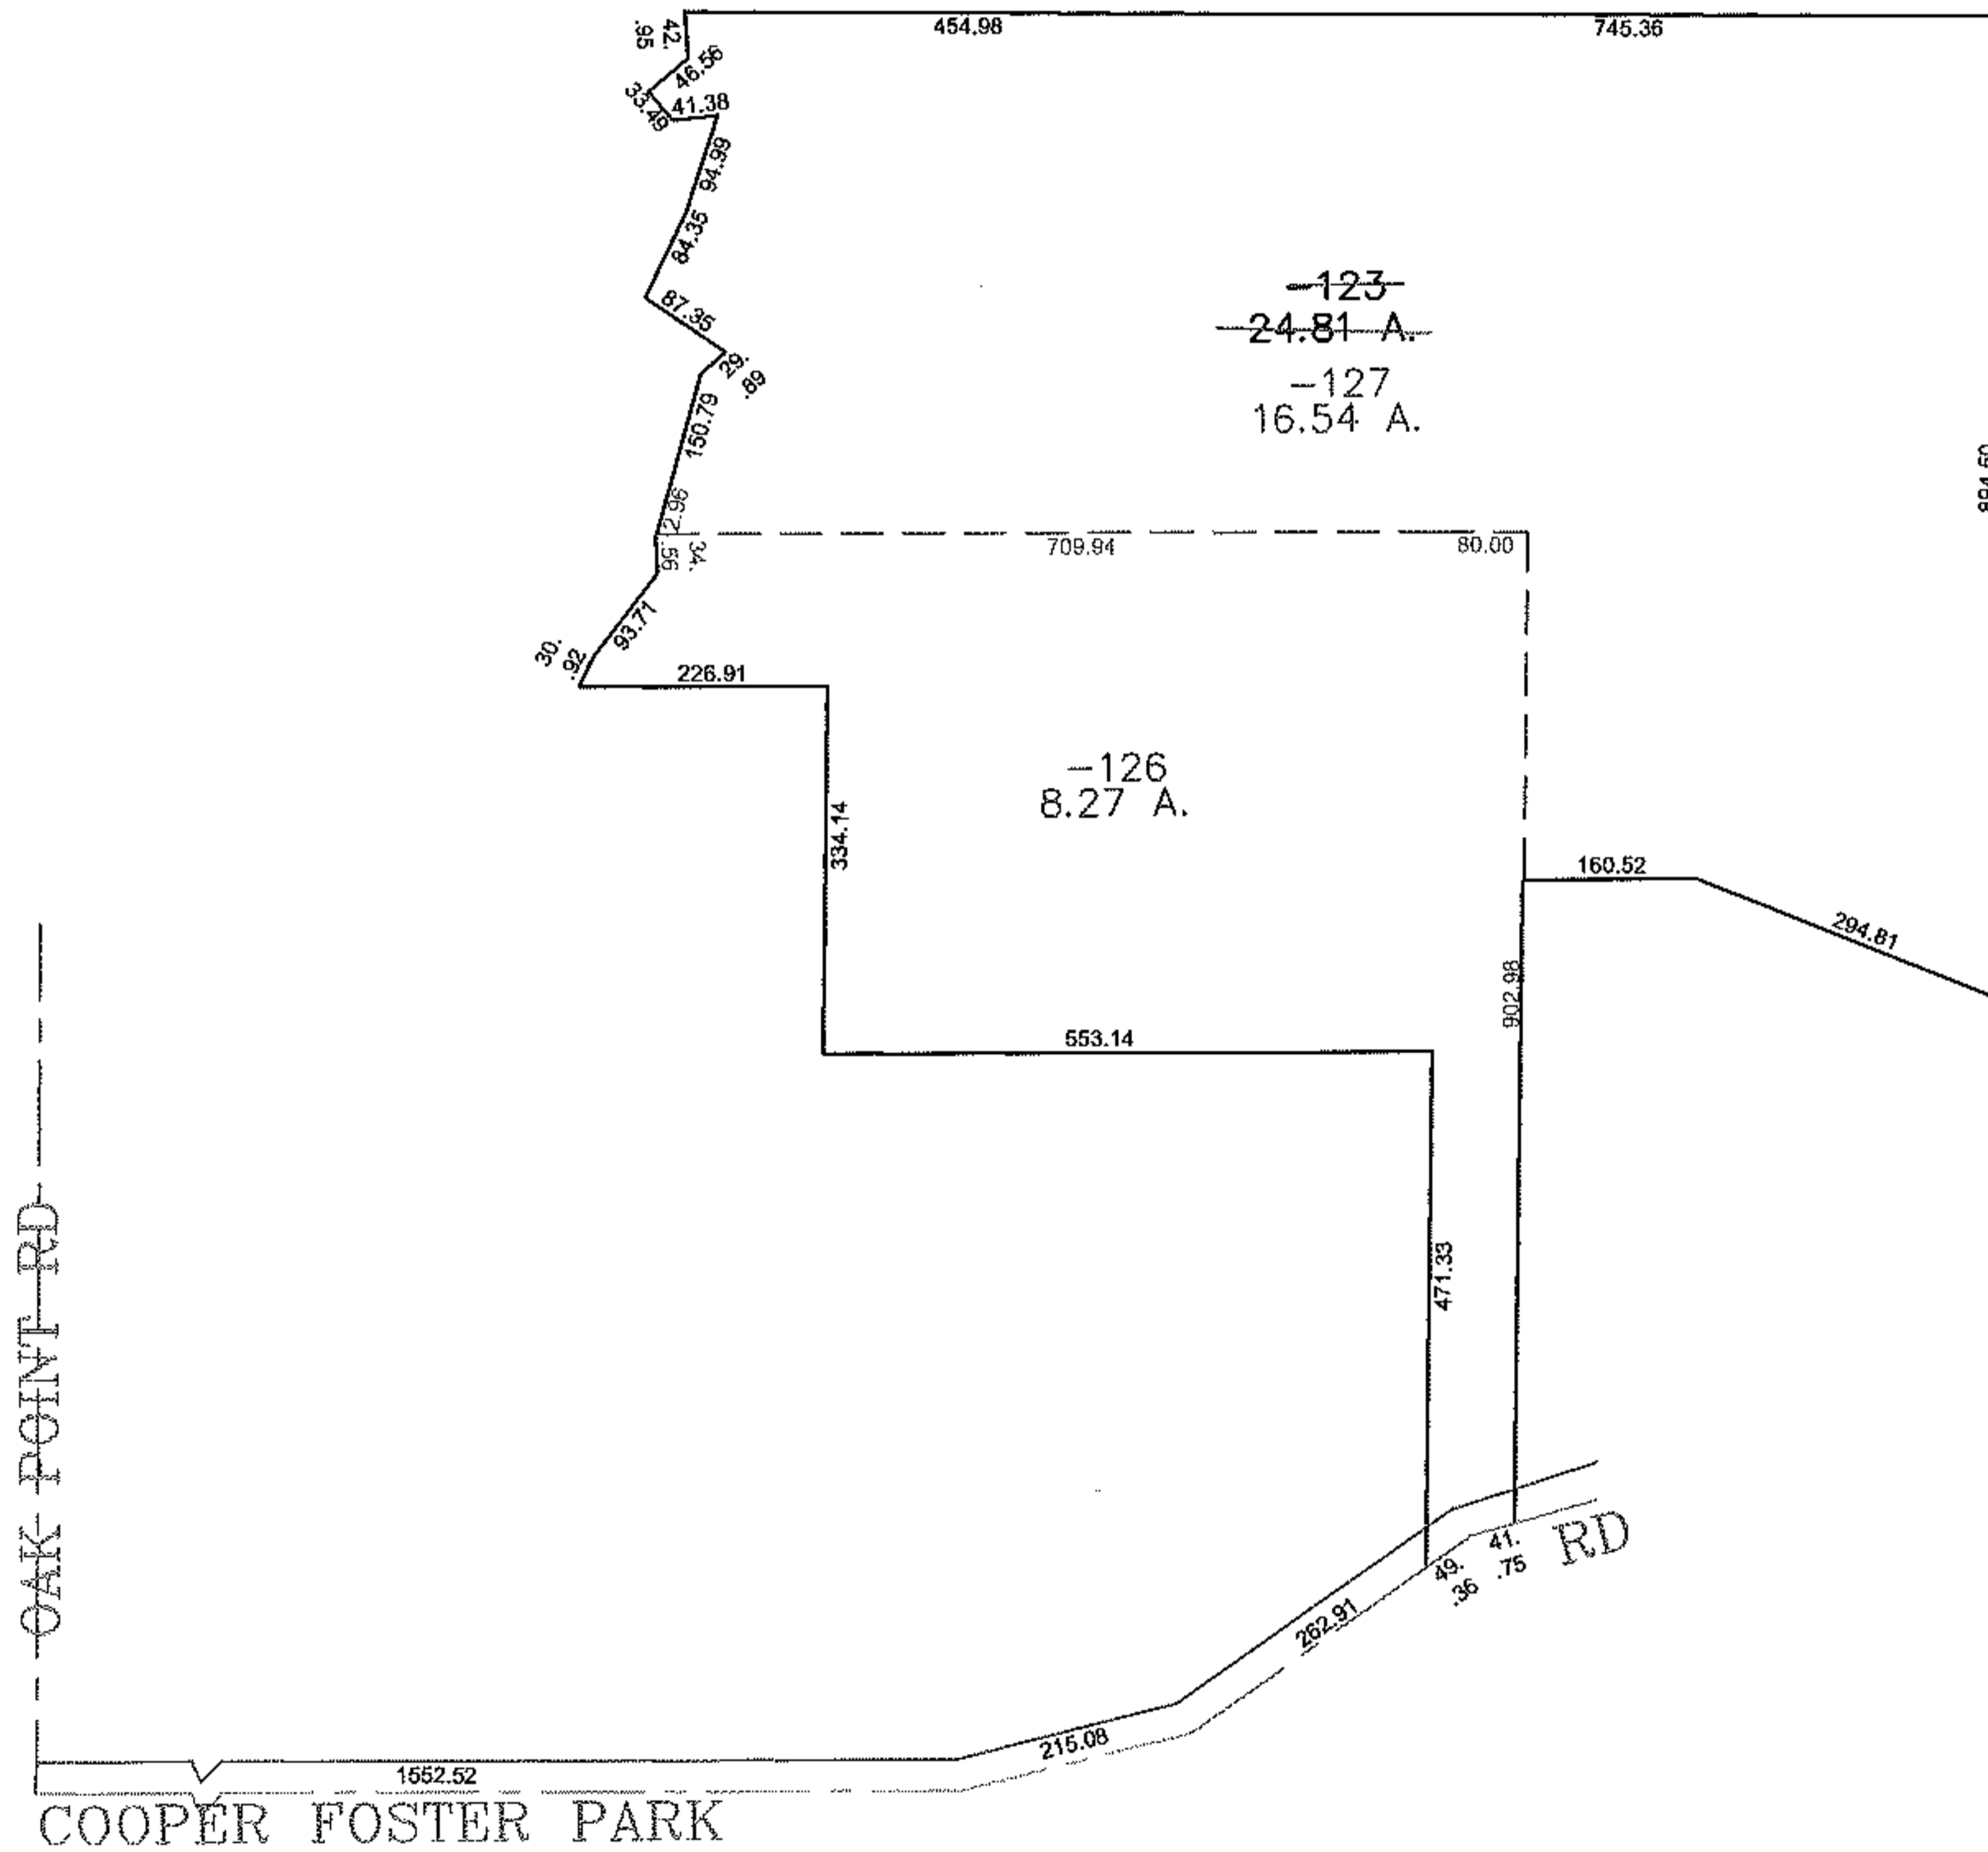


PARENT PARCEL: 05-00-020-000-123

CHILD PARCEL: 05-00-020-000-126, -127

11-02980

STARTING POINT: CENTERLINE OF OAK POINT RD & COOPER FOSTER PARK RD

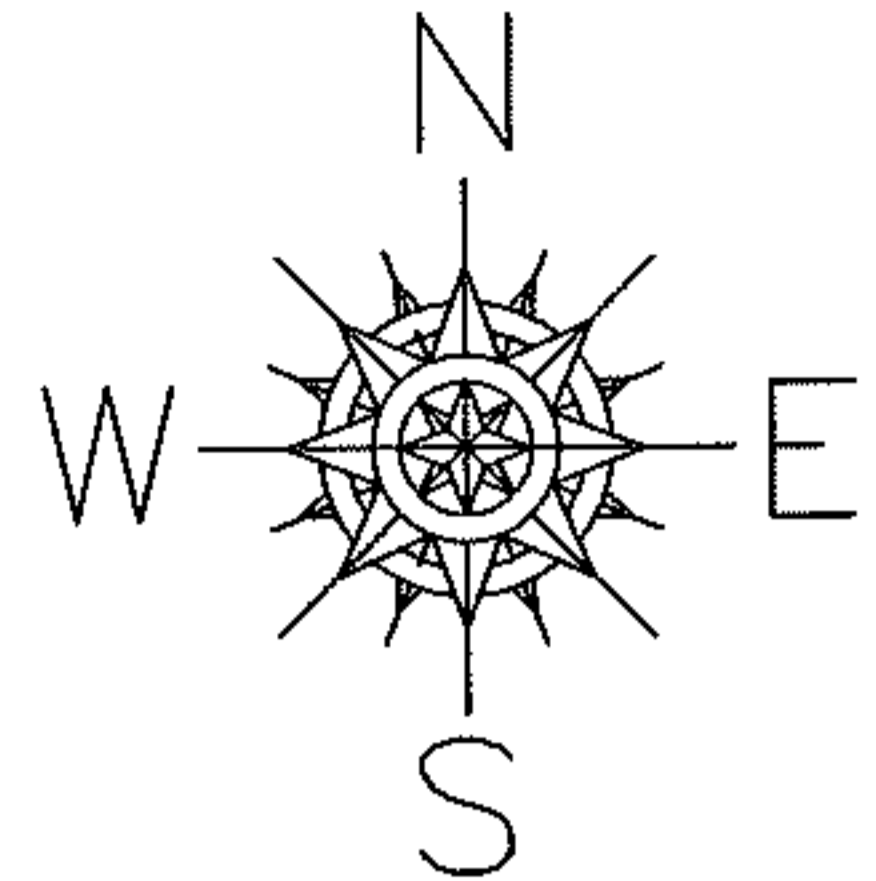

SPLITS/DEEDS PROCESSED
 LORAIN COUNTY TAX MAP DEPARTMENT
 226 MIDDLE AVE. ELYRIA, OHIO

SURVEYED BY: PHILLIP ROSEBECK
 CLOSURE: 0.00 : 10.000
 MAP PAGE(S): 05-00-020-B
 APPROVED BY: JAH DATE: 12-19-2011
 SCALE: 1" = 300 PRIOR INSTRUMENT: 20060148849