
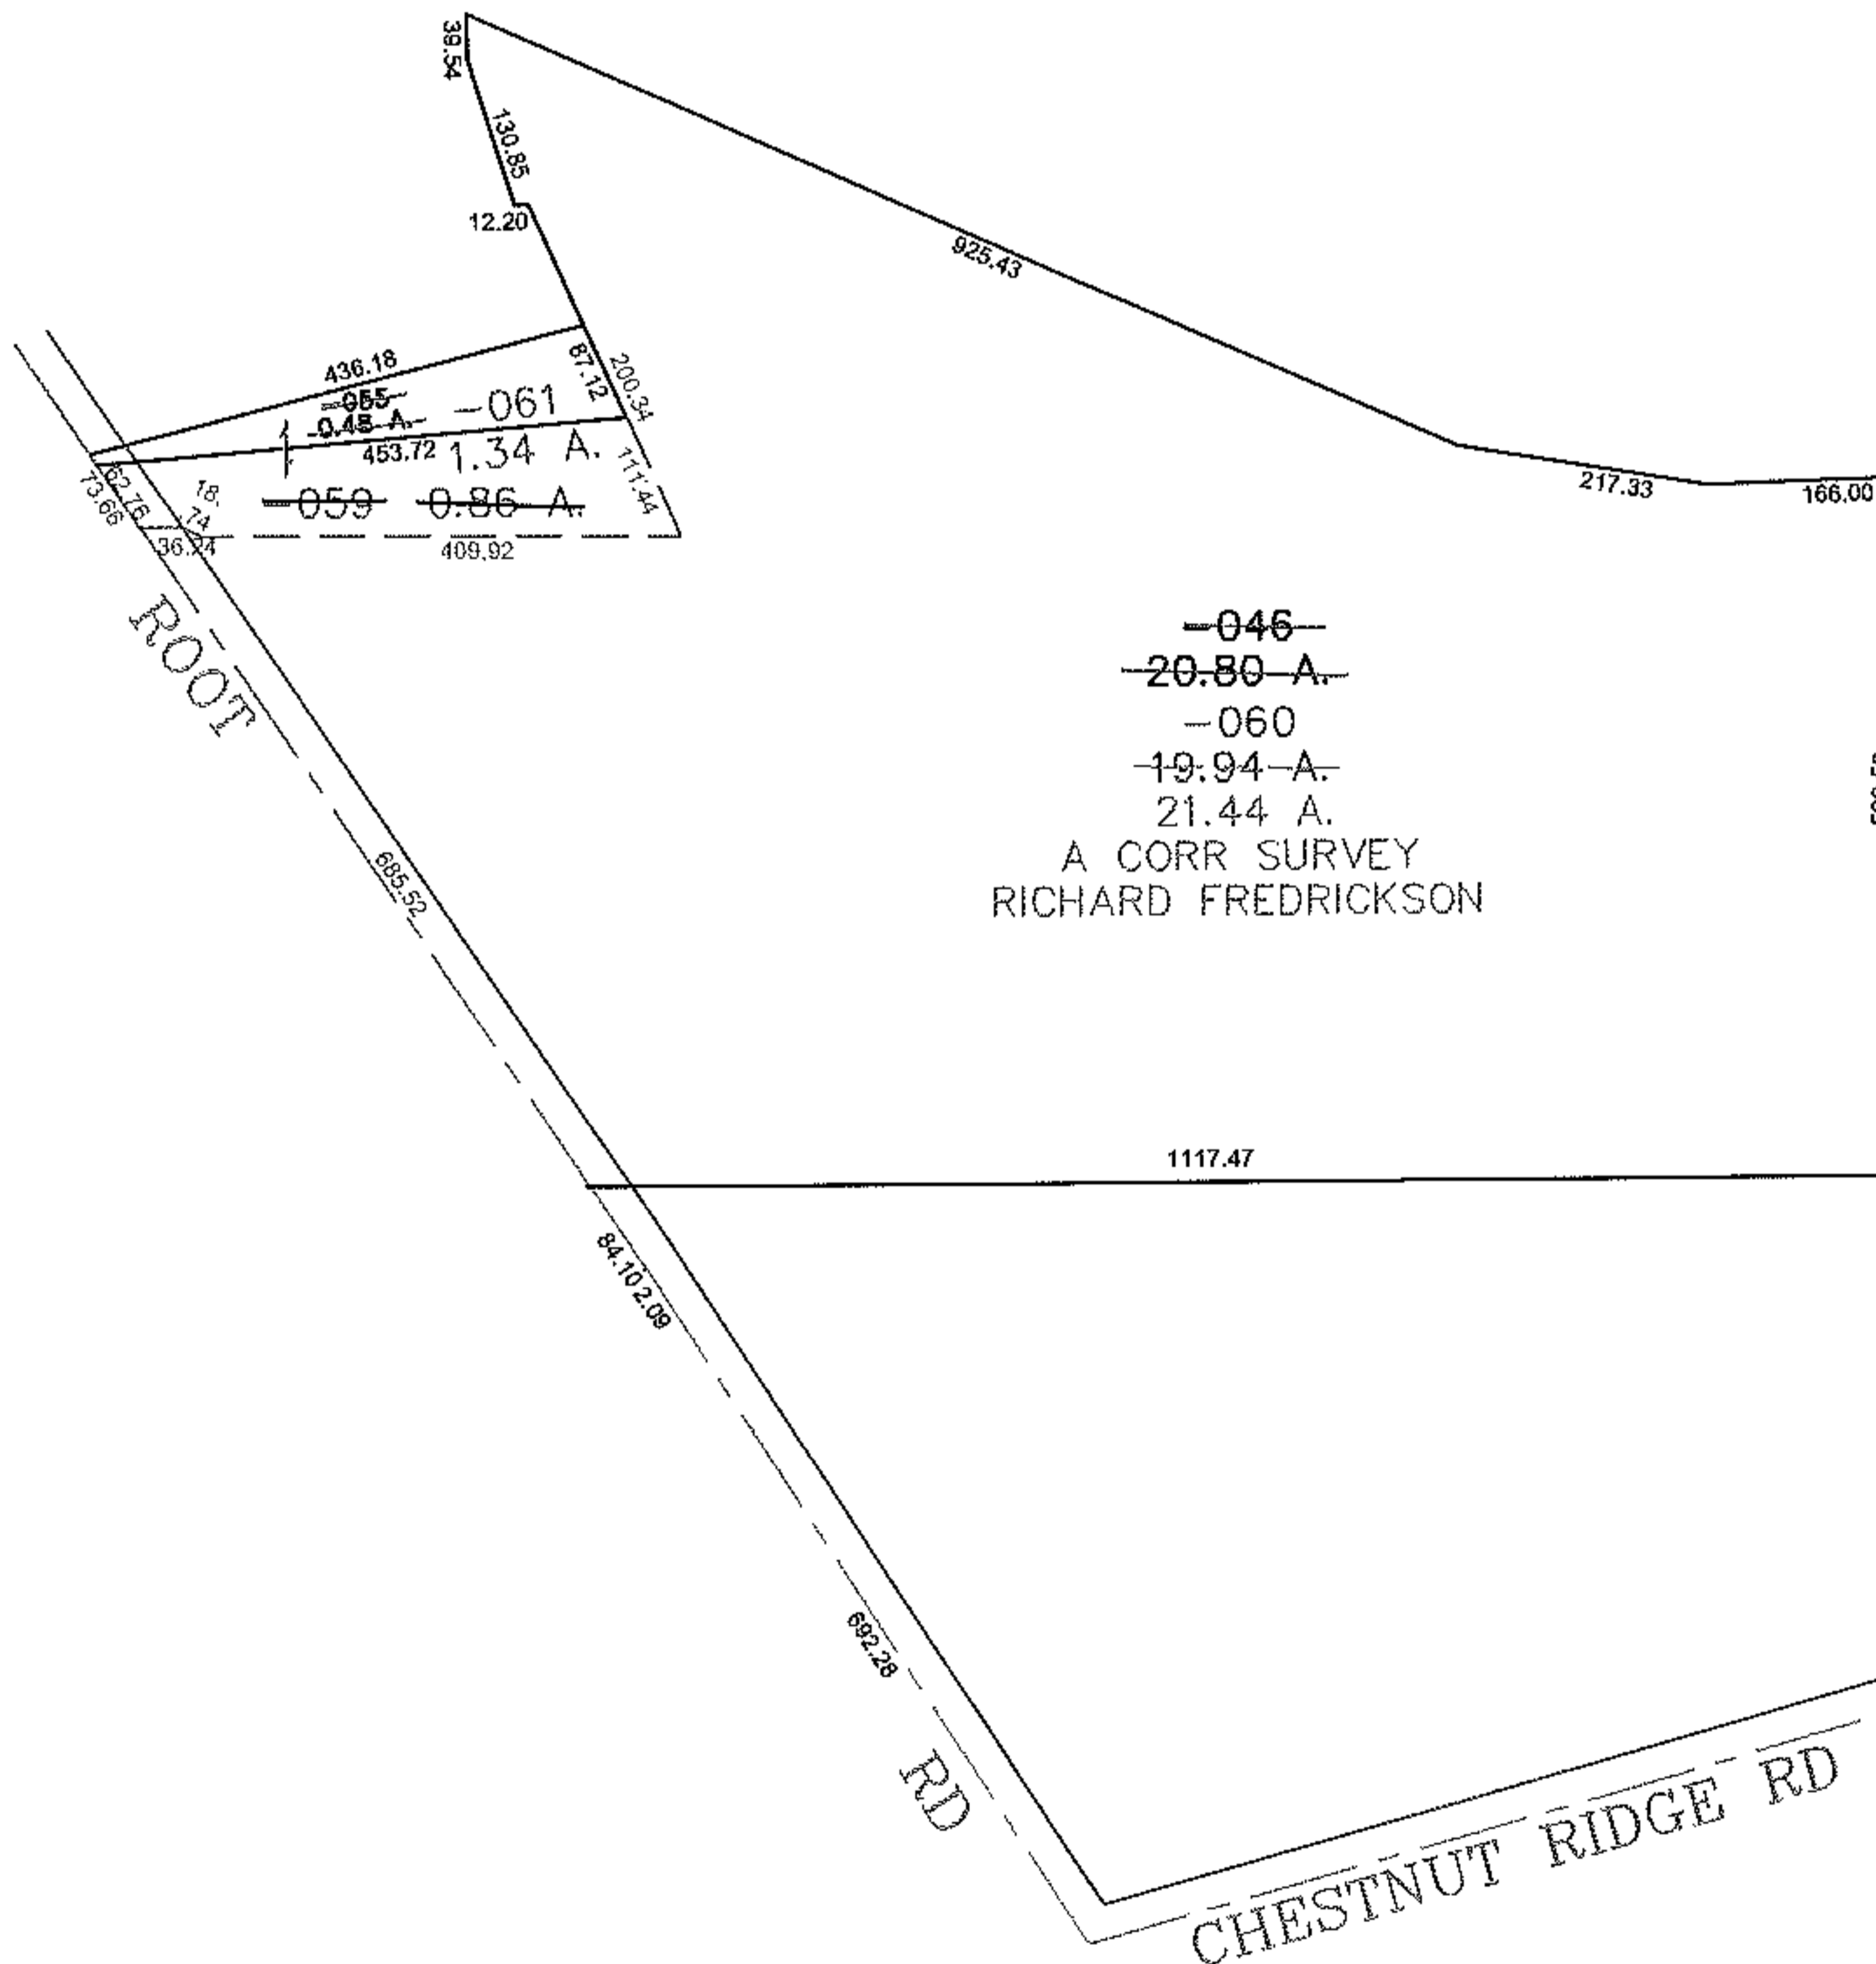


PARENT PARCEL: 07-00-015-110-046, -055


CHILD PARCEL: 07-00-015-110-059 THRU -061

STARTING POINT: CENTERLINE OF ROOT RD & CHESTNUT RIDGE RD

11-02981

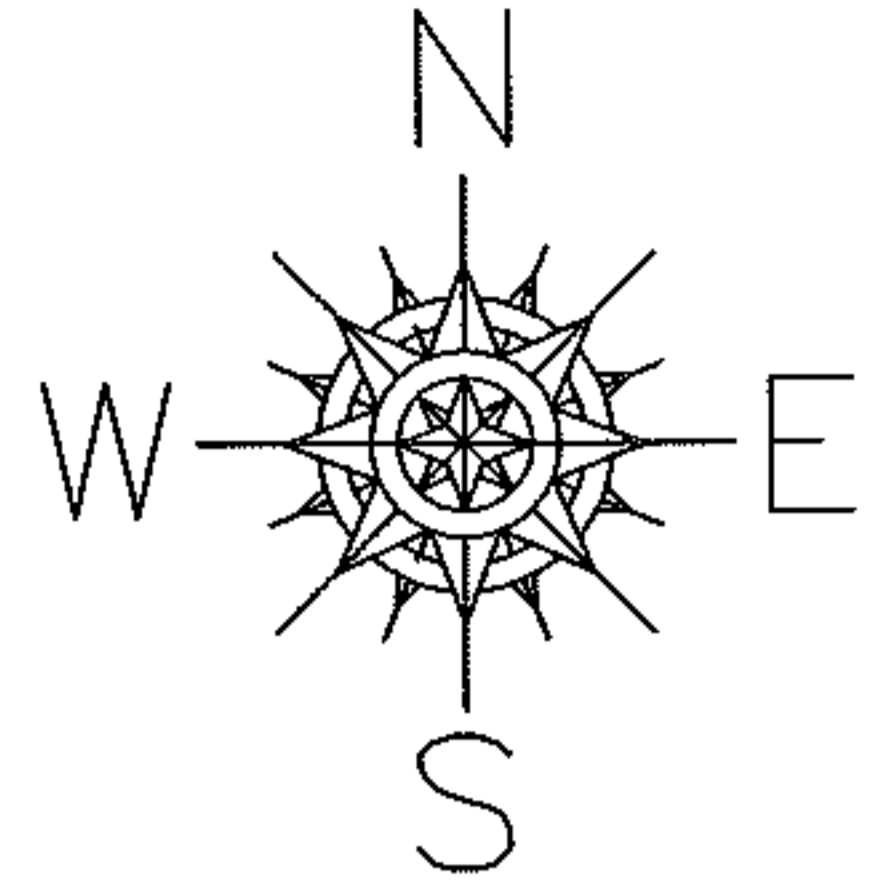

~~-046-~~
~~20.80 A.~~
~~-060-~~
~~19.94 A.~~
~~0.86 A.~~
 21.44 A.
 A CORR SURVEY
 RICHARD FREDRICKSON

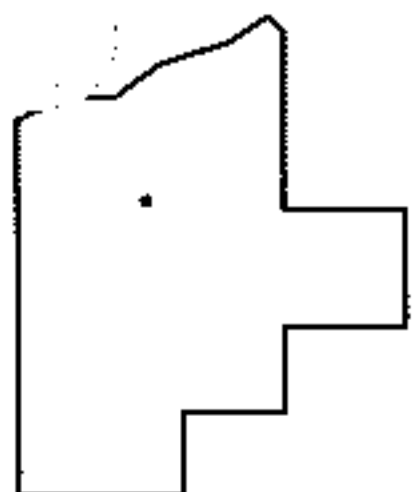

SPLITS/DEEDS PROCESSED
 LORAIN COUNTY TAX MAP DEPARTMENT
 226 MIDDLE AVE. ELYRIA, OHIO

SURVEYED BY: RICHARD FREDRICKSON
 CLOSURE: 0.00 : 10,000
 MAP PAGE(S): 07-00-015-C
 APPROVED BY: JAH DATE: 12/20/2011
 SCALE: 1" = 300 PRIOR INSTRUMENT: DV 1248/156