
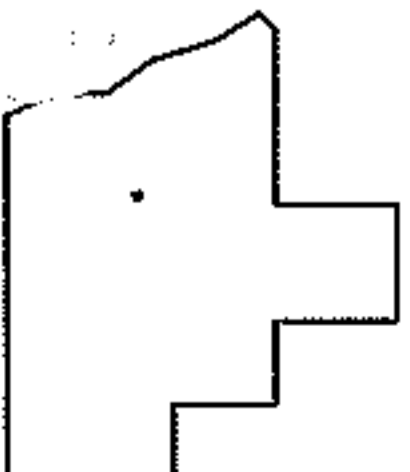
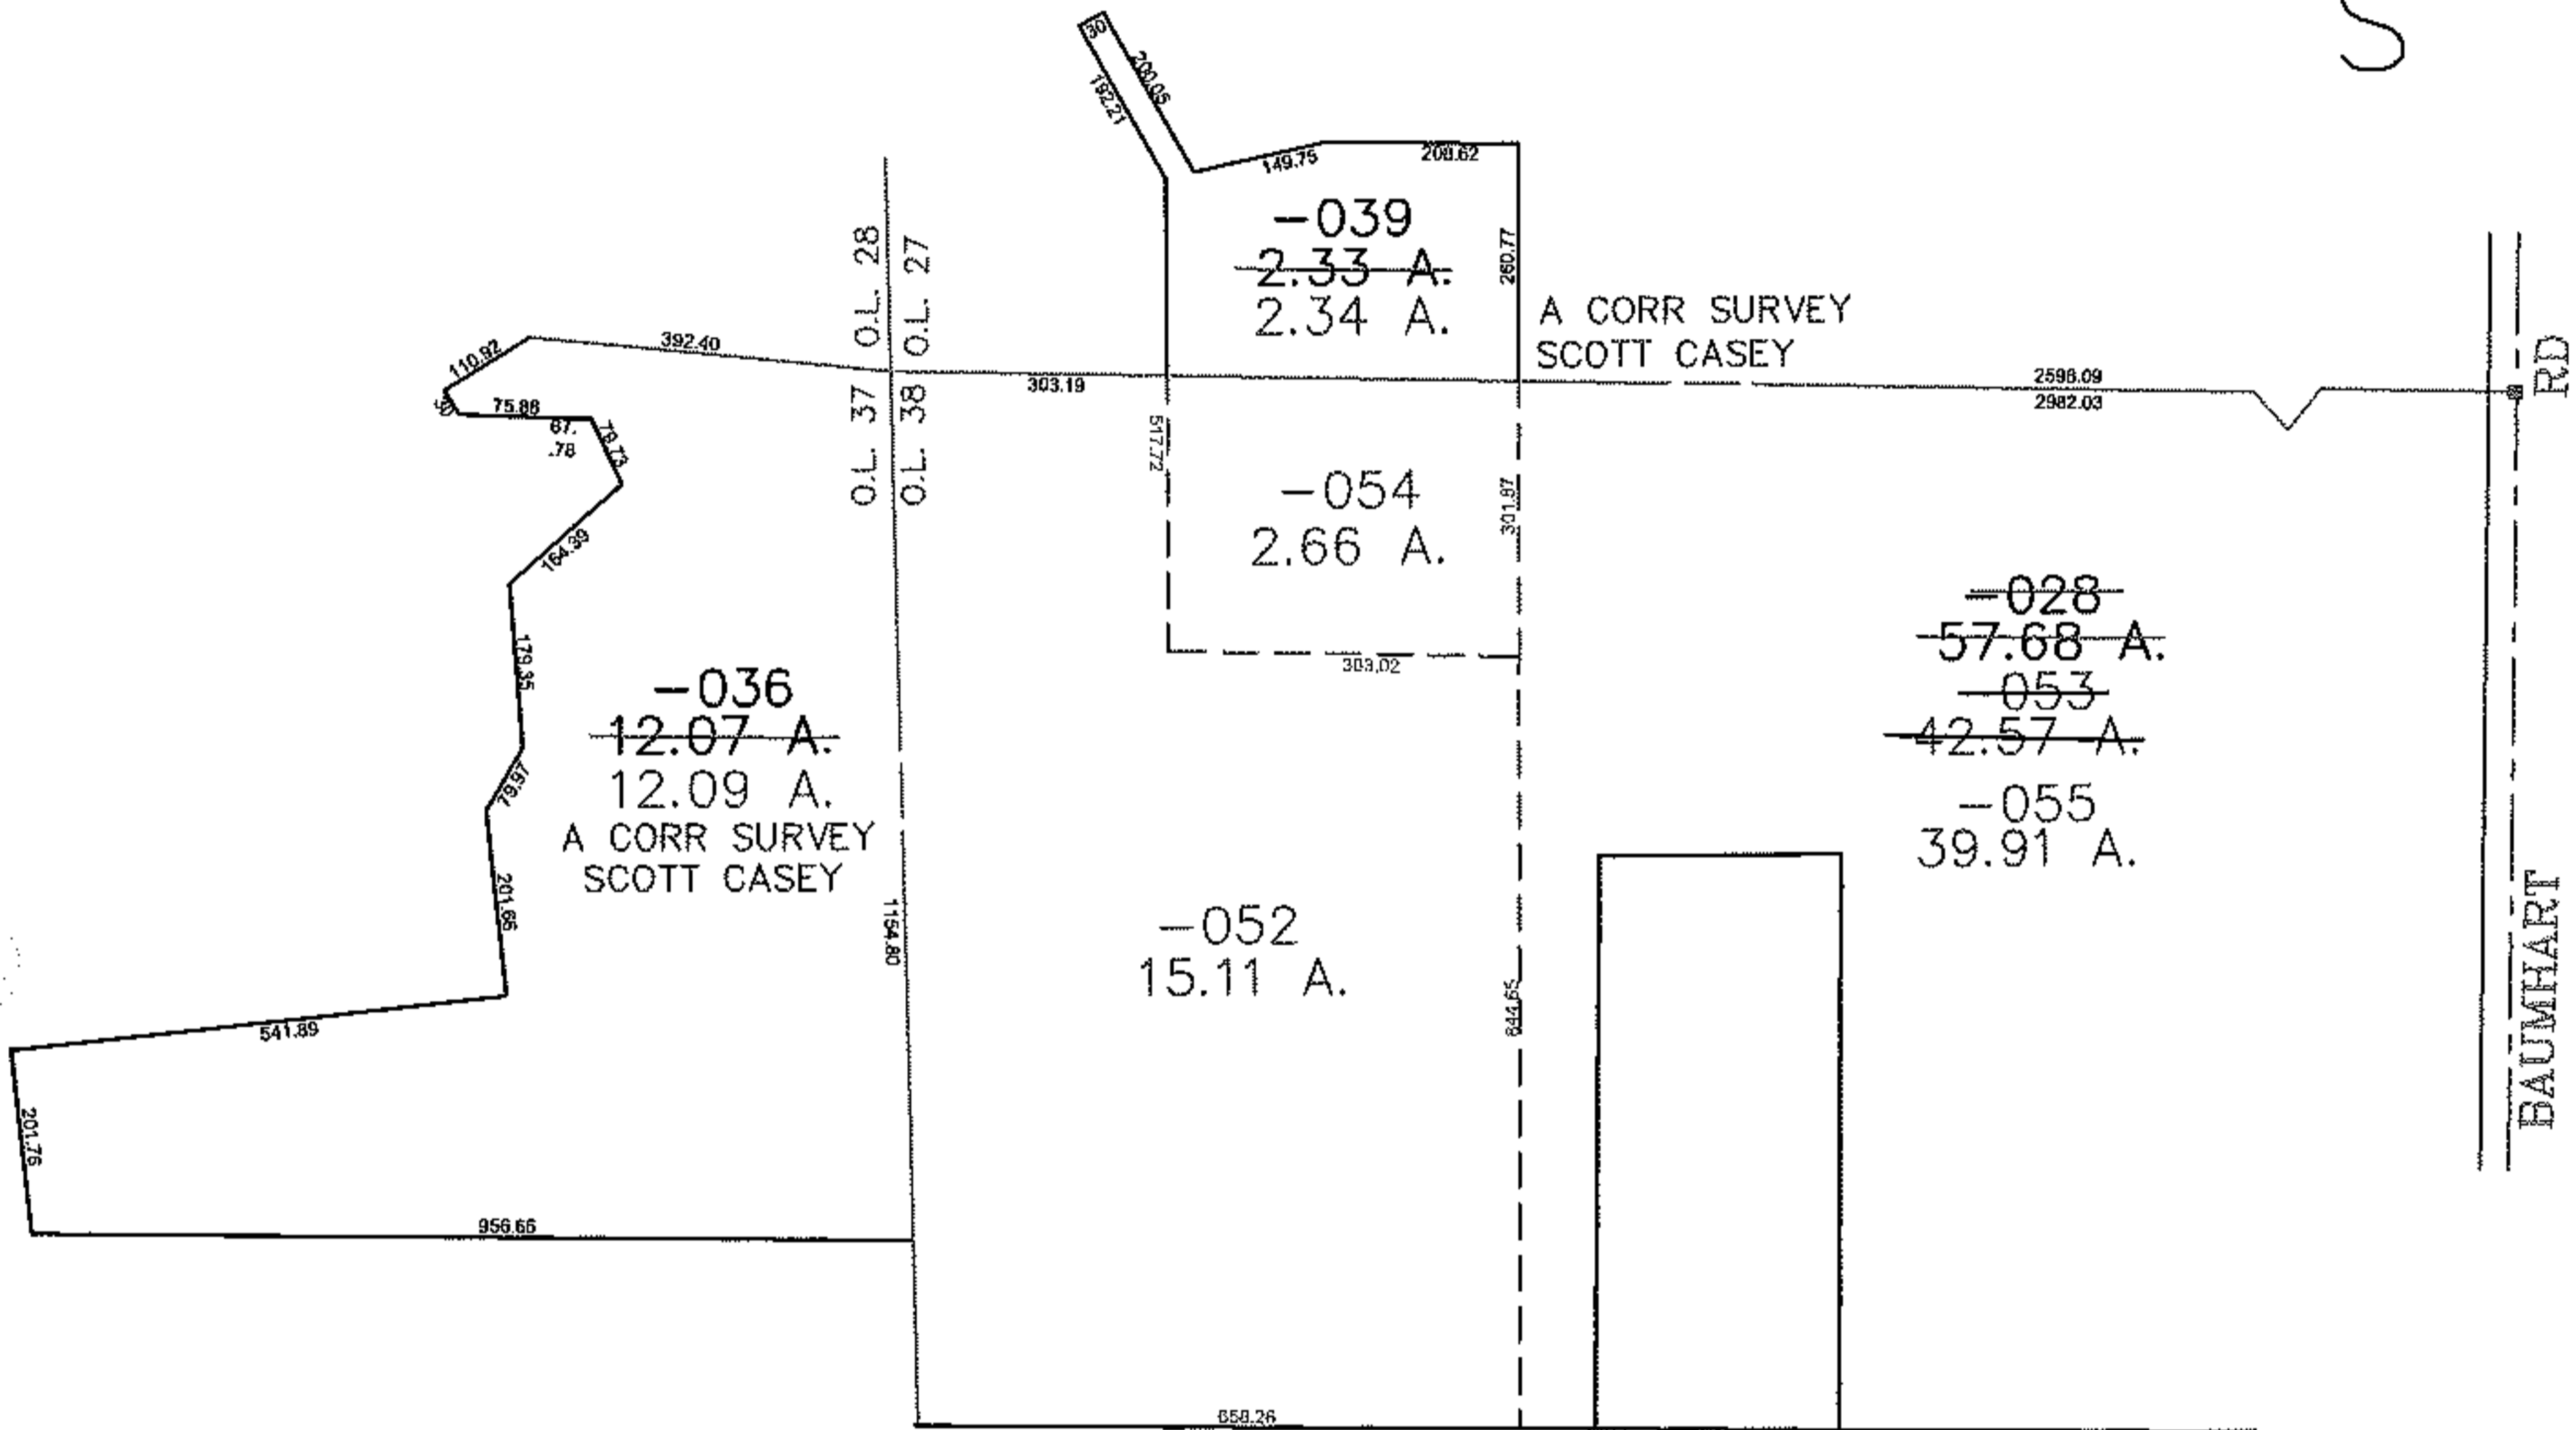


PARENT PARCEL: 01-00-038-000-028, 01-00-037-103-036, 01-00-027-000-039

CHILD PARCEL: 01-00-038-000-052 THRU -055

STARTING POINT: CENTERLINE OF BAUMHART RD & O.L. 37

11-02984

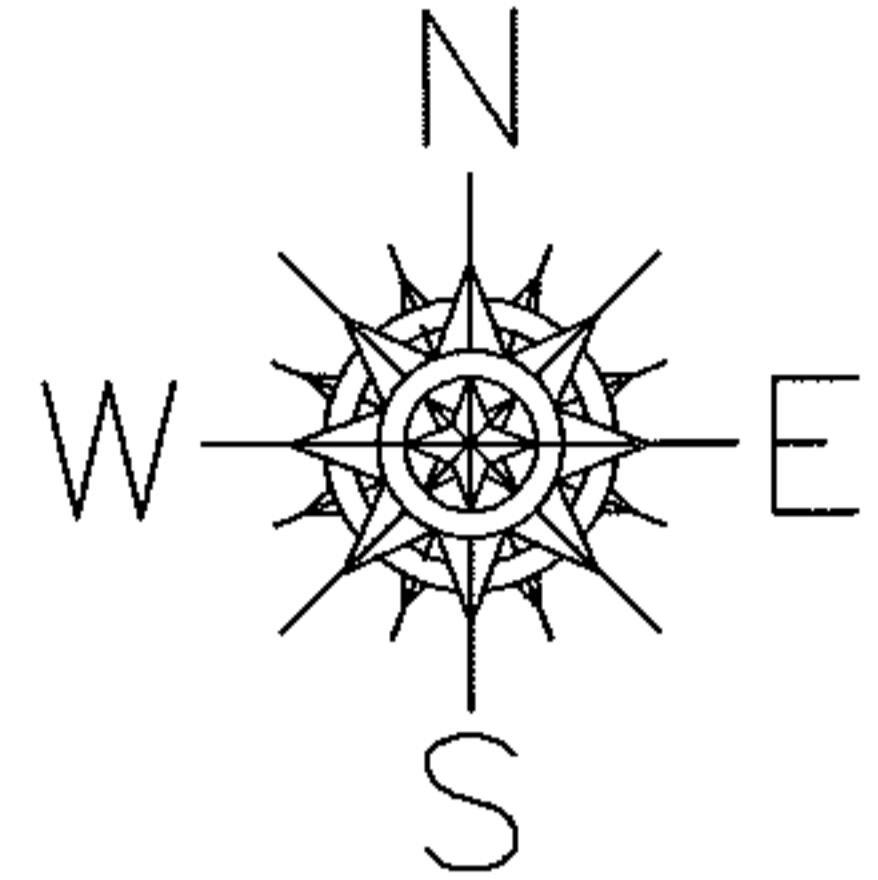

**SPLITS/DEEDS PROCESSED**

LORAIN COUNTY TAX MAP DEPARTMENT  
226 MIDDLE AVE. ELYRIA, OHIO

SURVEYED BY: SCOTT CASEY

CLOSURE: 0.01 : 10,000

MAP PAGE(S): 01-00-027-A

APPROVED BY: JAH DATE: 12/28/2011

SCALE: 1" = 400 PRIOR INST.: 19930256483