
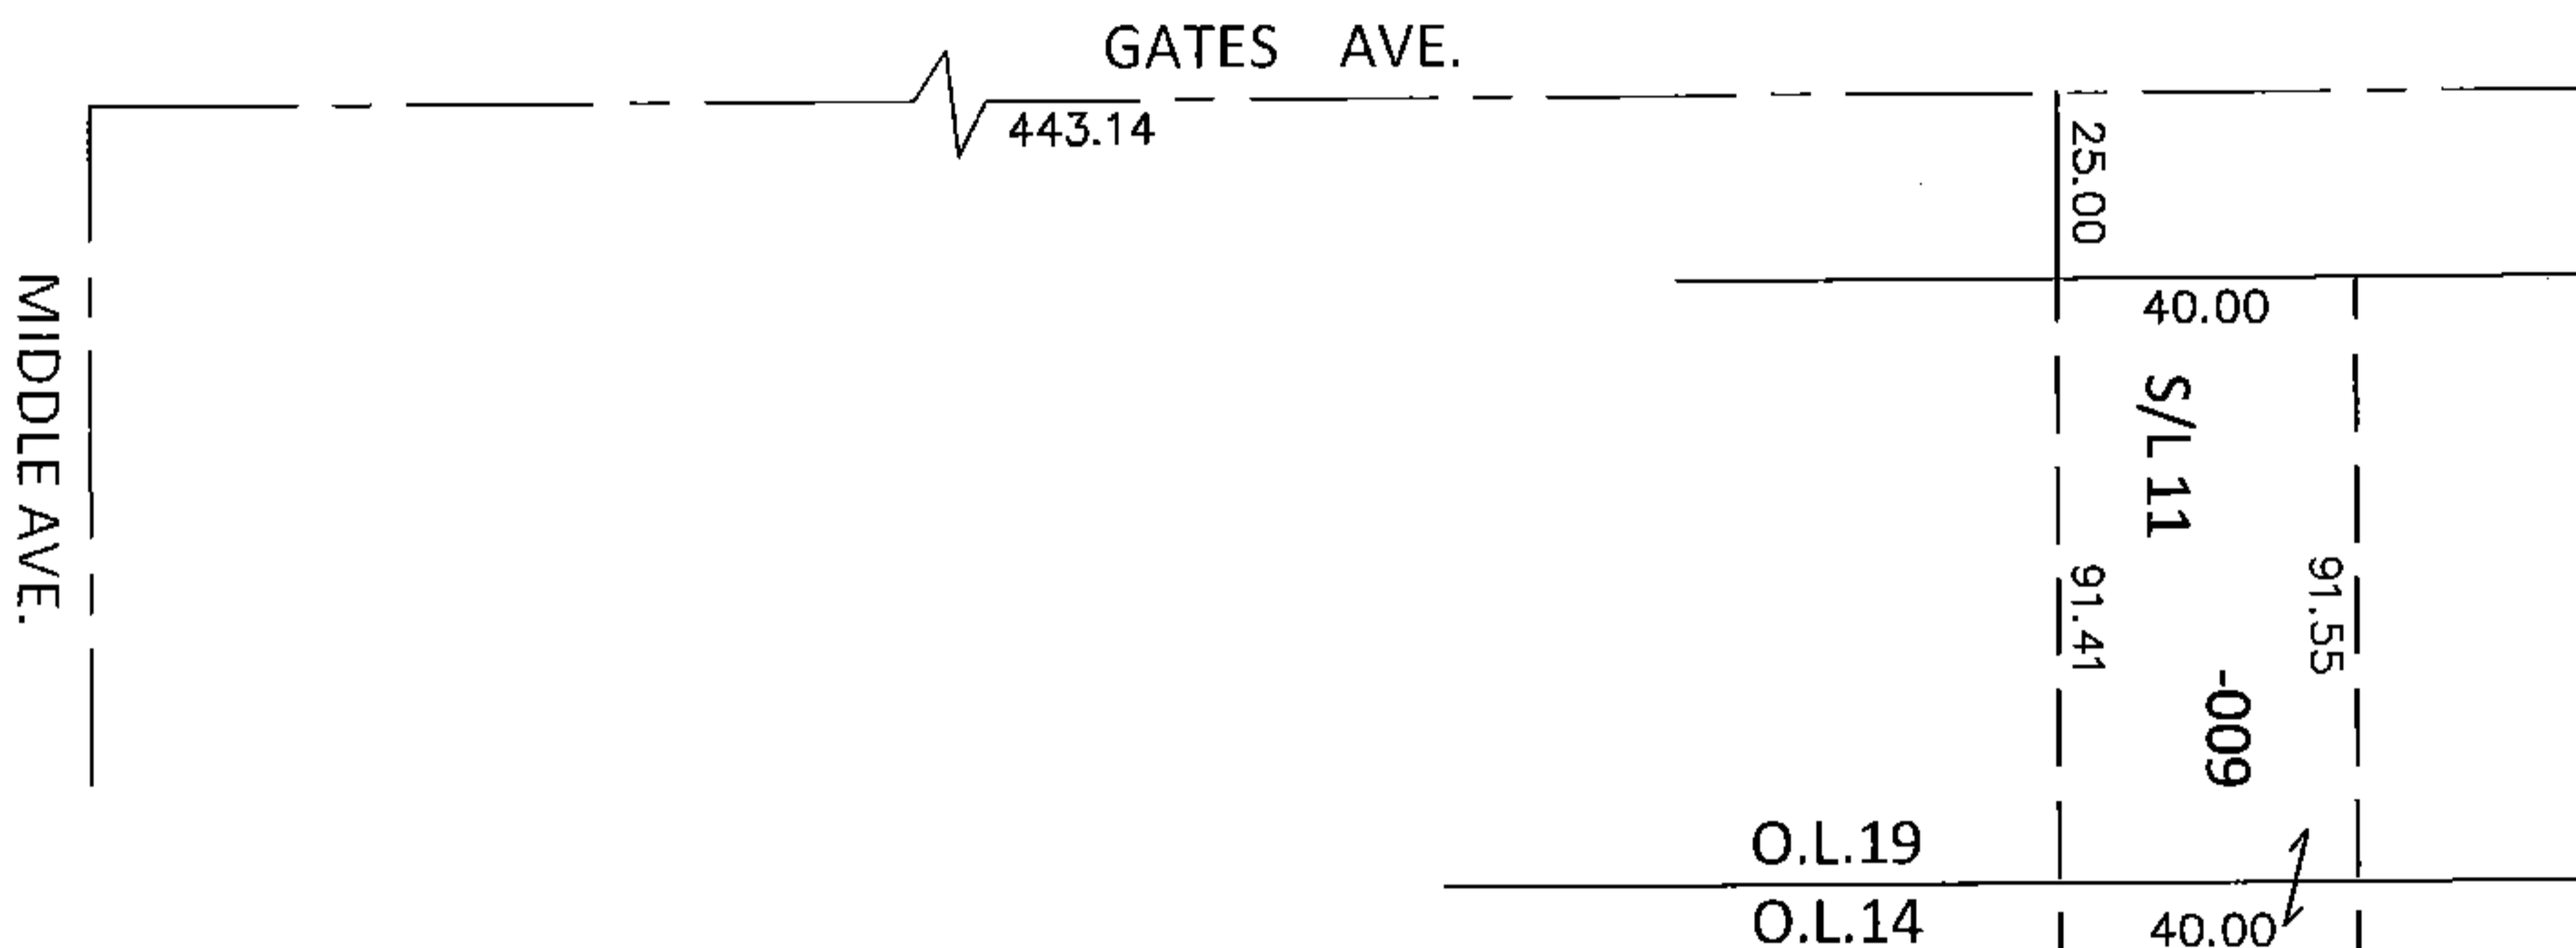


PARENT PARCEL: 06-26-019-102-009

CHILD PARCEL: _____


STARTING POINT: INTERSECTION OF C/L OF GATES AVE. AND C/L OF MIDDLE AVE.

14-02985-A

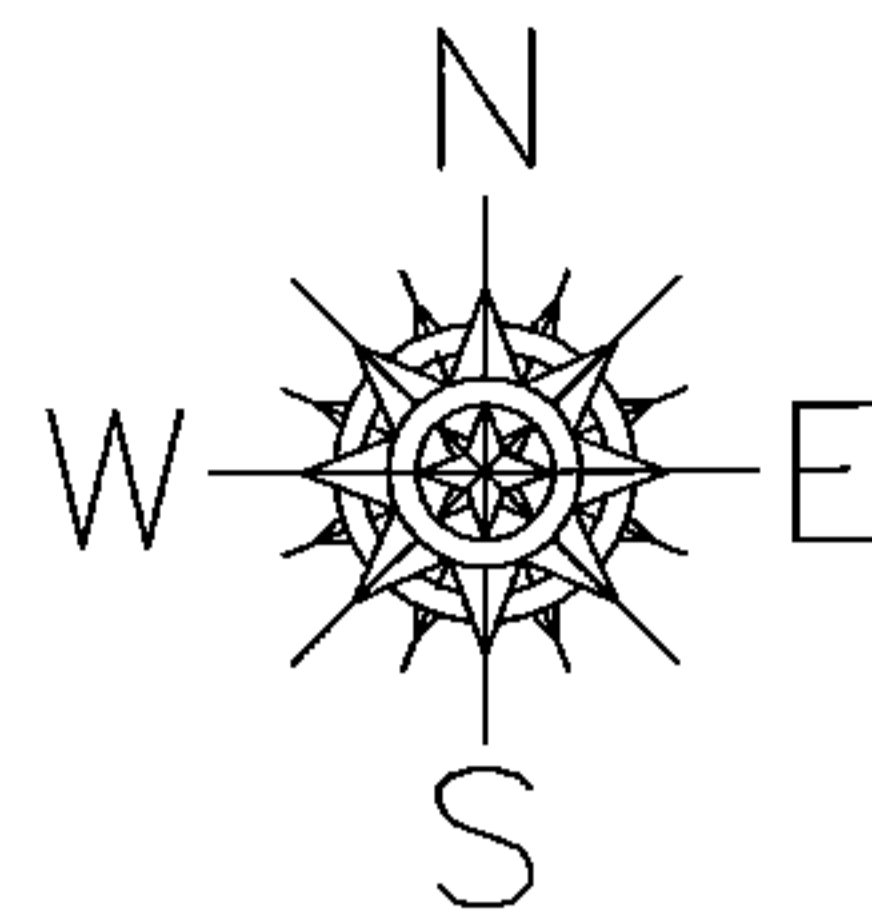

DEPTH CORRECTION

06-26-019-102-009
40 X 91.55
~~40 X -----~~
PER SURVEY BY T.SIMON

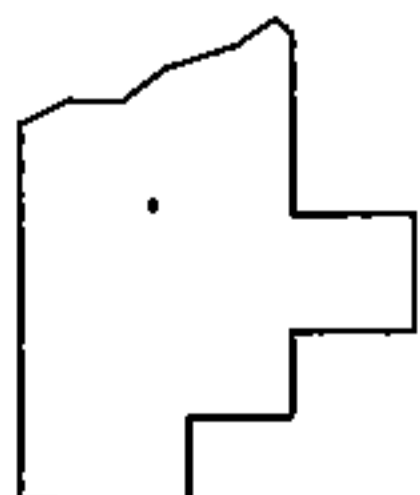

SPLITS/DEEDS PROCESSED

LORAIN COUNTY TAX MAP DEPARTMENT
226 MIDDLE AVE. ELYRIA, OHIO

SURVEYED BY: THOMAS A. SIMON
CLOSURE: .01:10,000
MAP PAGE(S): 6-138
APPROVED BY: RRM DATE: 7-23-14
SCALE: 1"= 50' PRIOR INST.: 20140494672