
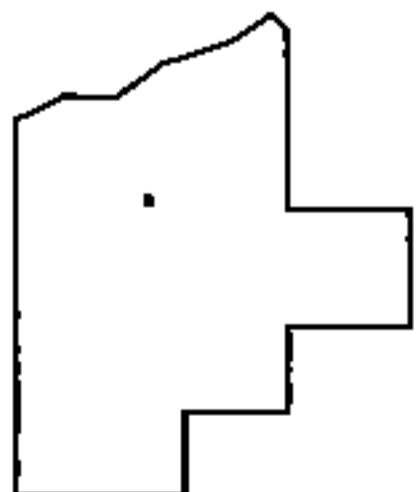
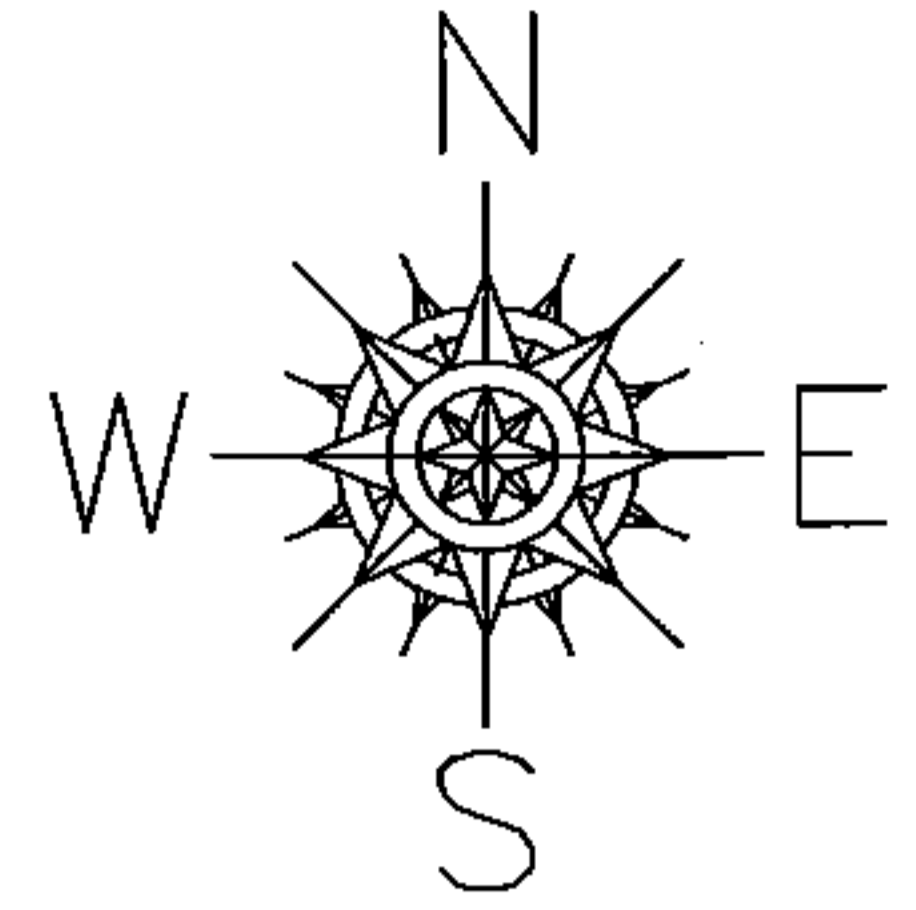


PARENT PARCEL: 10-00-006-115-003

CHILD PARCEL: \_\_\_\_\_

STARTING POINT: INTERSECTION OF C/L OF BUTTERNUT RIDGE RD. AND EAST LINE OF SEC. 6

14-02986-X

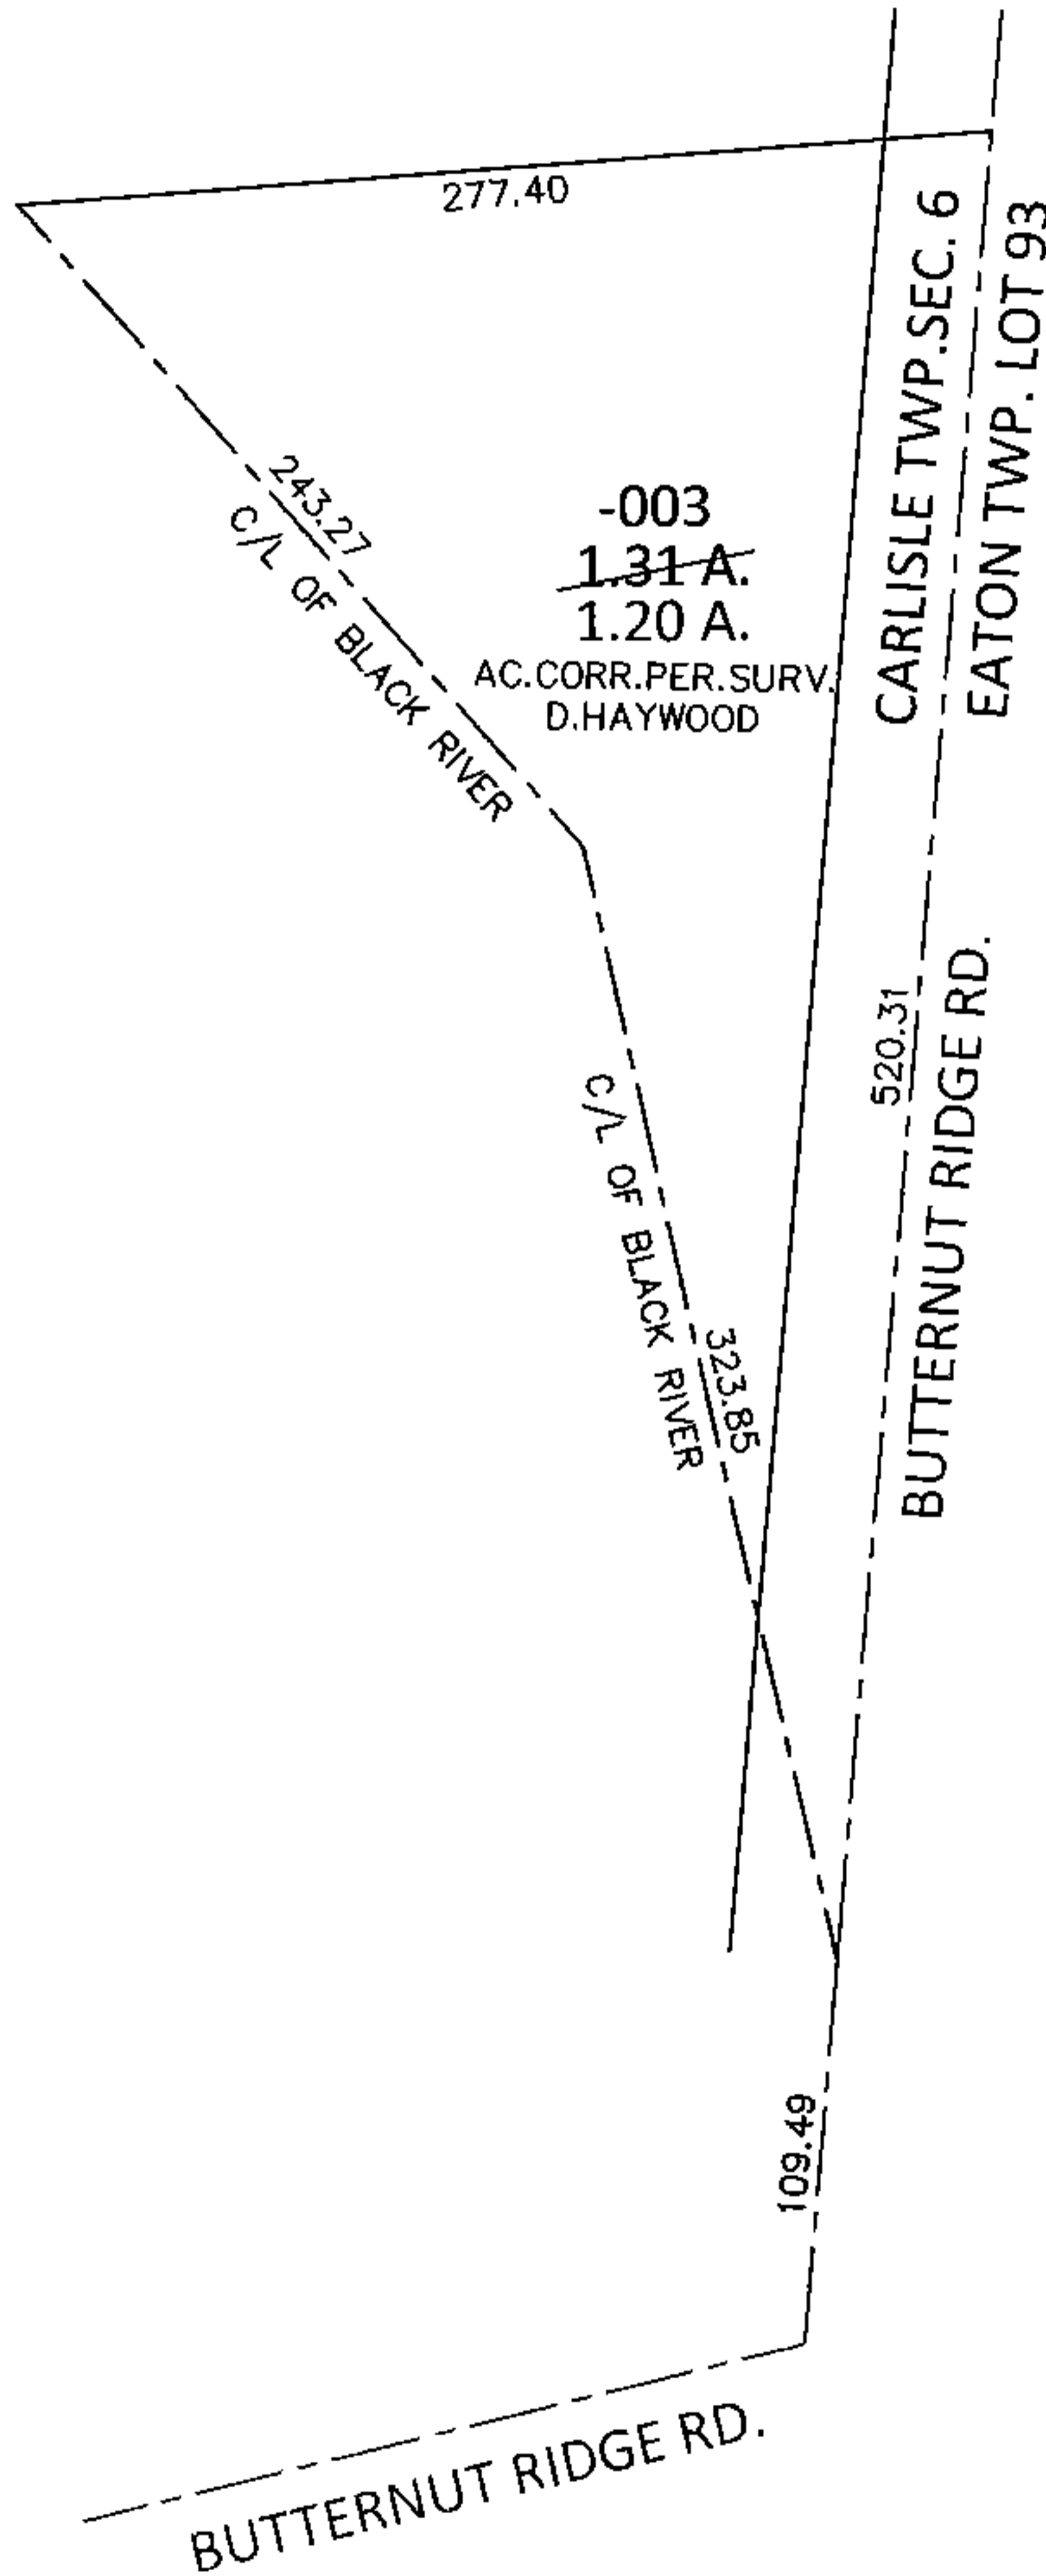

**SPLITS/DEEDS PROCESSED**

LORAIN COUNTY TAX MAP DEPARTMENT  
226 MIDDLE AVE. ELYRIA, OHIO

SURVEYED BY: DALE R. HAYWOOD

CLOSURE: .01:10,000

MAP PAGE(S): 10-00-006-D

APPROVED BY: RRM DATE: 7-28-14

SCALE: 1"= 100 PRIOR INST.: 20020832833