

PARENT PARCEL: 15-00-055-104-001, -036




CHILD PARCEL:

STARTING POINT: NORTHWEST CORNER OF O.L.55

14-02987-C

**FRONTAGE AND DEPTH CORRECTION**

15-00-055-104-001  
91.03 X 146.27  
~~49 X 114~~  
PER SURVEY BY T.W.LAUNDON

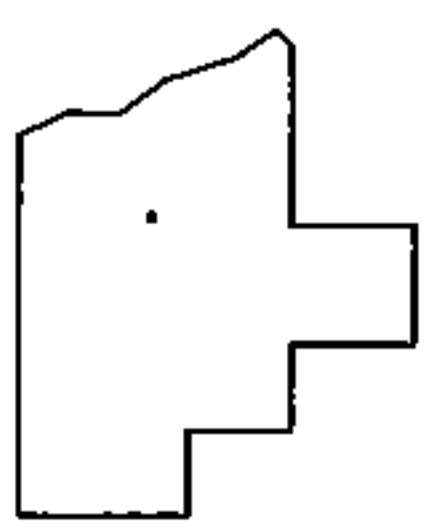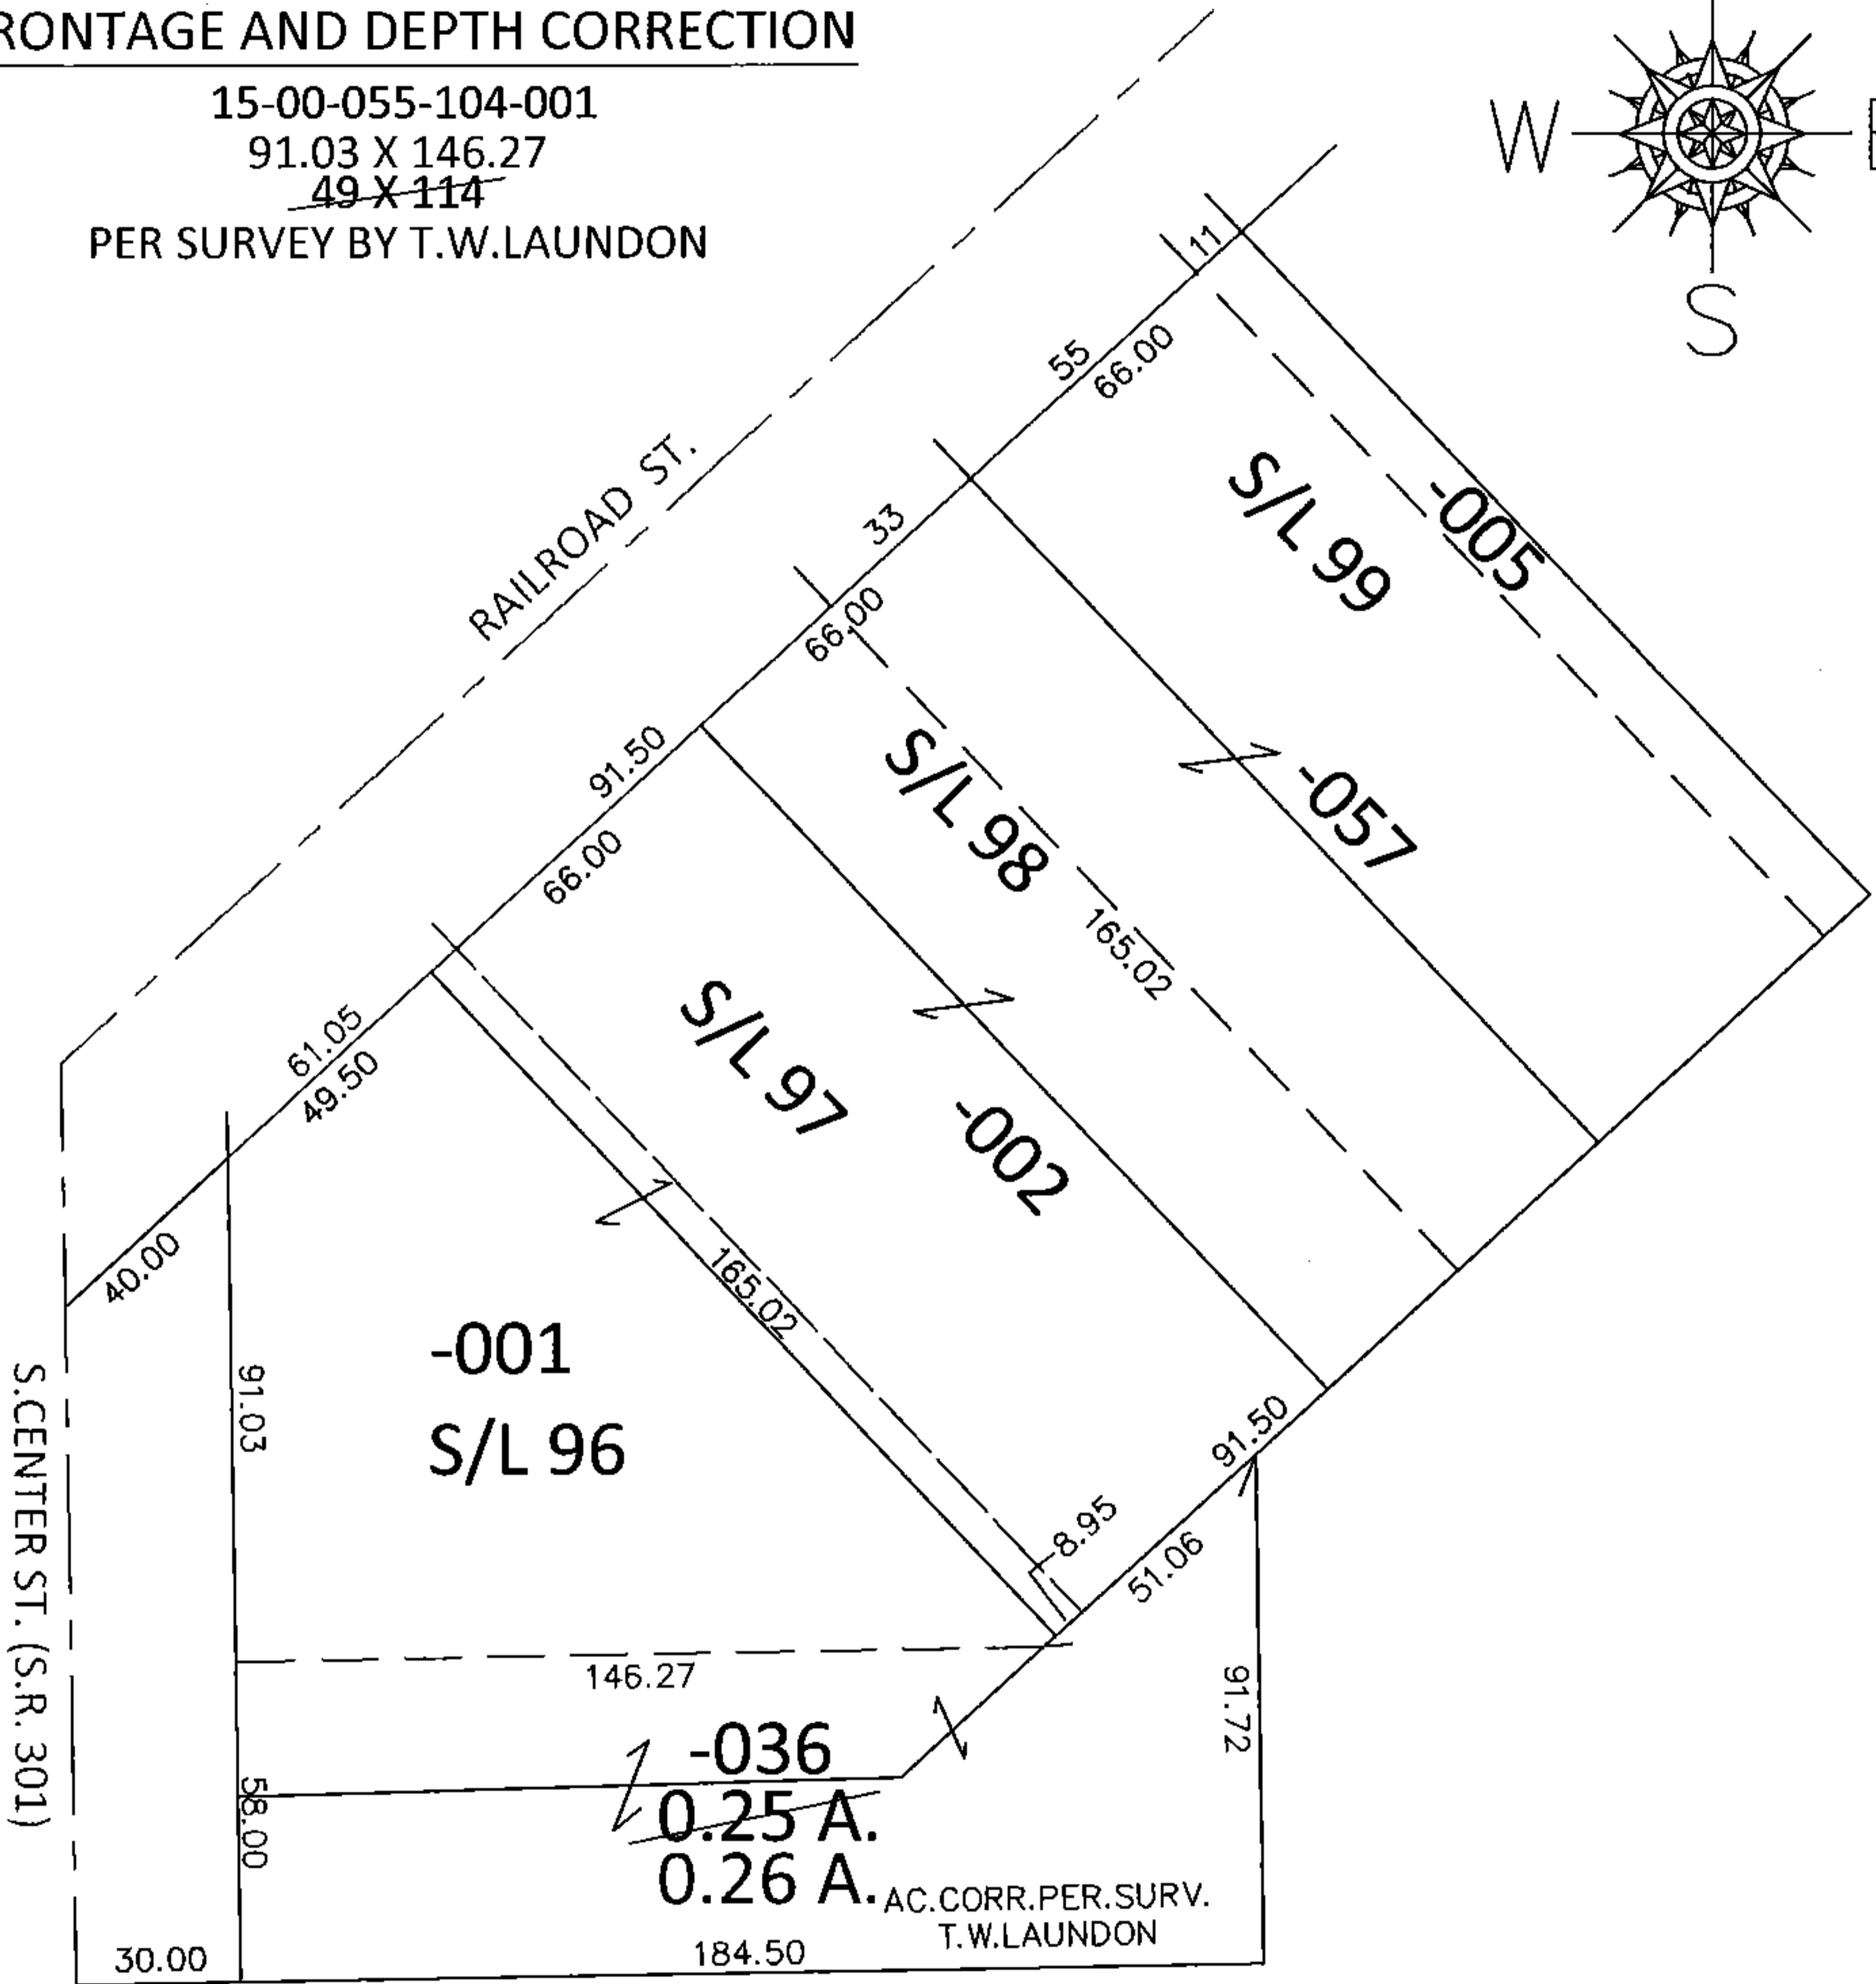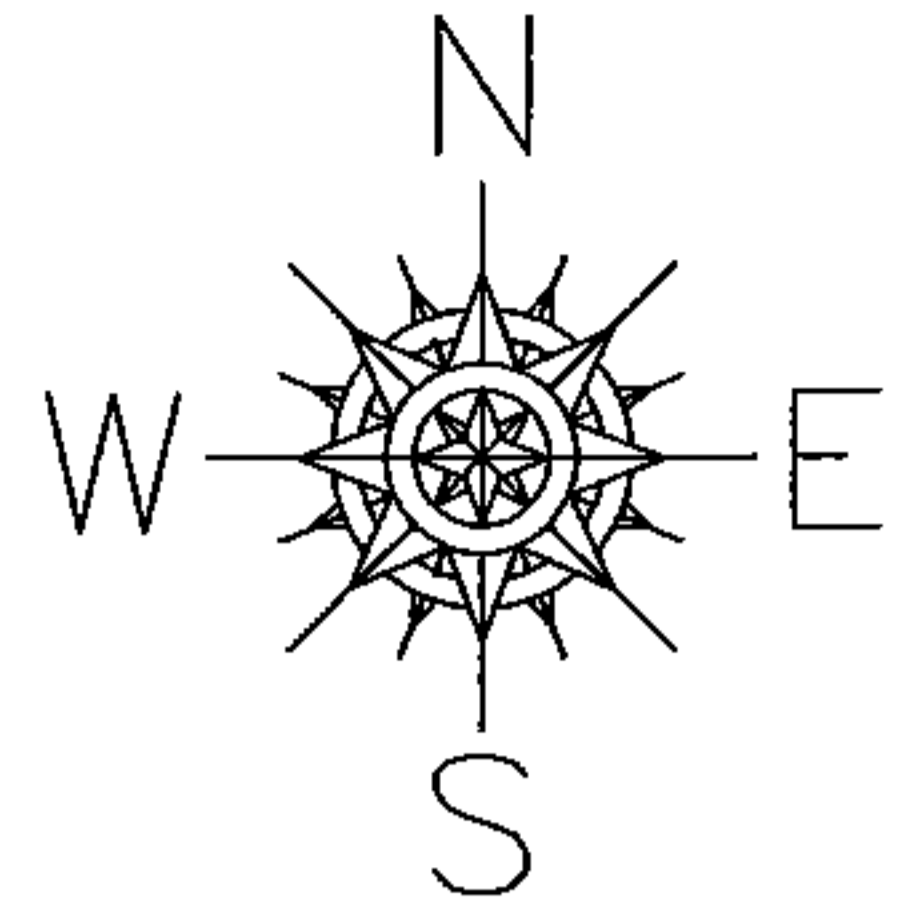

**SPLITS/DEEDS PROCESSED**

LORAIN COUNTY TAX MAP DEPARTMENT  
226 MIDDLE AVE. ELYRIA, OHIO

SURVEYED BY:	T.W. LAUNDON
CLOSURE:	DOES NOT CLOSE
MAP PAGE(S):	15-00-055-A
APPROVED BY:	RRM DATE: 7-23-14
SCALE:	1" = 50'
PRIOR INST.:	DV 836/164