




RASO

PARENT PARCEL: 09-00-084-101-034, -033

CHILD PARCEL: 09-00-084-101-096

STARTING POINT: CENTERLINE OF LORAIN ST & PROSPECT ST

12-02987

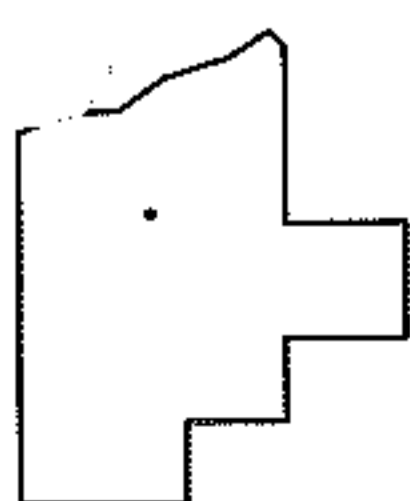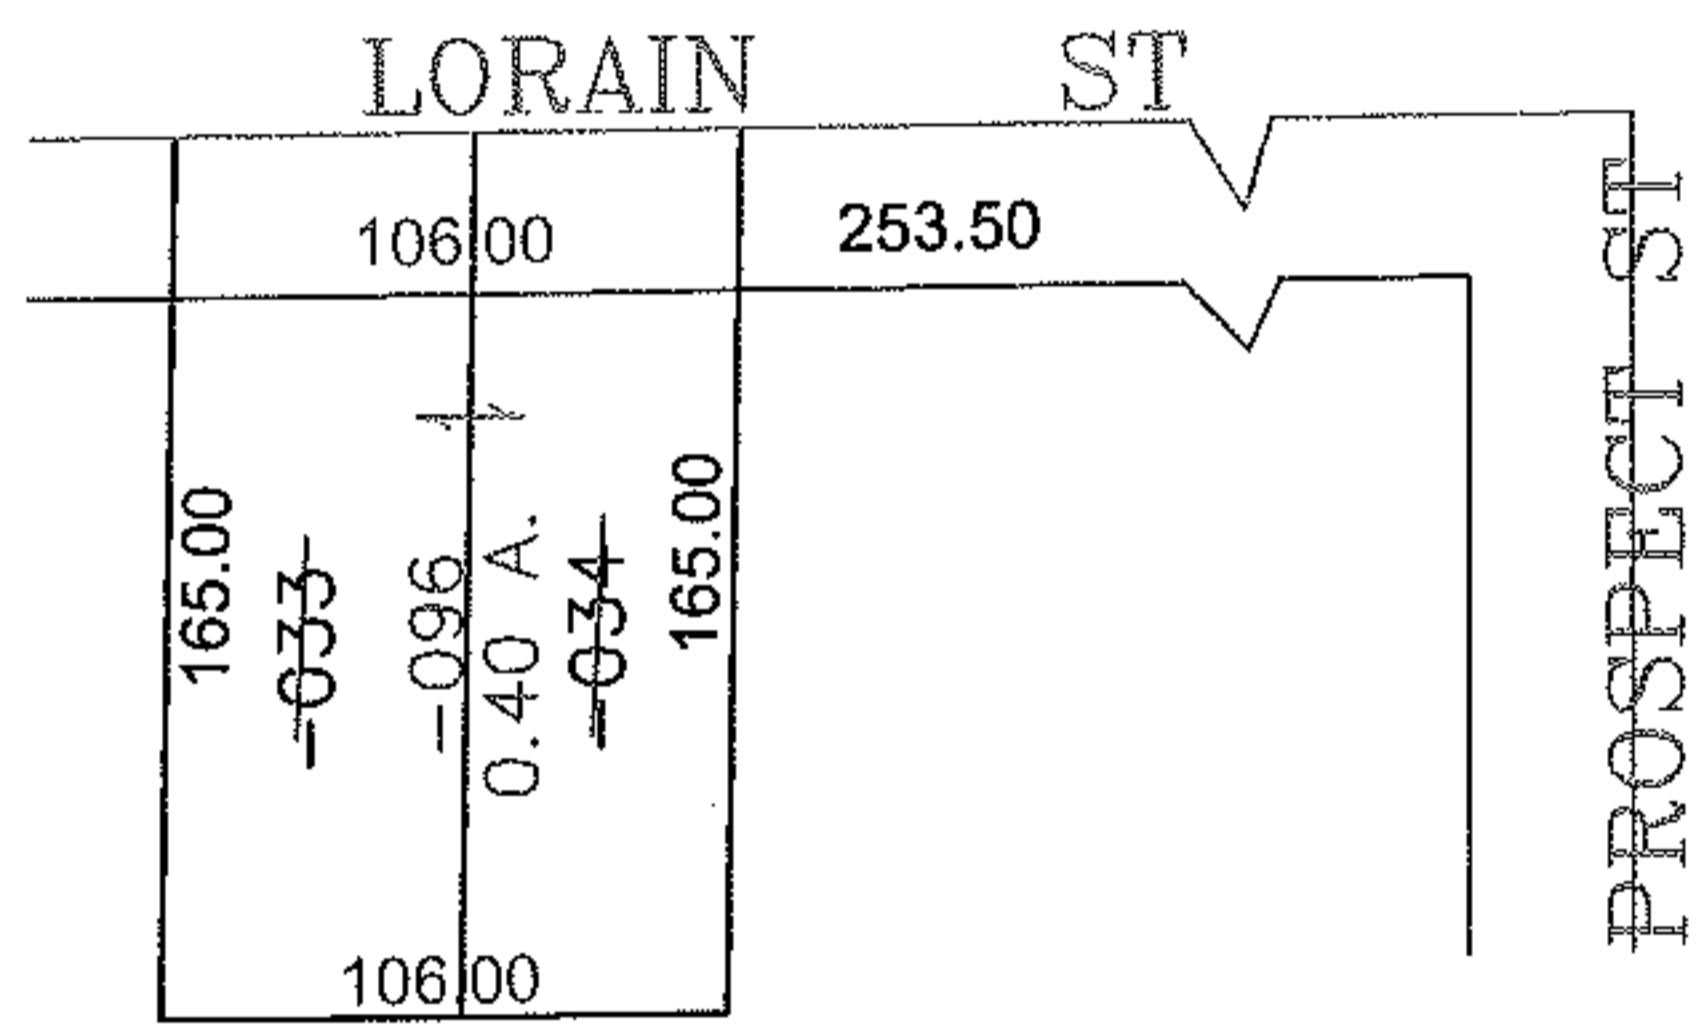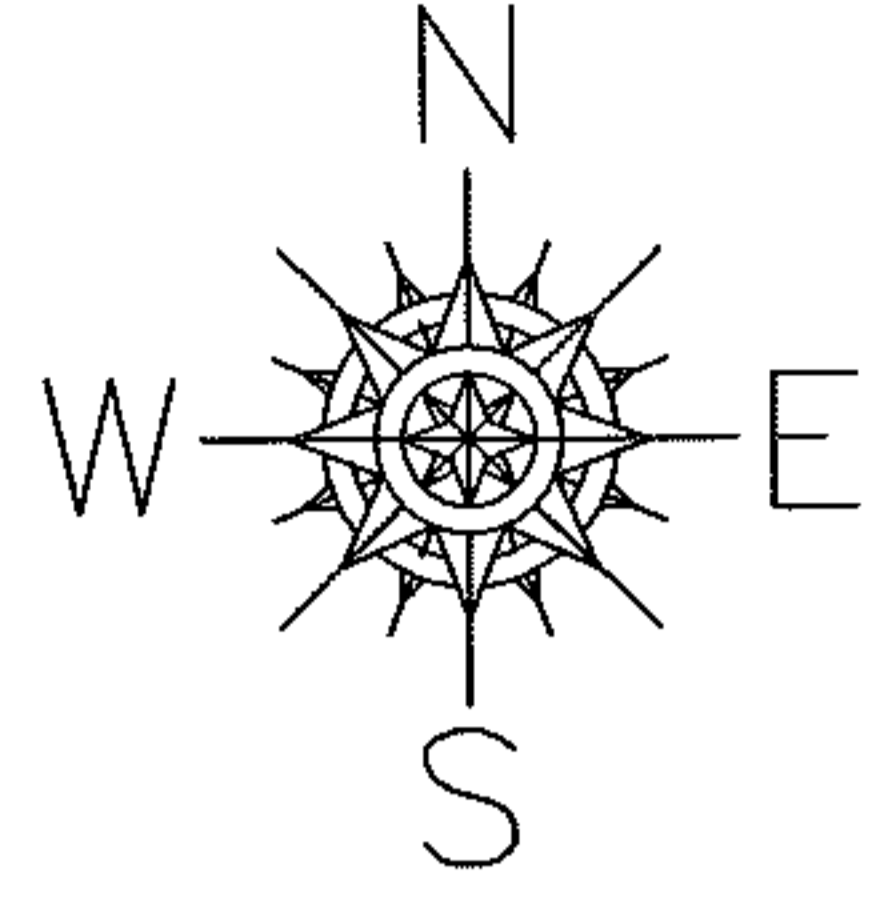

SPLITS/DEEDS PROCESSED

LORAIN COUNTY TAX MAP DEPARTMENT
226 MIDDLE AVE. ELYRIA, OHIO

SURVEYED BY: DALE HAYWOOD

CLOSURE: 0.00 : 10,000

MAP PAGE(S): 09-00-084-B

APPROVED BY: JAH DATE: 1-5-2012

SCALE: 1" = 100' PRIOR INSTRUMENT: 20030883660