


PARENT PARCEL: 06-25-032-116-001



CHILD PARCEL: _____

STARTING POINT: NORTHWEST CORNER OF S/L 3 IN PIKEVIEW SUB. (VOL.19 PG.27)

14-02990-D

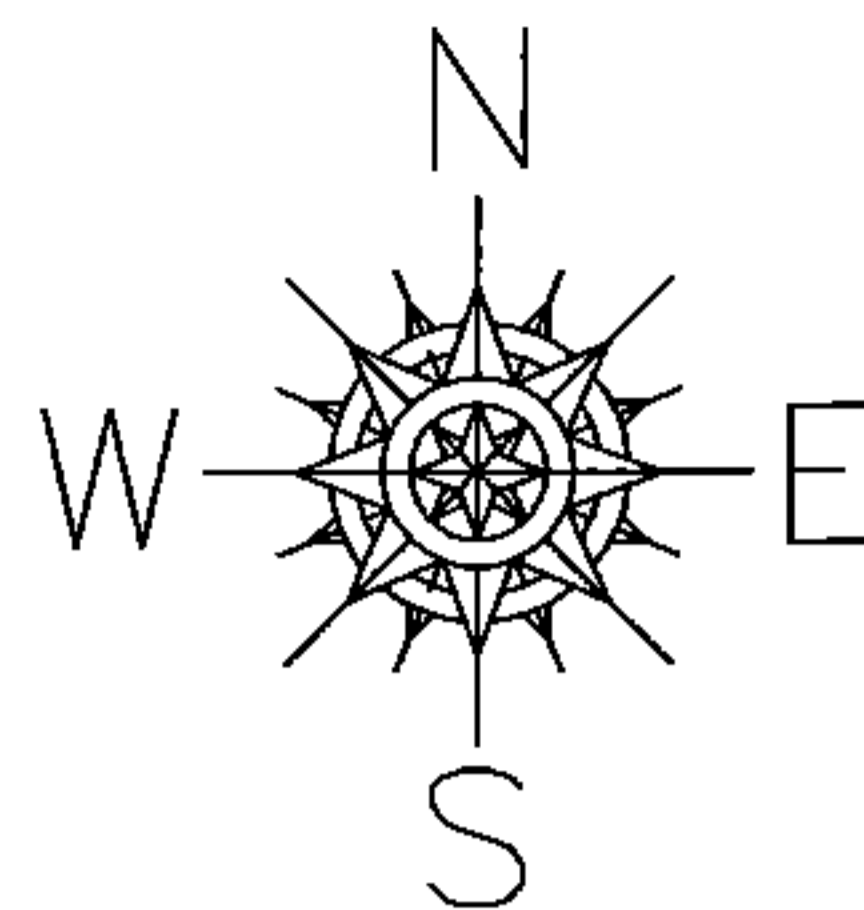

MAP CORRECTION ONLY

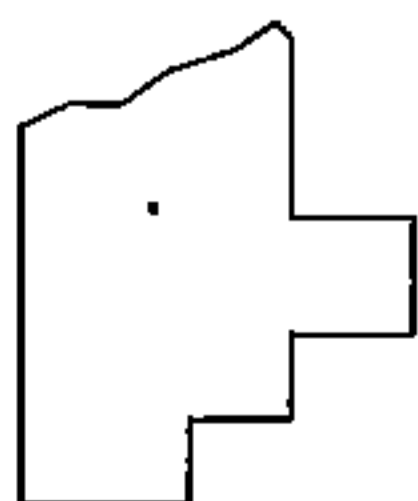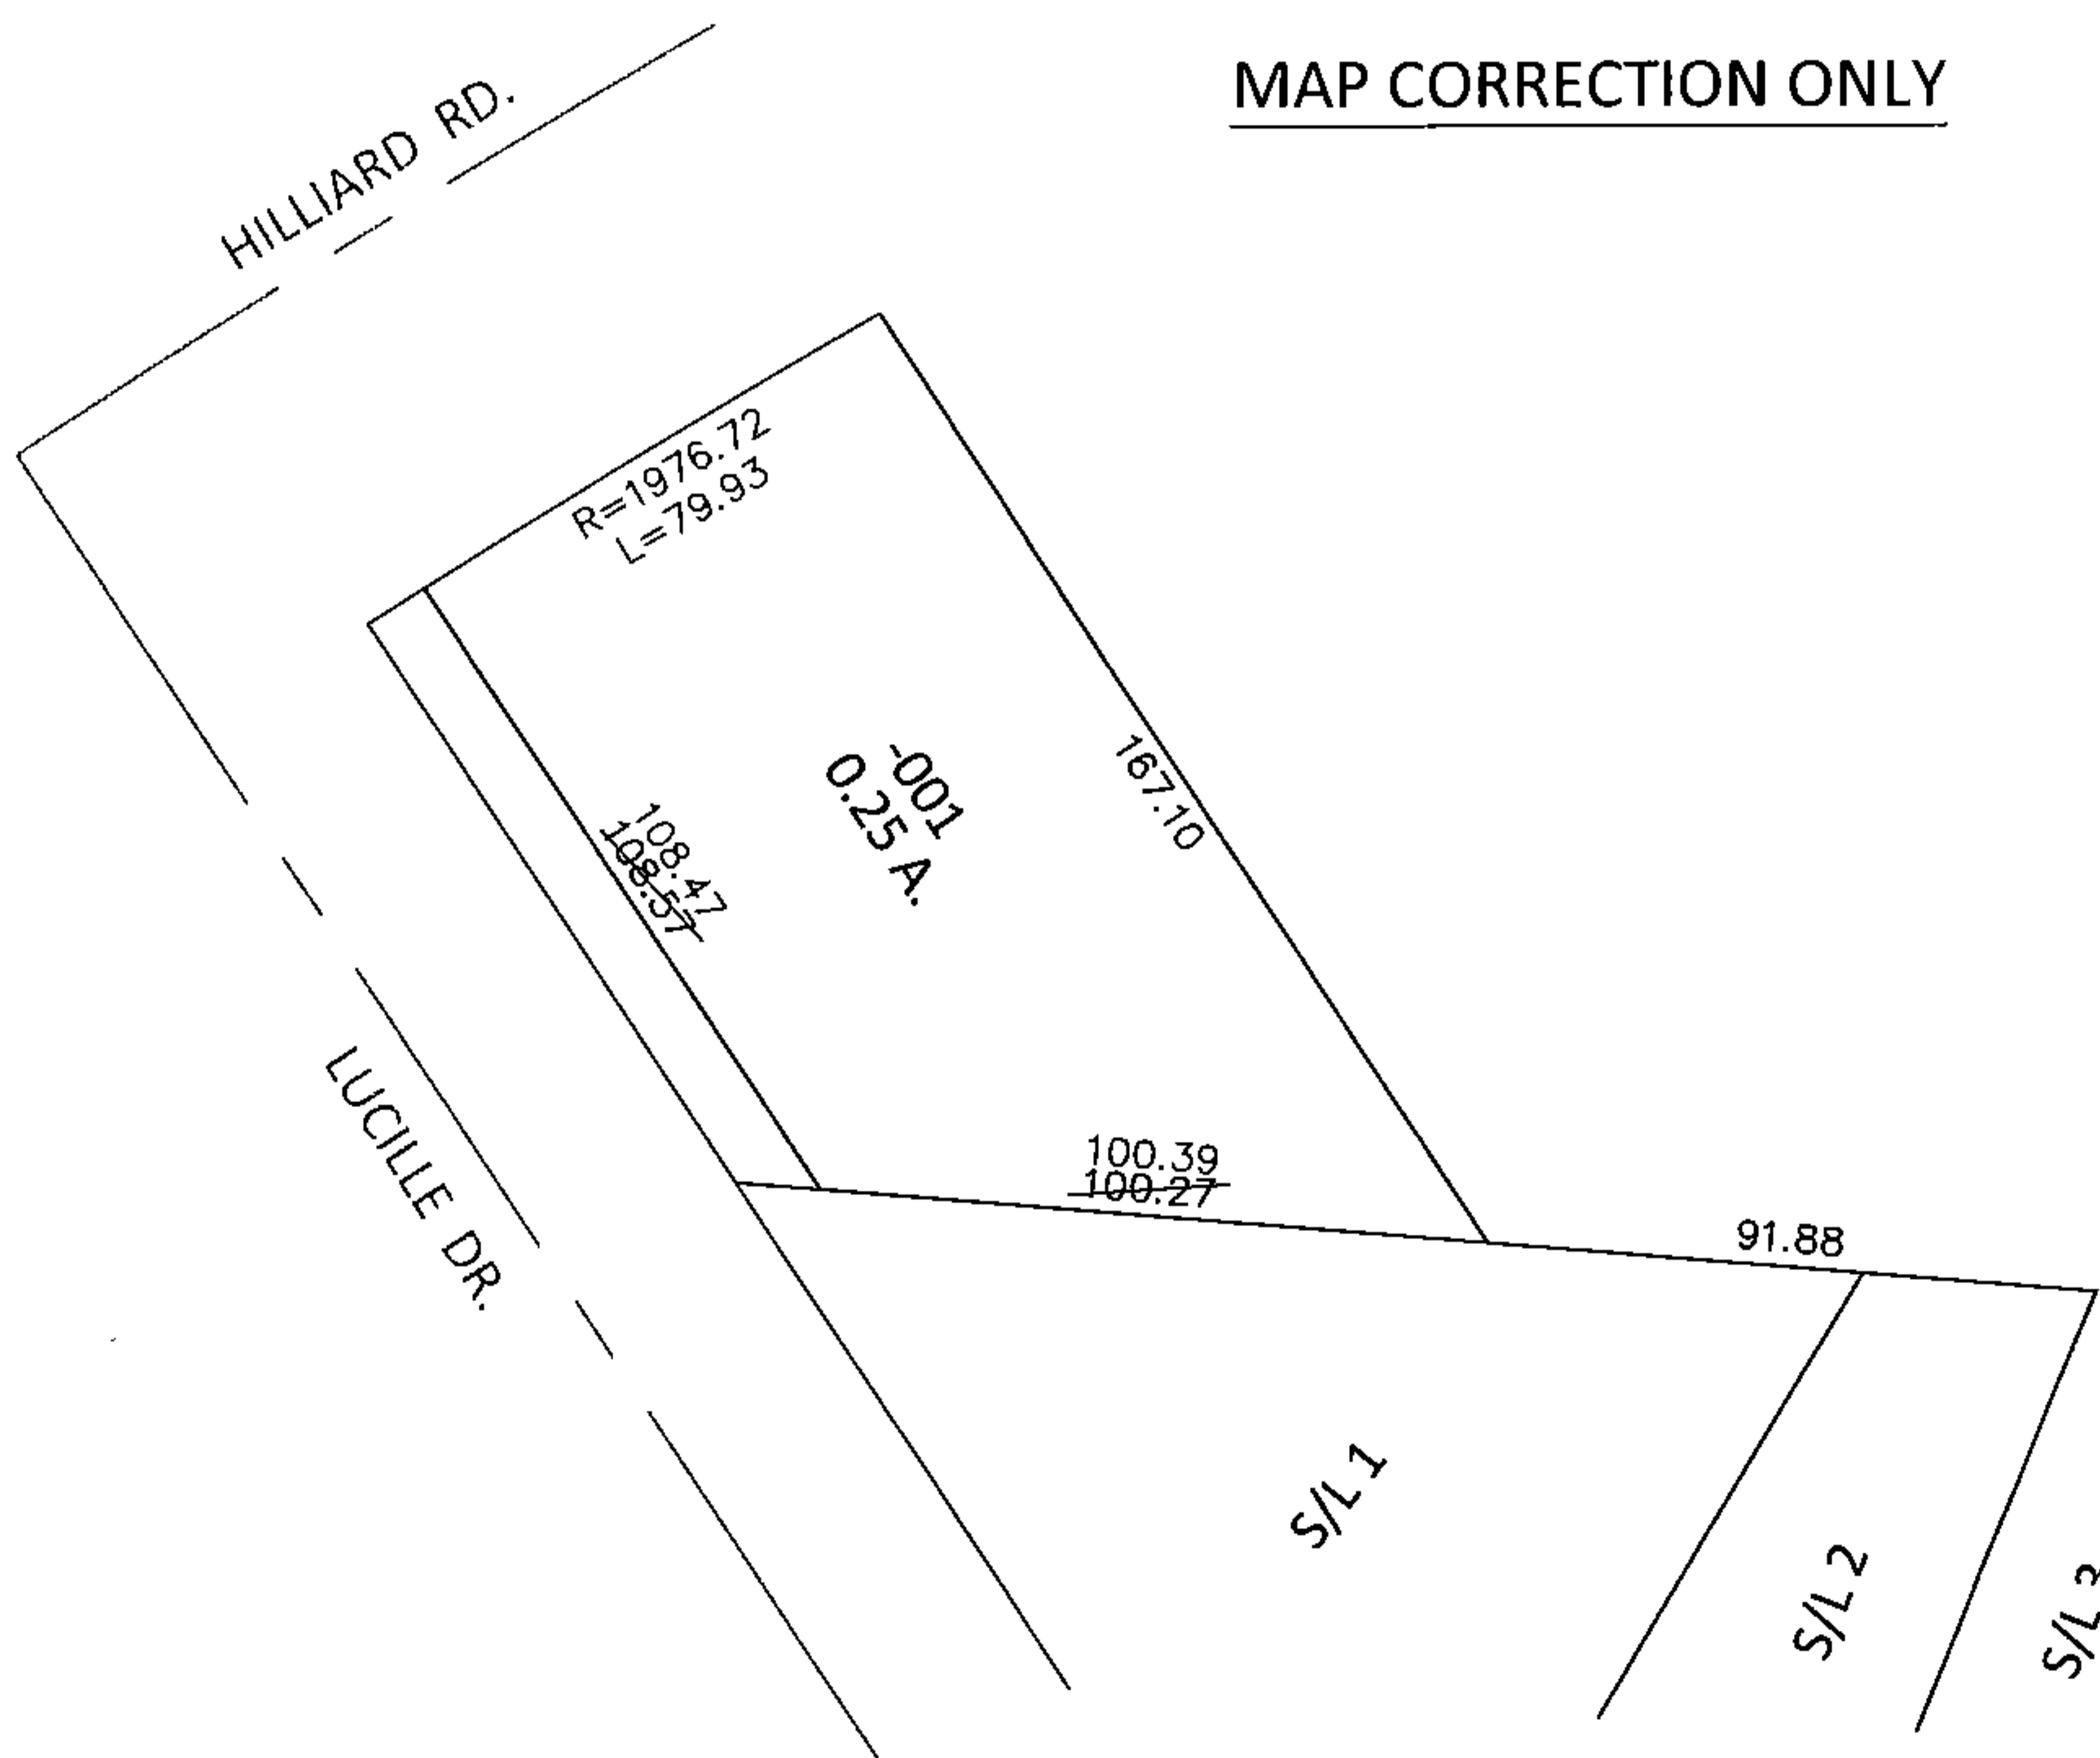

SPLITS/DEEDS PROCESSED

LORAIN COUNTY TAX MAP DEPARTMENT
226 MIDDLE AVE. ELYRIA, OHIO

SURVEYED BY: SUSAN L. EICHHORN

CLOSURE: .01:10,000

MAP PAGE(S): 6-69

APPROVED BY: RRM DATE: 8-4-14

SCALE: 1"=50' PRIOR INST.: 20140495682