
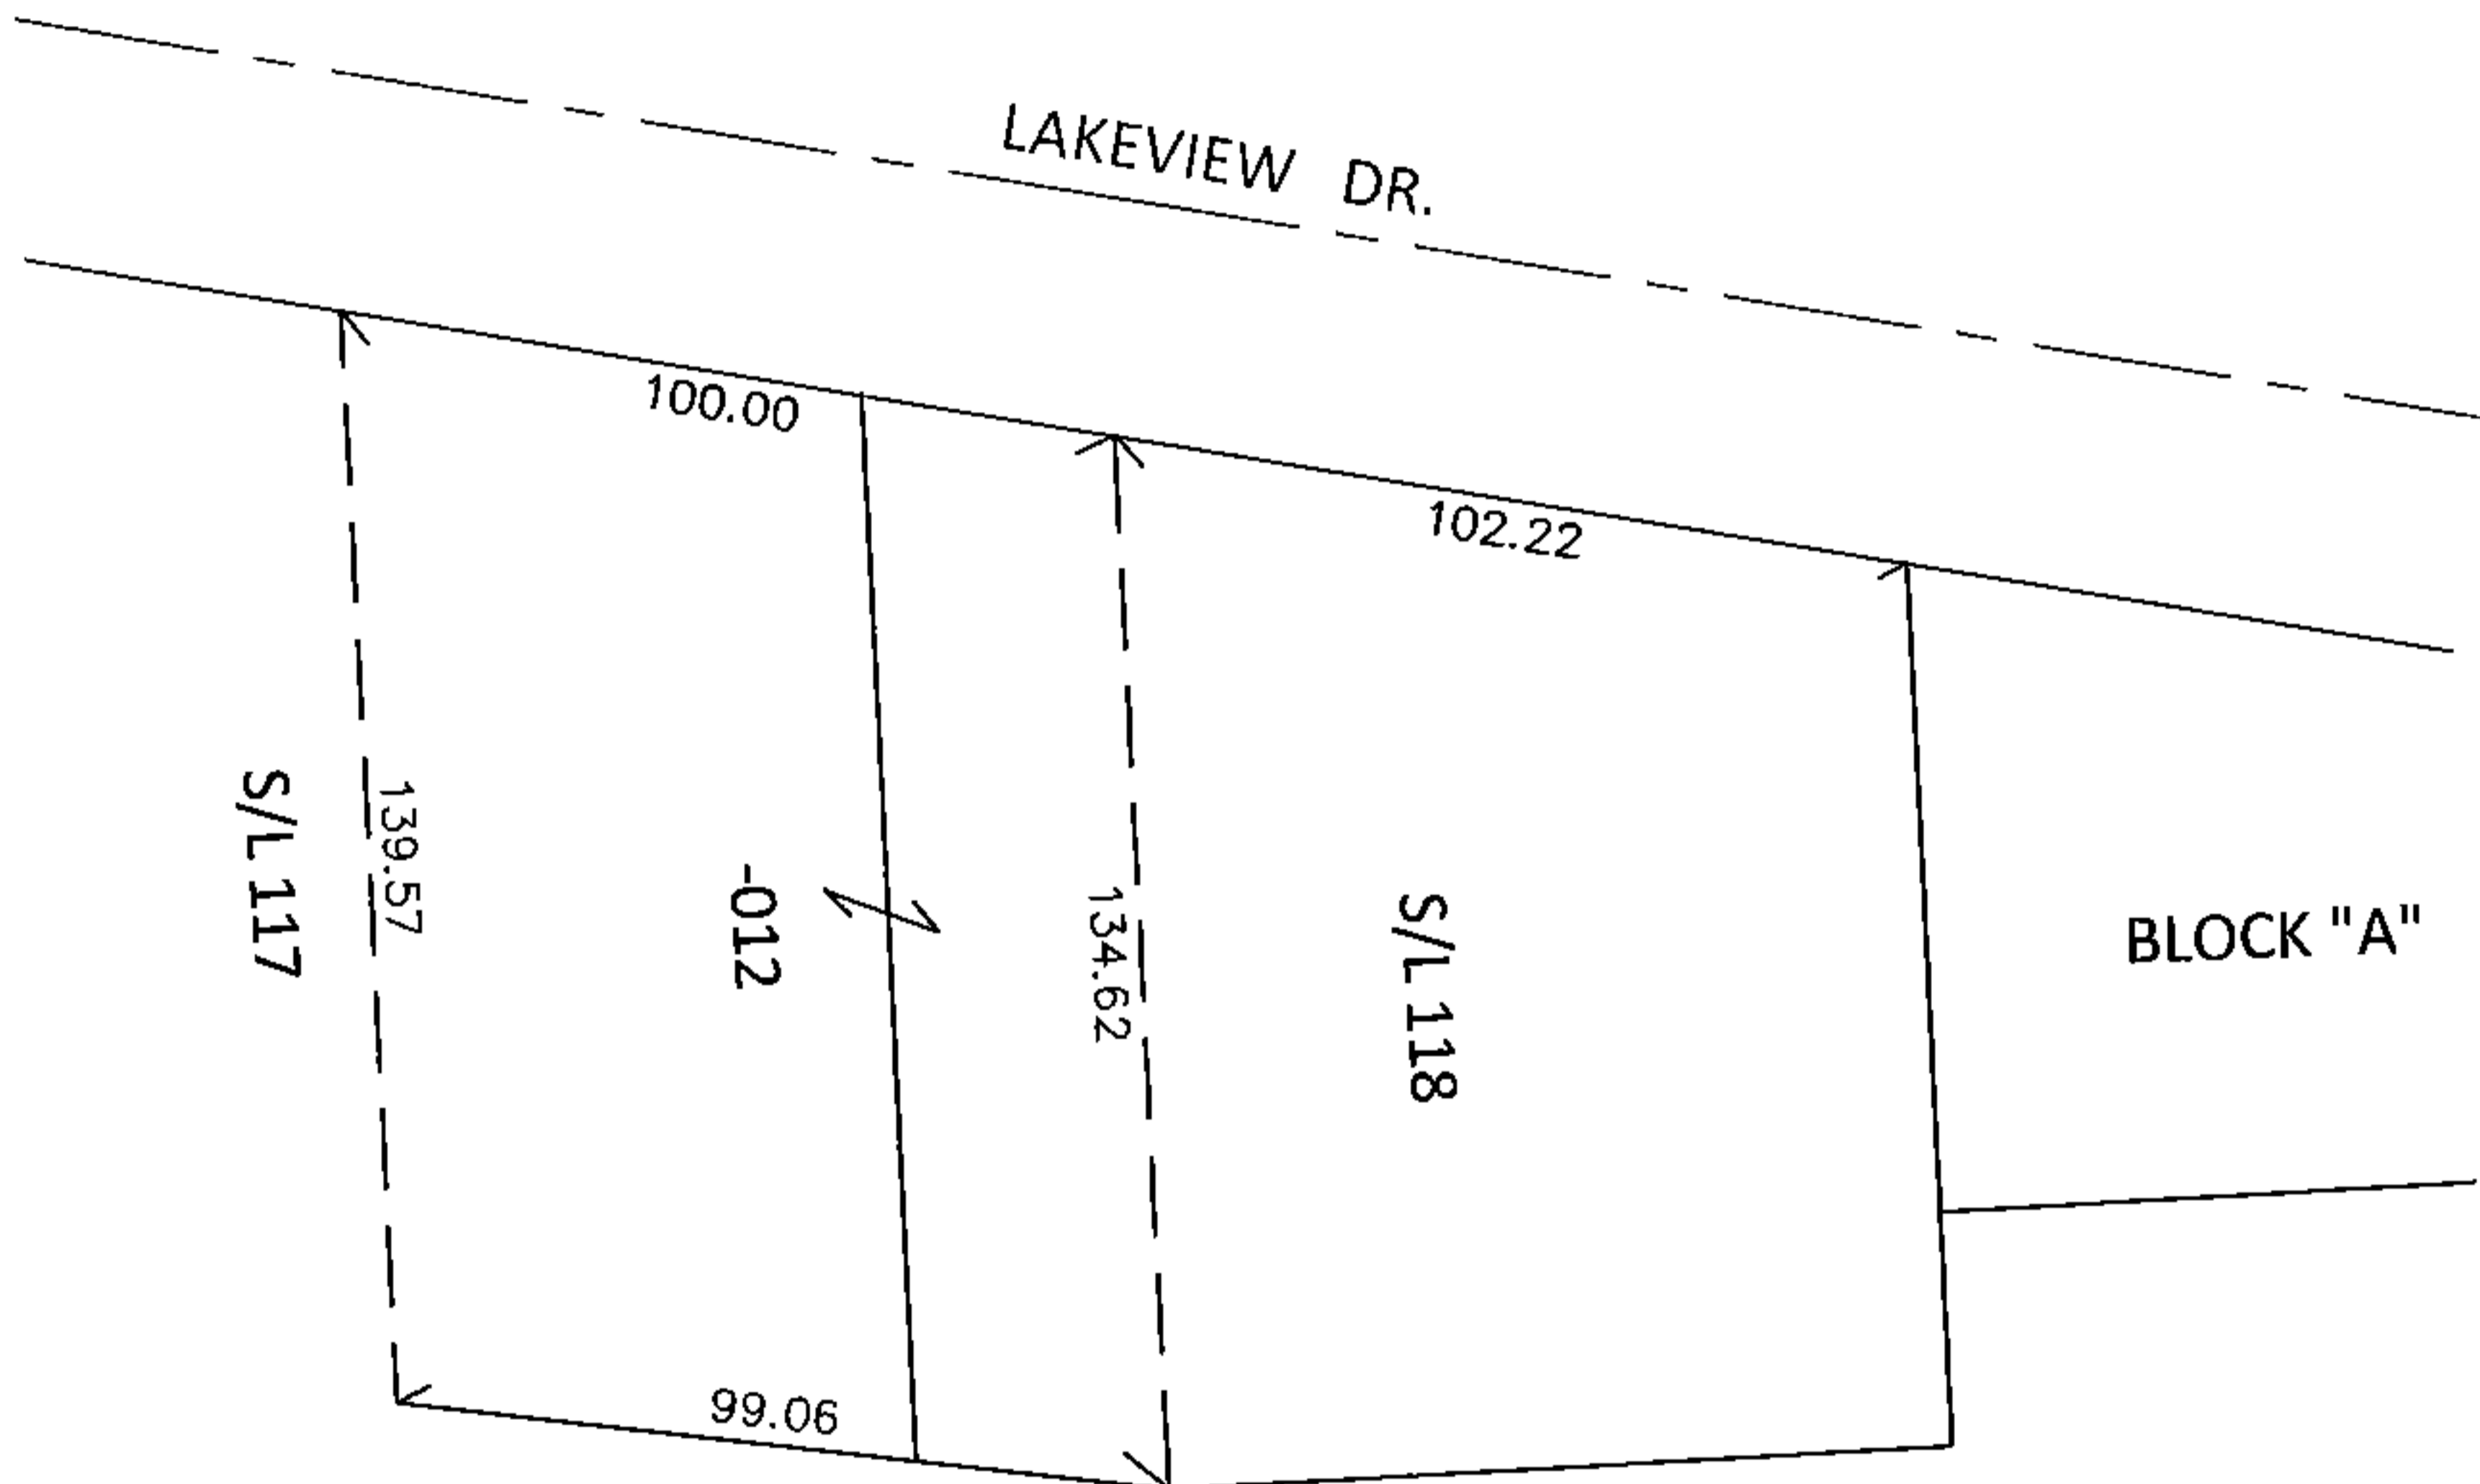


PARENT PARCEL: 10-00-015-109-012

CHILD PARCEL:

STARTING POINT: NORTHWEST CORNER OF BLOCK A IN BRENTWOOD ALLOT. NO.2 (VOL.16 PG.11)

14-02991-D

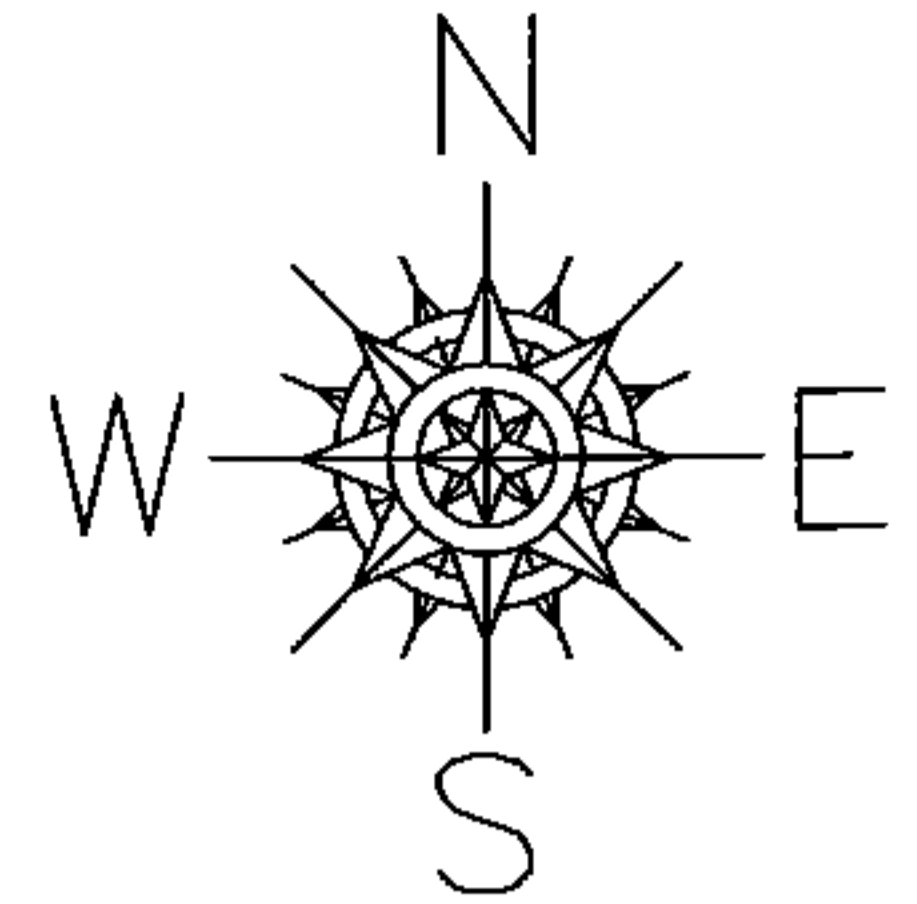


DEPTH CORRECTION

10-00-015-109-012

139.57

100 X ~~142~~

PER SURVEY BY AMY M. KELLY

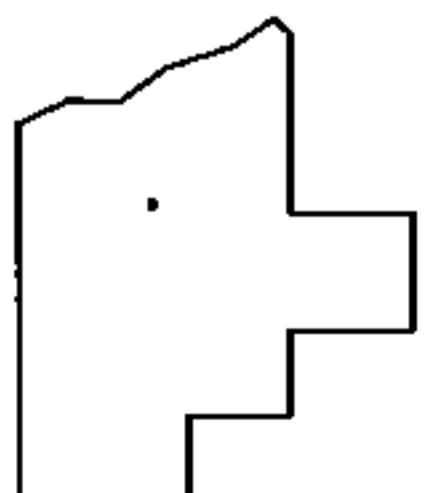

SPLITS/DEEDS PROCESSED

LORAIN COUNTY TAX MAP DEPARTMENT
226 MIDDLE AVE. ELYRIA, OHIO

SURVEYED BY: AMY M. KELLY

CLOSURE: .01:10,000

MAP PAGE(S): 10-00-015-D

APPROVED BY: RRM DATE: 7-29-14

SCALE: 1"= 50' PRIOR INST.: 20140498202