


PARENT PARCEL: 05-00-006-000-055, -072, 05-00-007-000-008, -012, -013, -010, -007, 05-00-007-500-001  
05-00-094-105-021, -022

CHILD PARCEL: 05-00-006-000-055, -072, 05-00-007-000-025, -026, -027, 05-00-094-105-047

STARTING POINT: AT A MON BOX AT THE INTERSECTION OF C/L OF MIDDLE RIDGE RD. AND C/L OF QUARRY RD.

12-02991

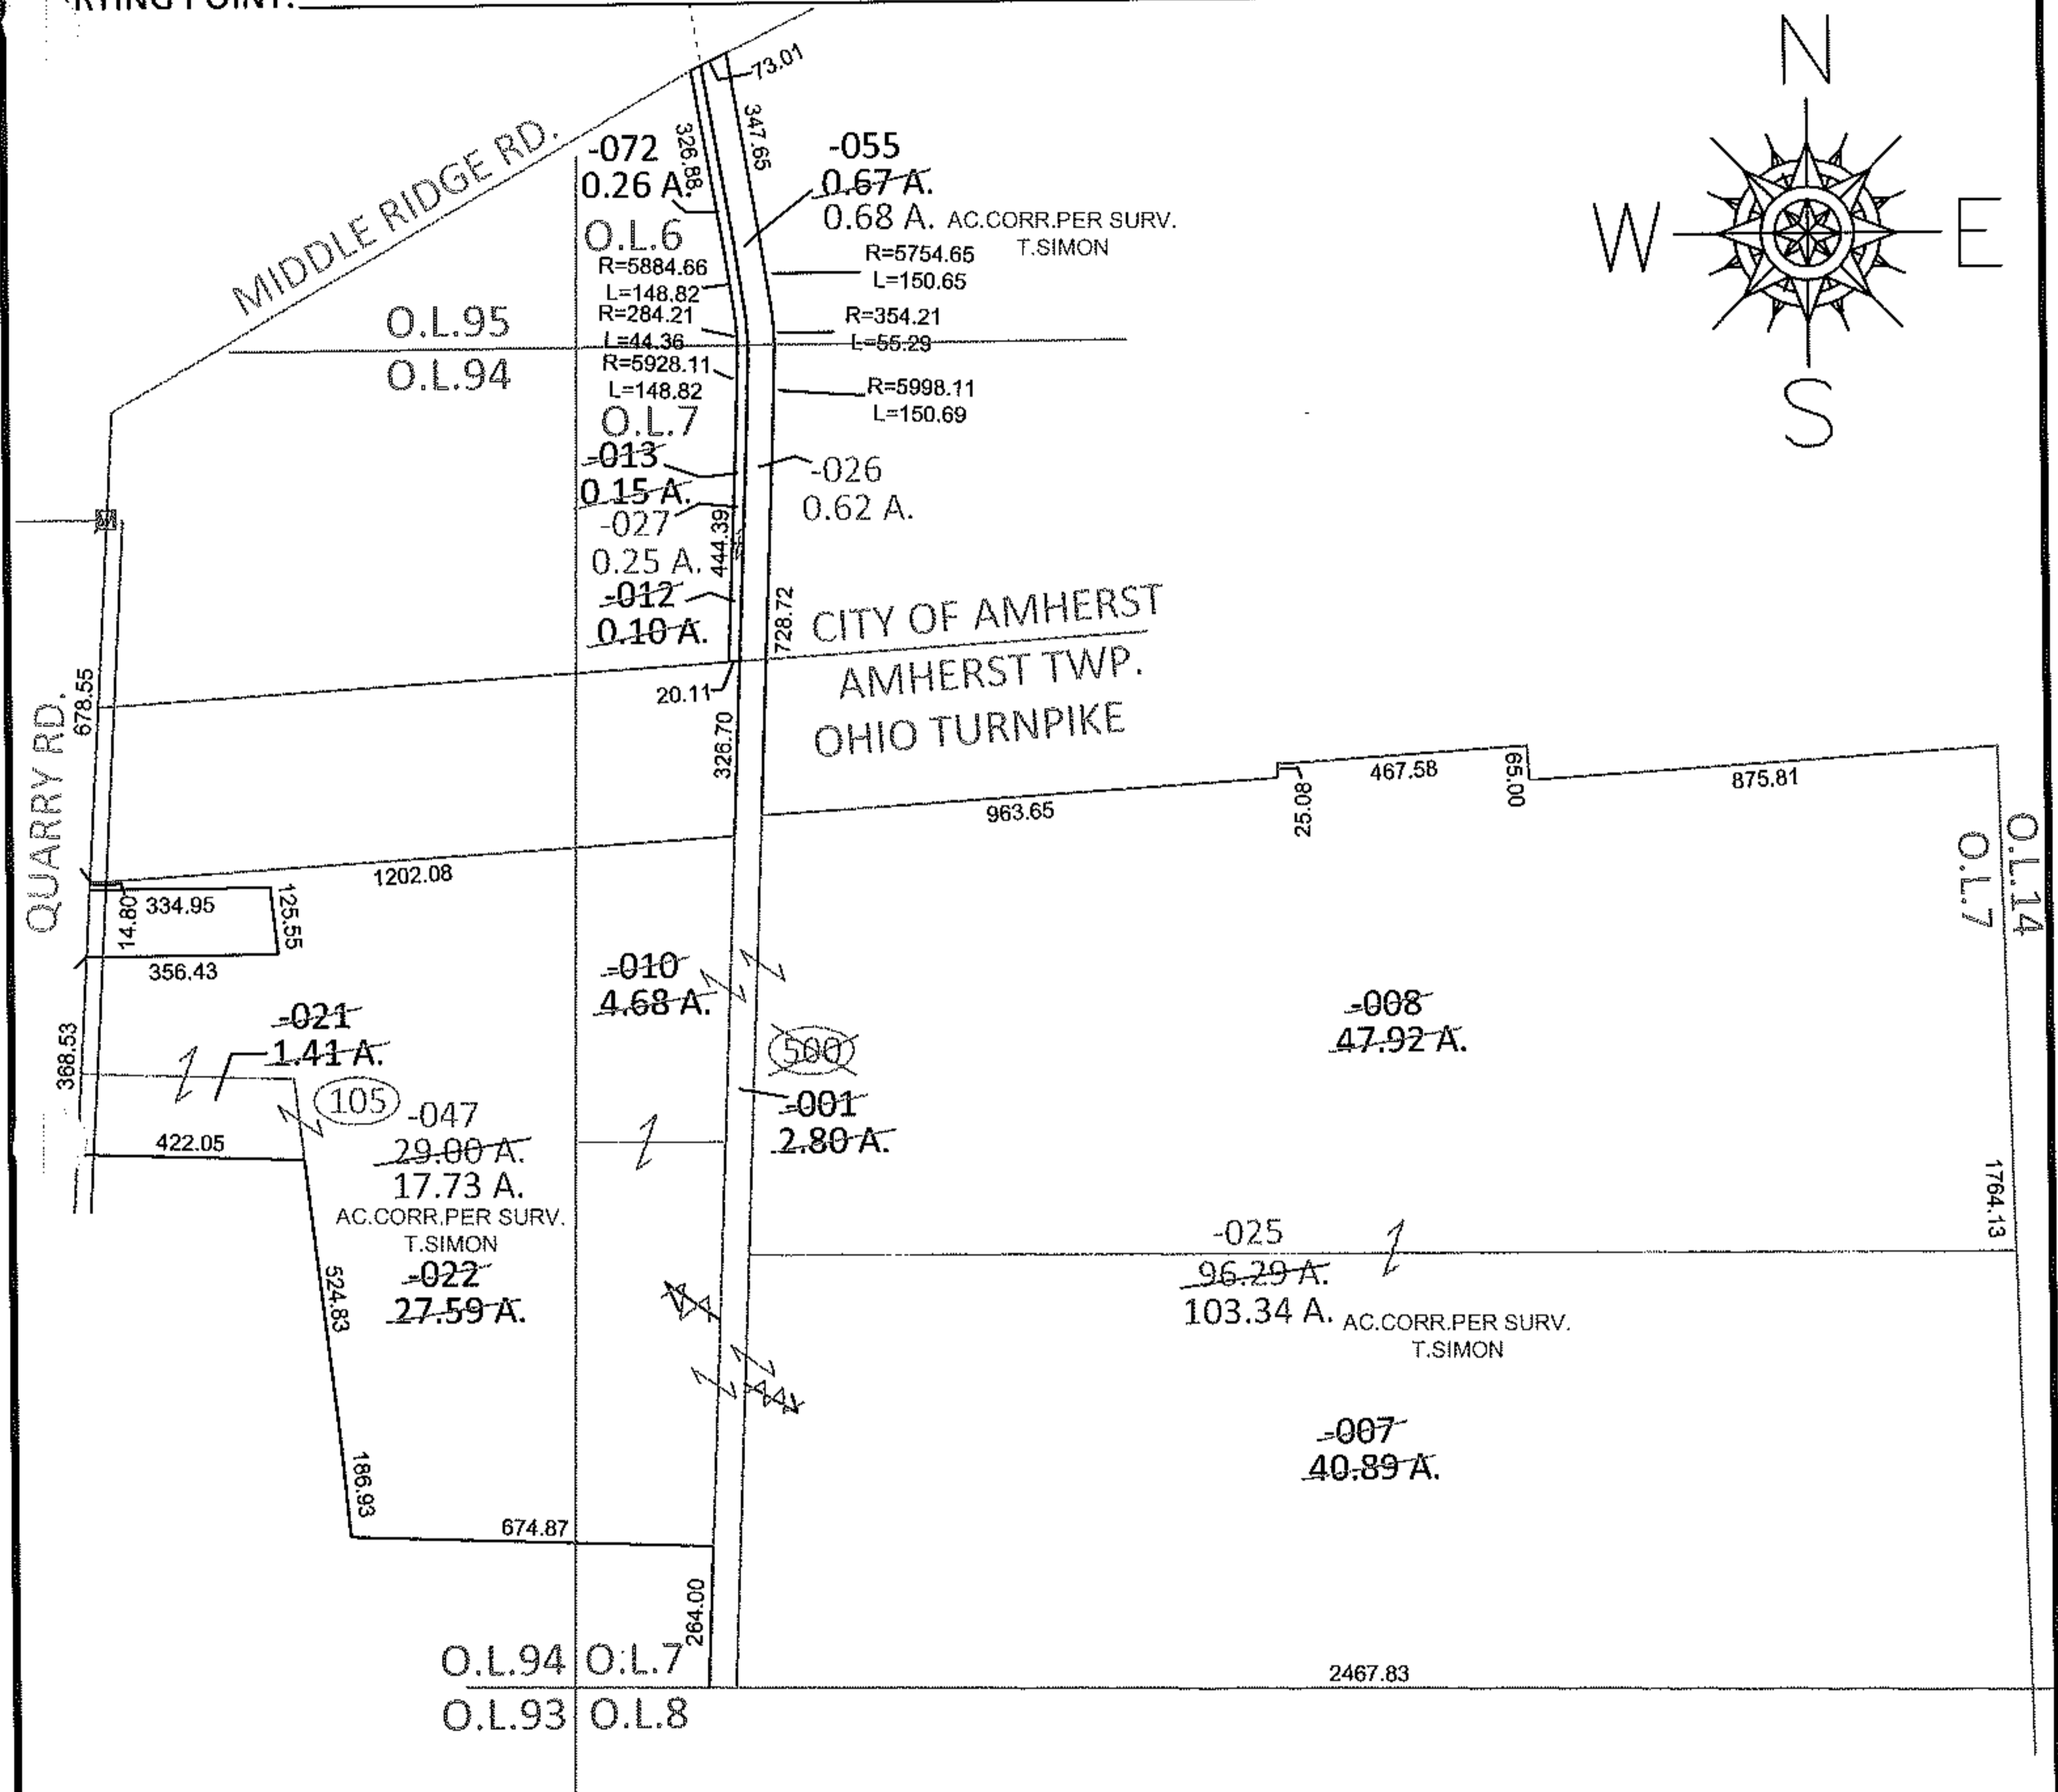

20070233909  
20080244345  
20080254132

**SPLITS/DEEDS PROCESSED**

LORAIN COUNTY TAX MAP DEPARTMENT  
226 MIDDLE AVE. ELYRIA, OHIO

SURVEYED BY: THOMAS A. SIMON  
CLOSURE: .01:10,000  
MAP PAGE(S): 5-00-094-B & C, 5-E  
APPROVED BY: RRM DATE: 4-4-12  
SCALE: 1"= 500 PRIOR INST.: \*SEE ABOVE\*