



RUSTER

PARENT PARCEL: 01-00-038-000-002, -011, -055

CHILD PARCEL: 01-00-038-000-056

STARTING POINT: AT A MON BOX AT THE NORTHEAST CORNER OF O.L.38

12-02993

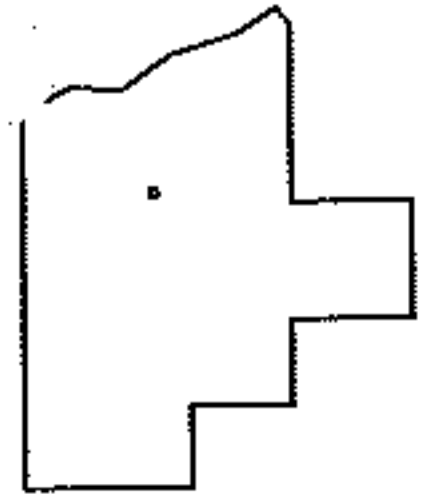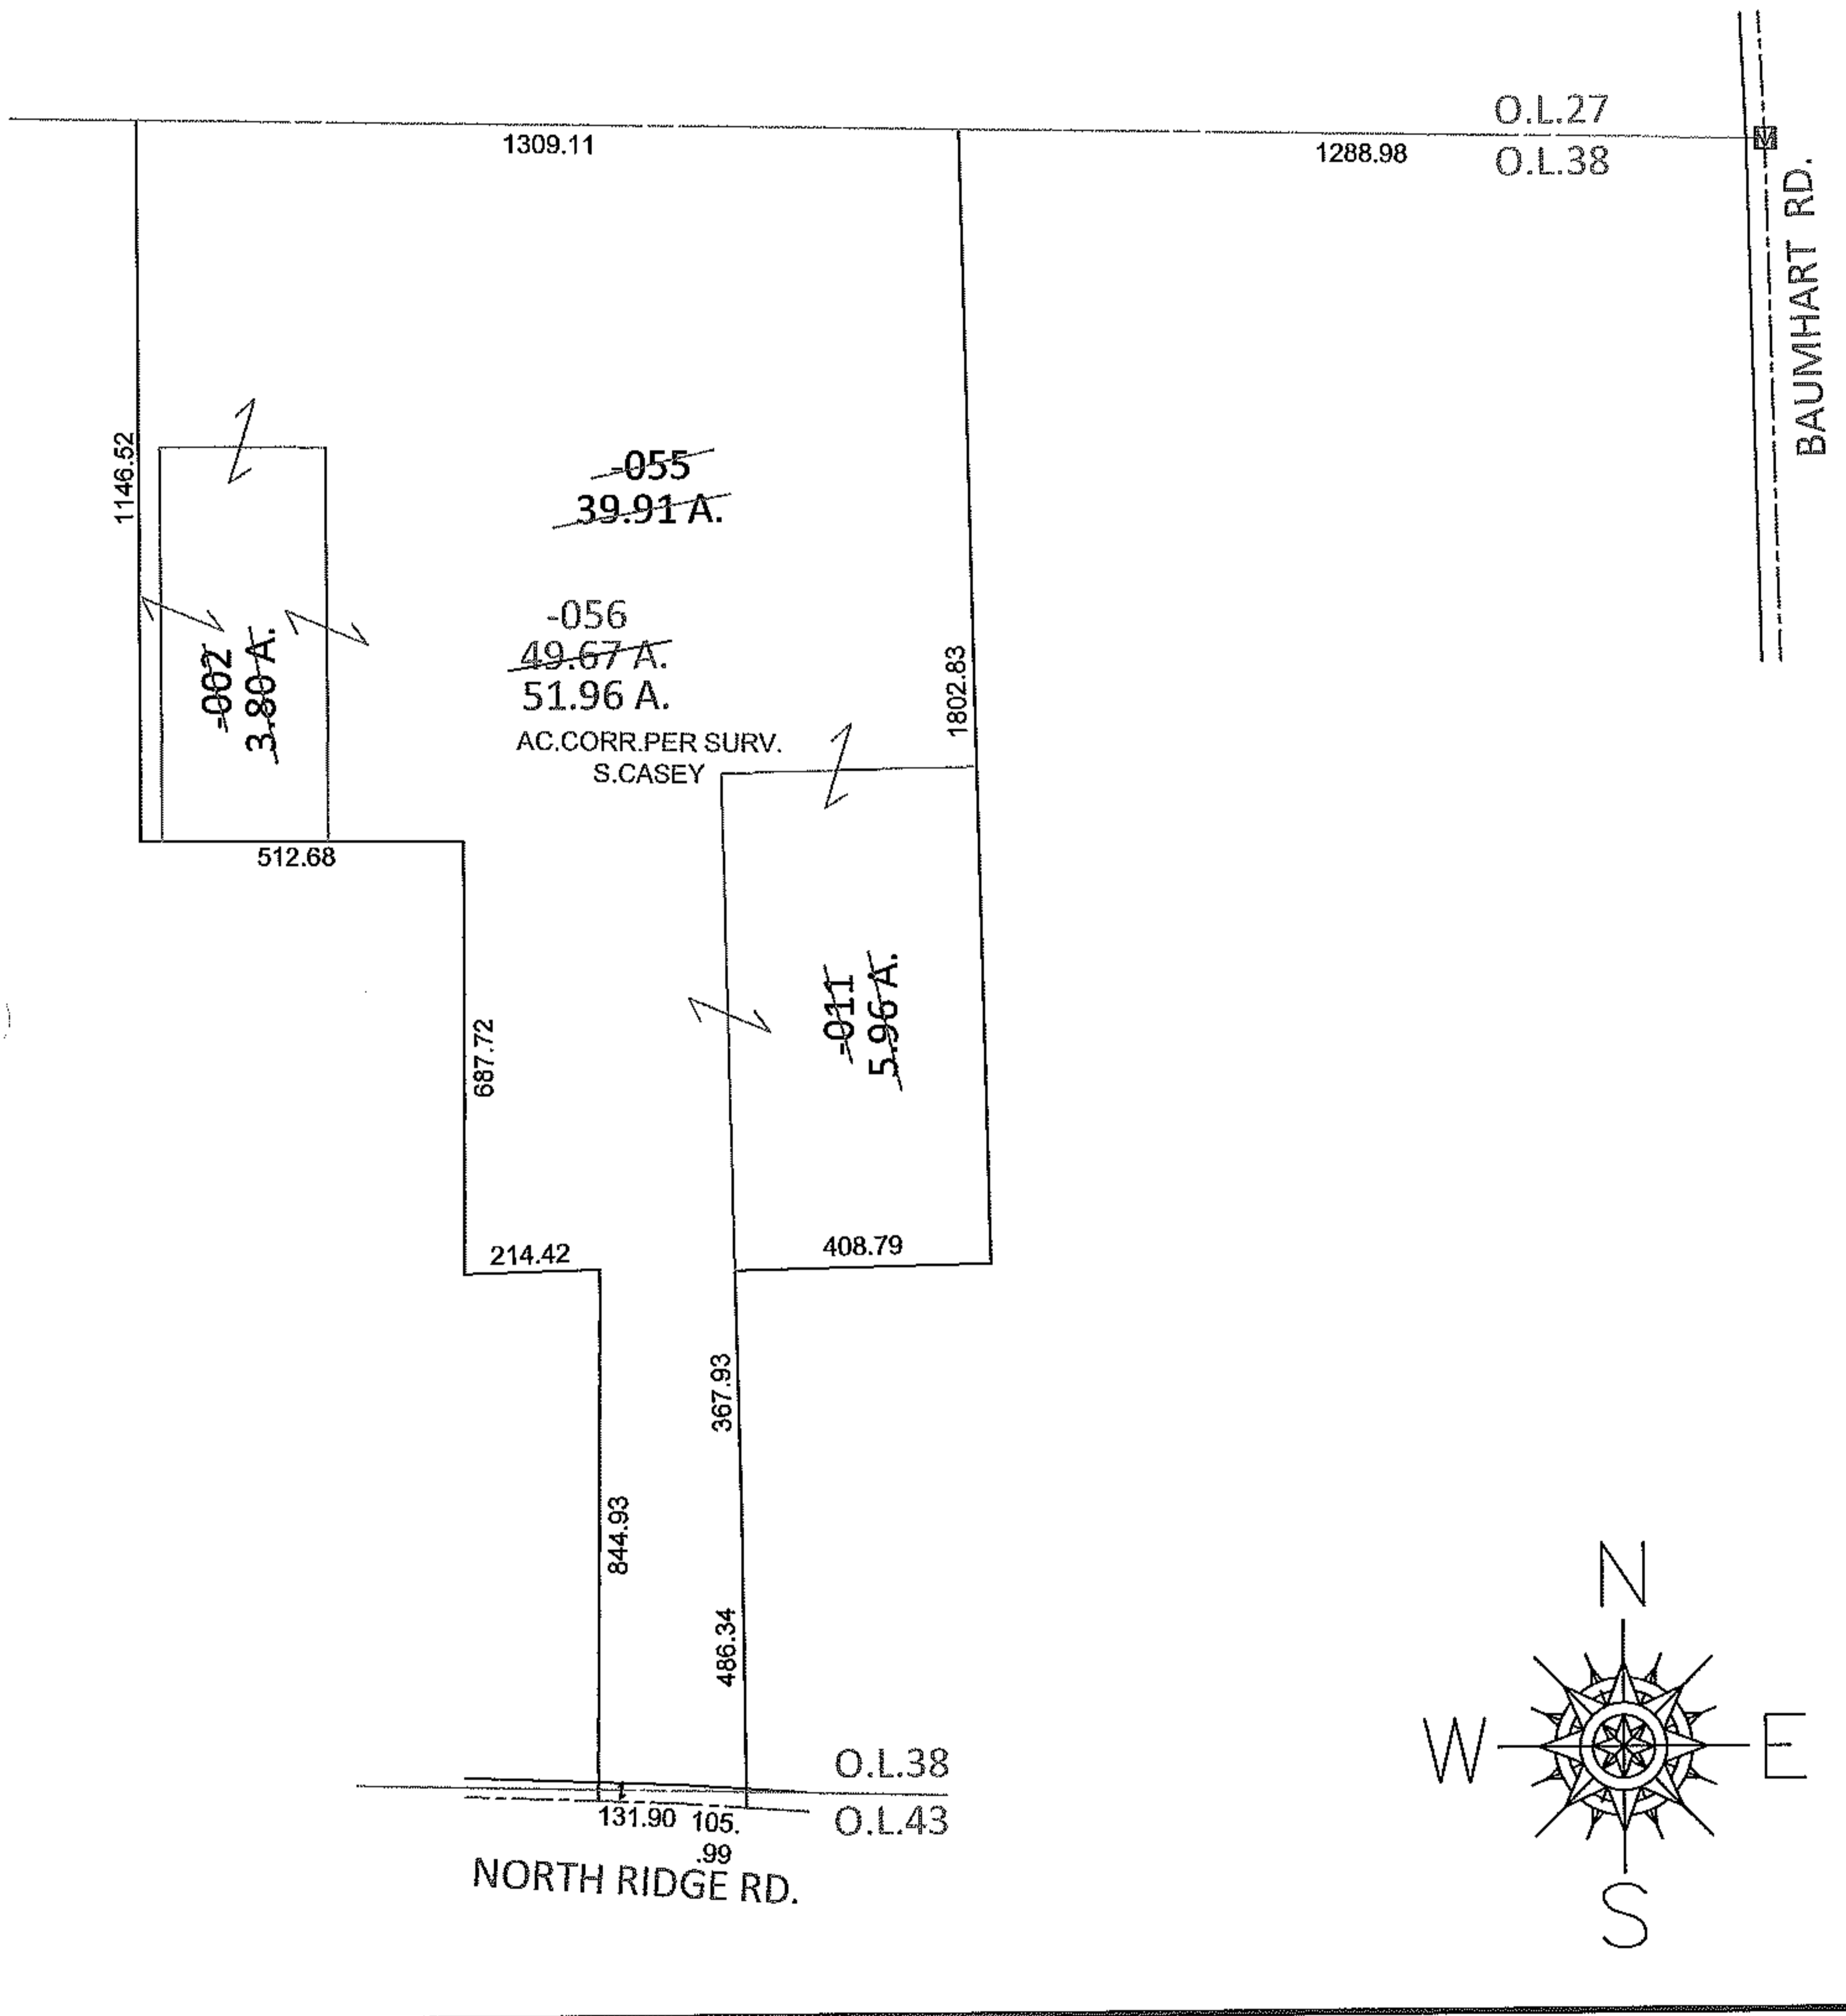

SPLITS/DEEDS PROCESSED

LORAIN COUNTY TAX MAP DEPARTMENT
226 MIDDLE AVE. ELYRIA, OHIO

SURVEYED BY: SCOTT J. CASEY
 CLOSURE: .01:10,000
 MAP PAGE(S): 1-00-038-A - B
 APPROVED BY: RRM DATE: 1-31-12
 SCALE: 1"= 400 PRIOR INST.: OR 794/896