
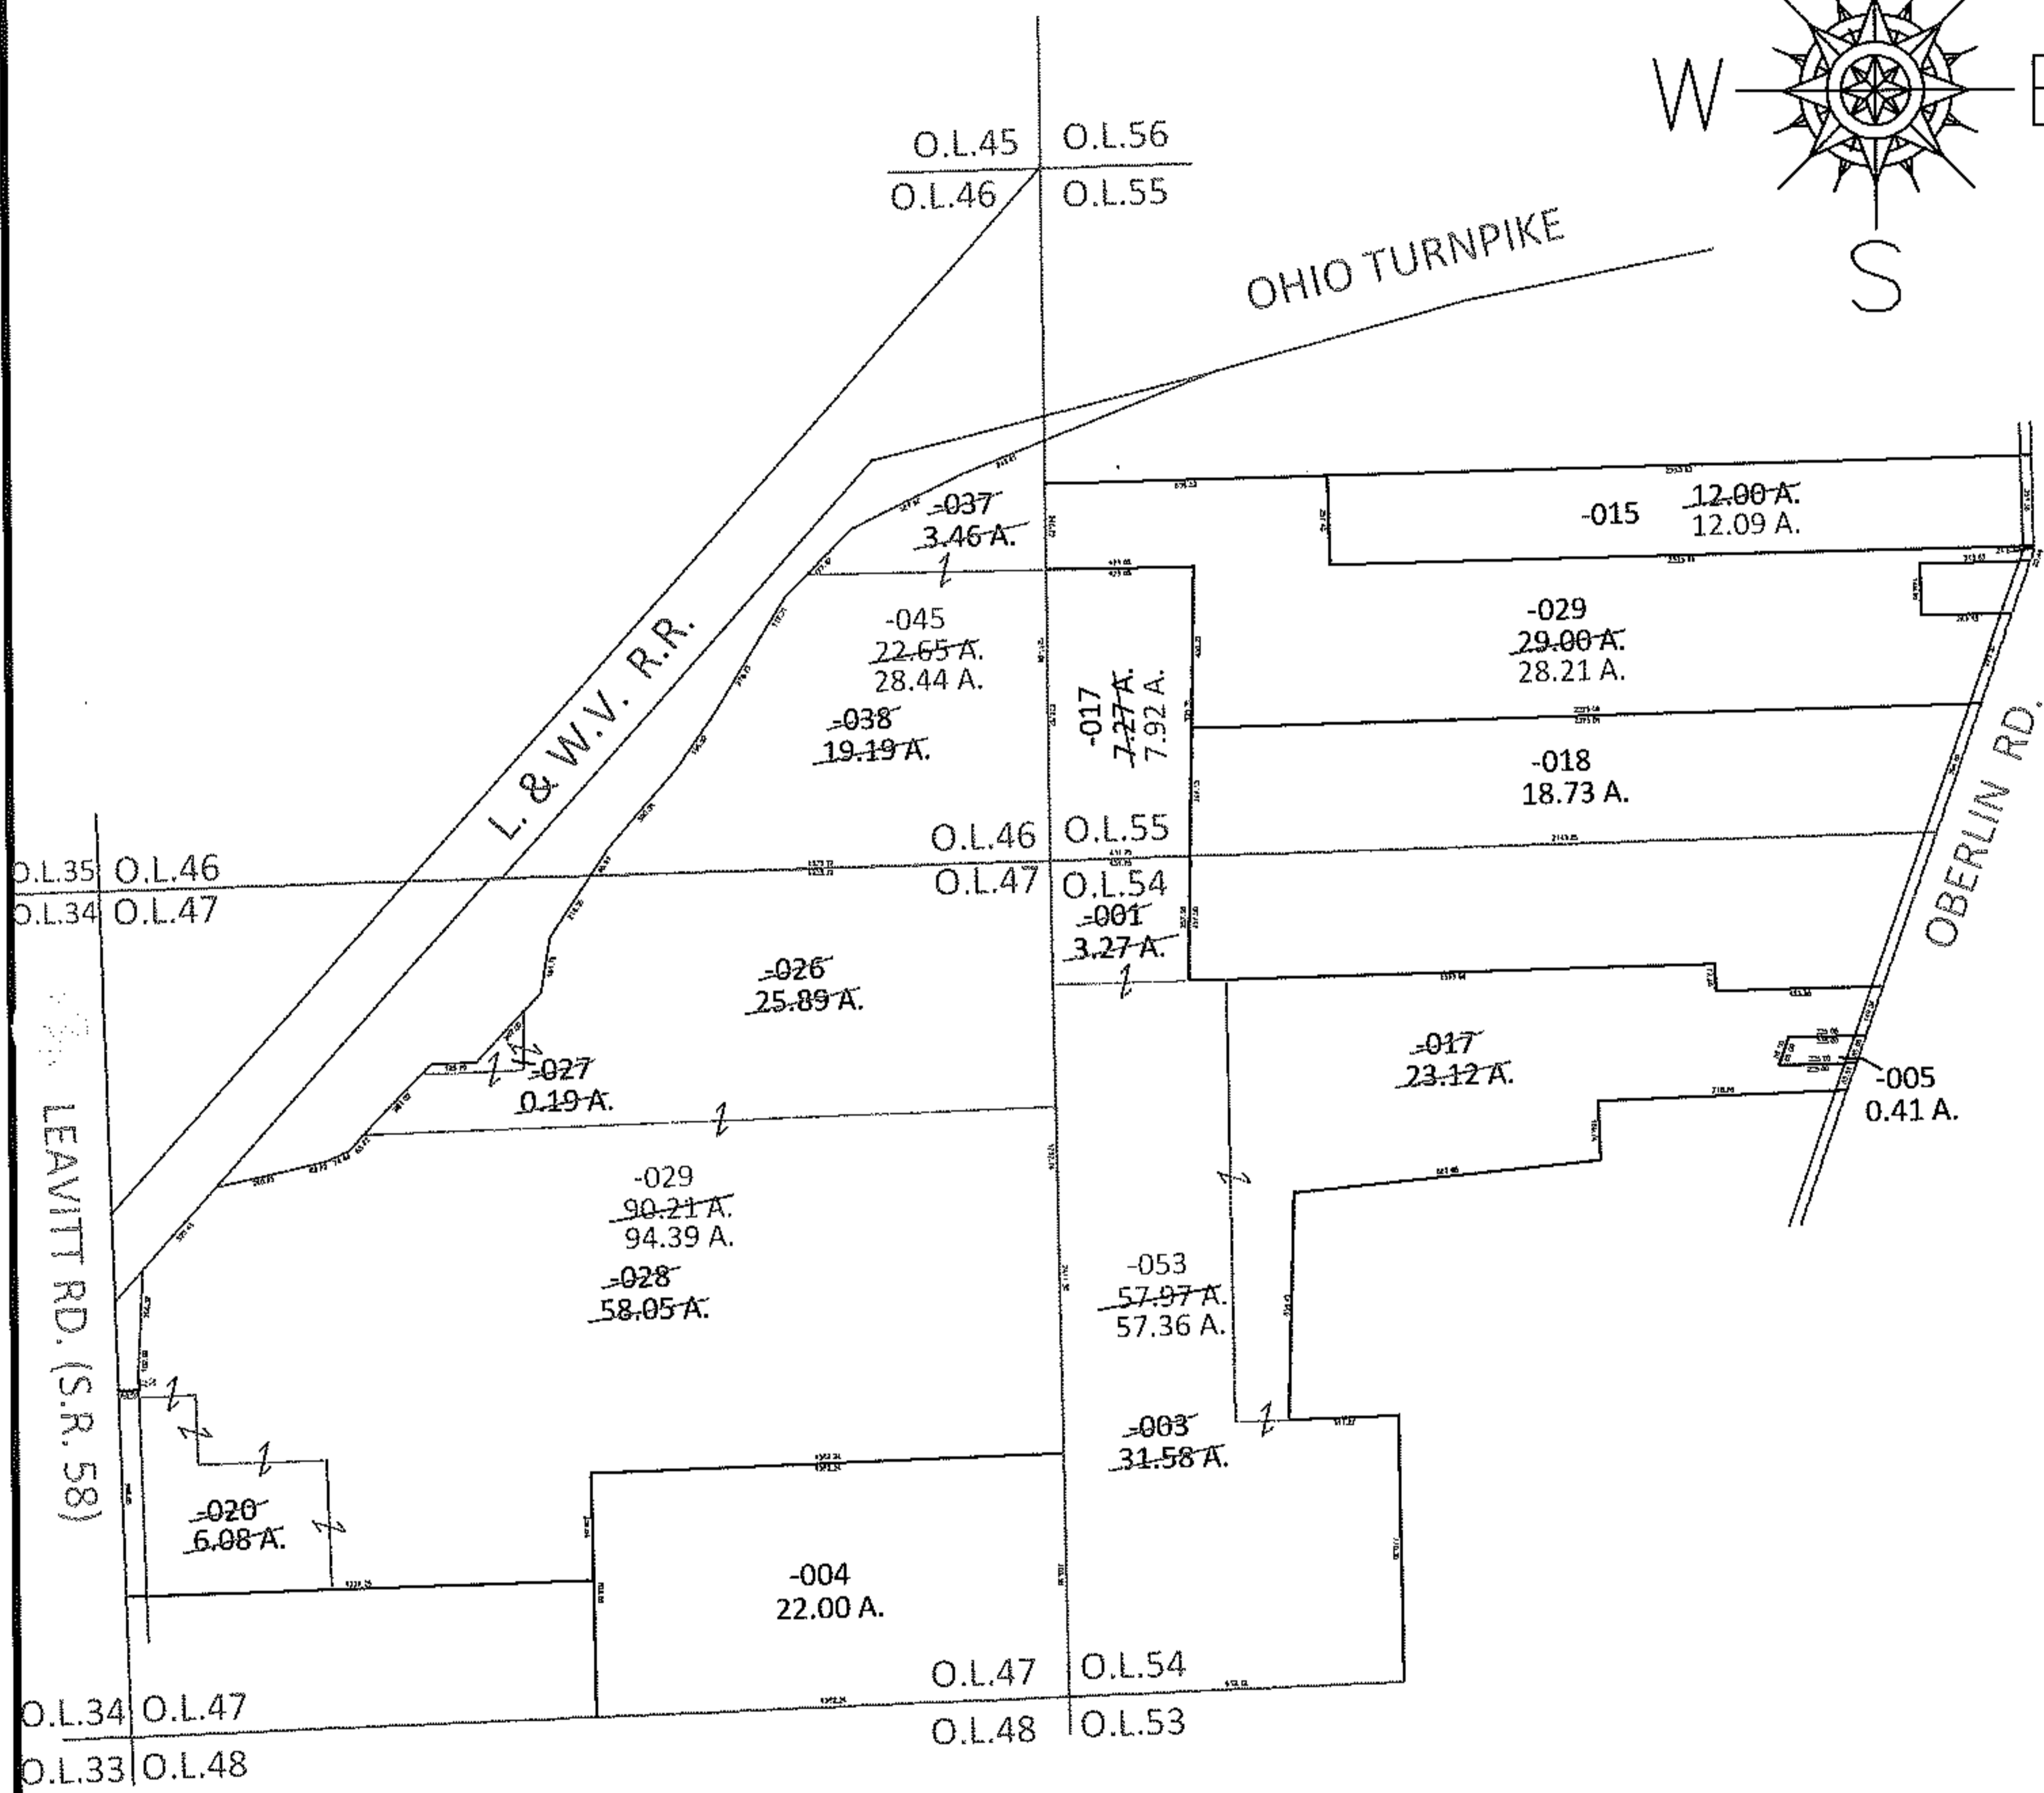


PARENT PARCEL: 05-00-046-000-037, -038, 05-00-047-000-004, -020, -026 THRU -028  
 05-00-054-000-001, -003, -005, -017, 05-00-055-000-015, -017, -018, -029


CHILD PARCEL: 05-00-046-000-045, 05-00-047-000-029, 05-00-054-000-053

STARTING POINT: NORTHEAST CORNER OF O.L.47

12-02995

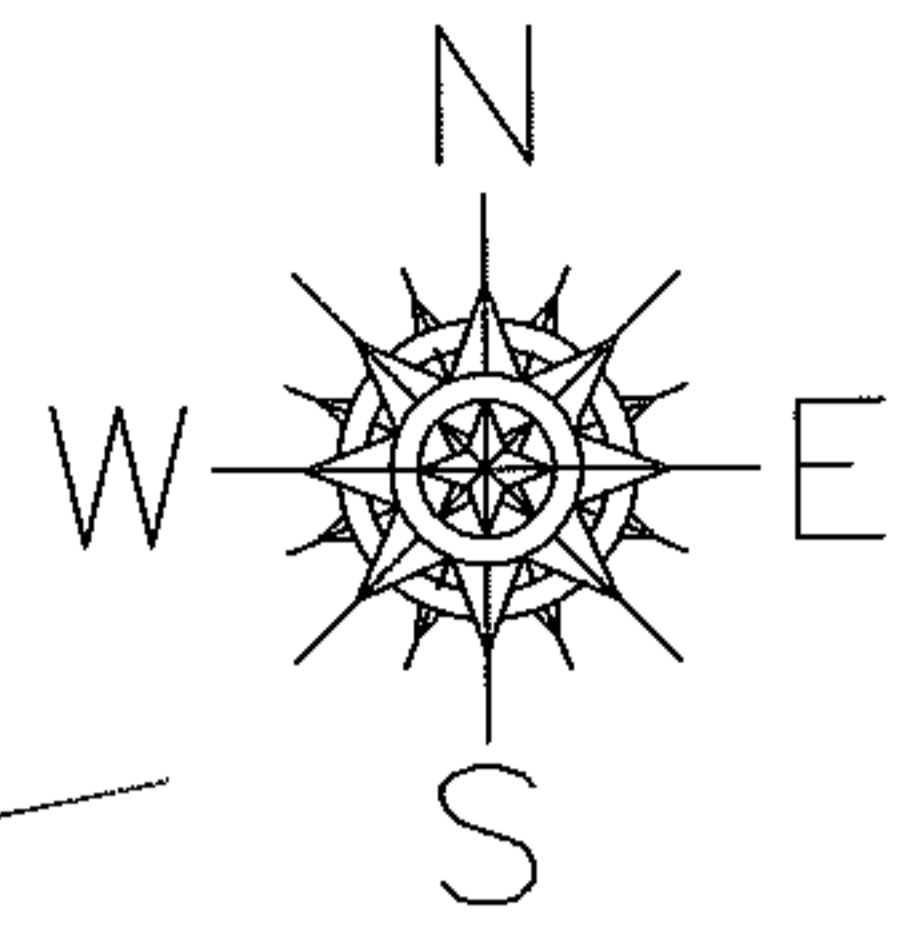

OR 1256/678  
 OR 573/236

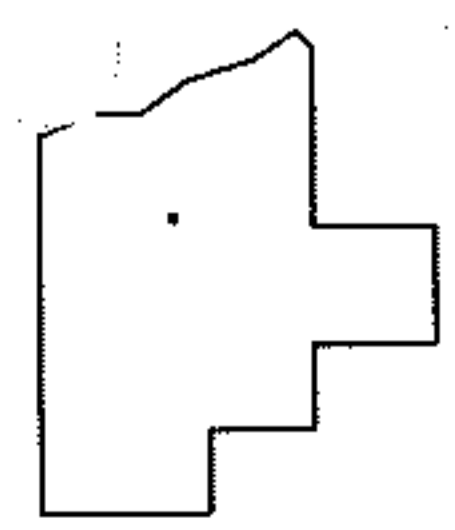

**SPLITS/DEEDS PROCESSED**

LORAIN COUNTY TAX MAP DEPARTMENT  
 226 MIDDLE AVE. ELYRIA, OHIO

SURVEYED BY: AMY M. KELLY  
 CLOSURE: .01:10,000  
 MAP PAGE(S): 5-G  
 APPROVED BY: RRM DATE: 2-3-12  
 SCALE: 1"=800 PRIOR INST.: \*SEE ABOVE