


PARENT PARCEL: 11-00-055-000-055



CHILD PARCEL: XX-XX-XXX-XXX-XXX

STARTING POINT: MAG. NAIL FD., CL OF GILES RD. & CL OF ELYRIA-TWINSBURG RD.

14-02996-A

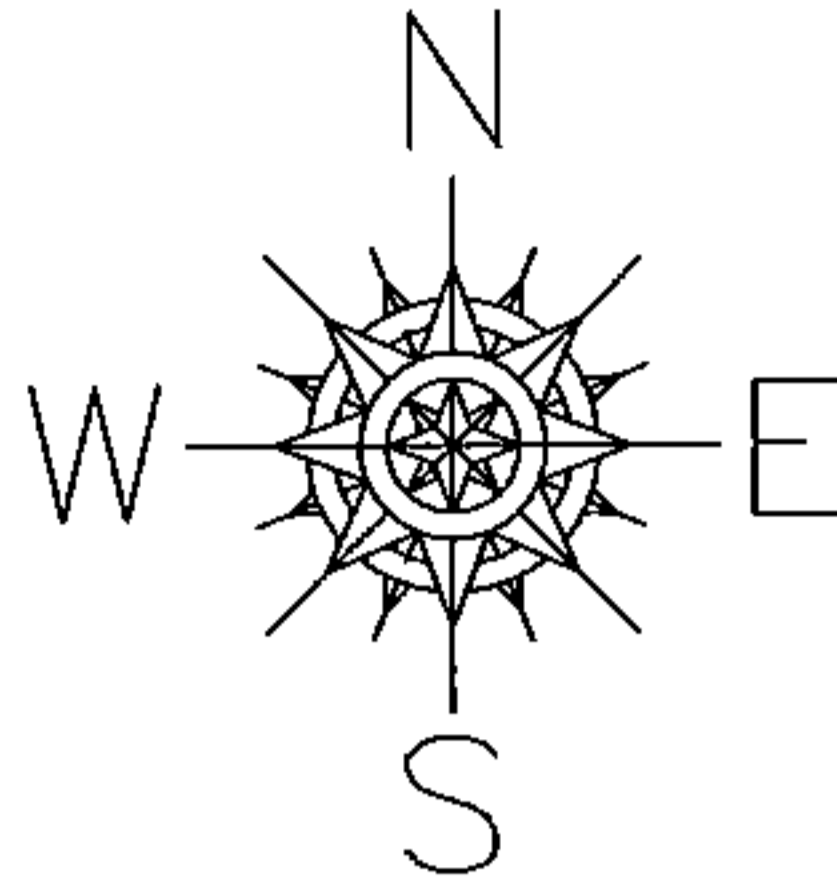

MAP CORRECTION ONLY

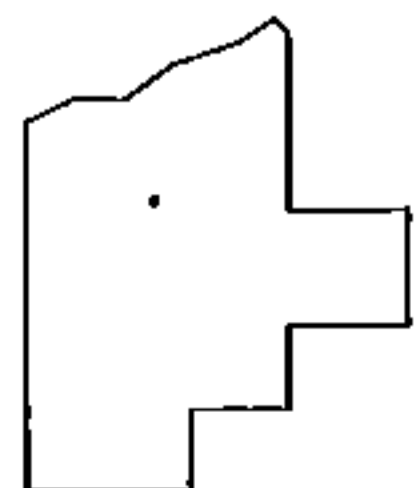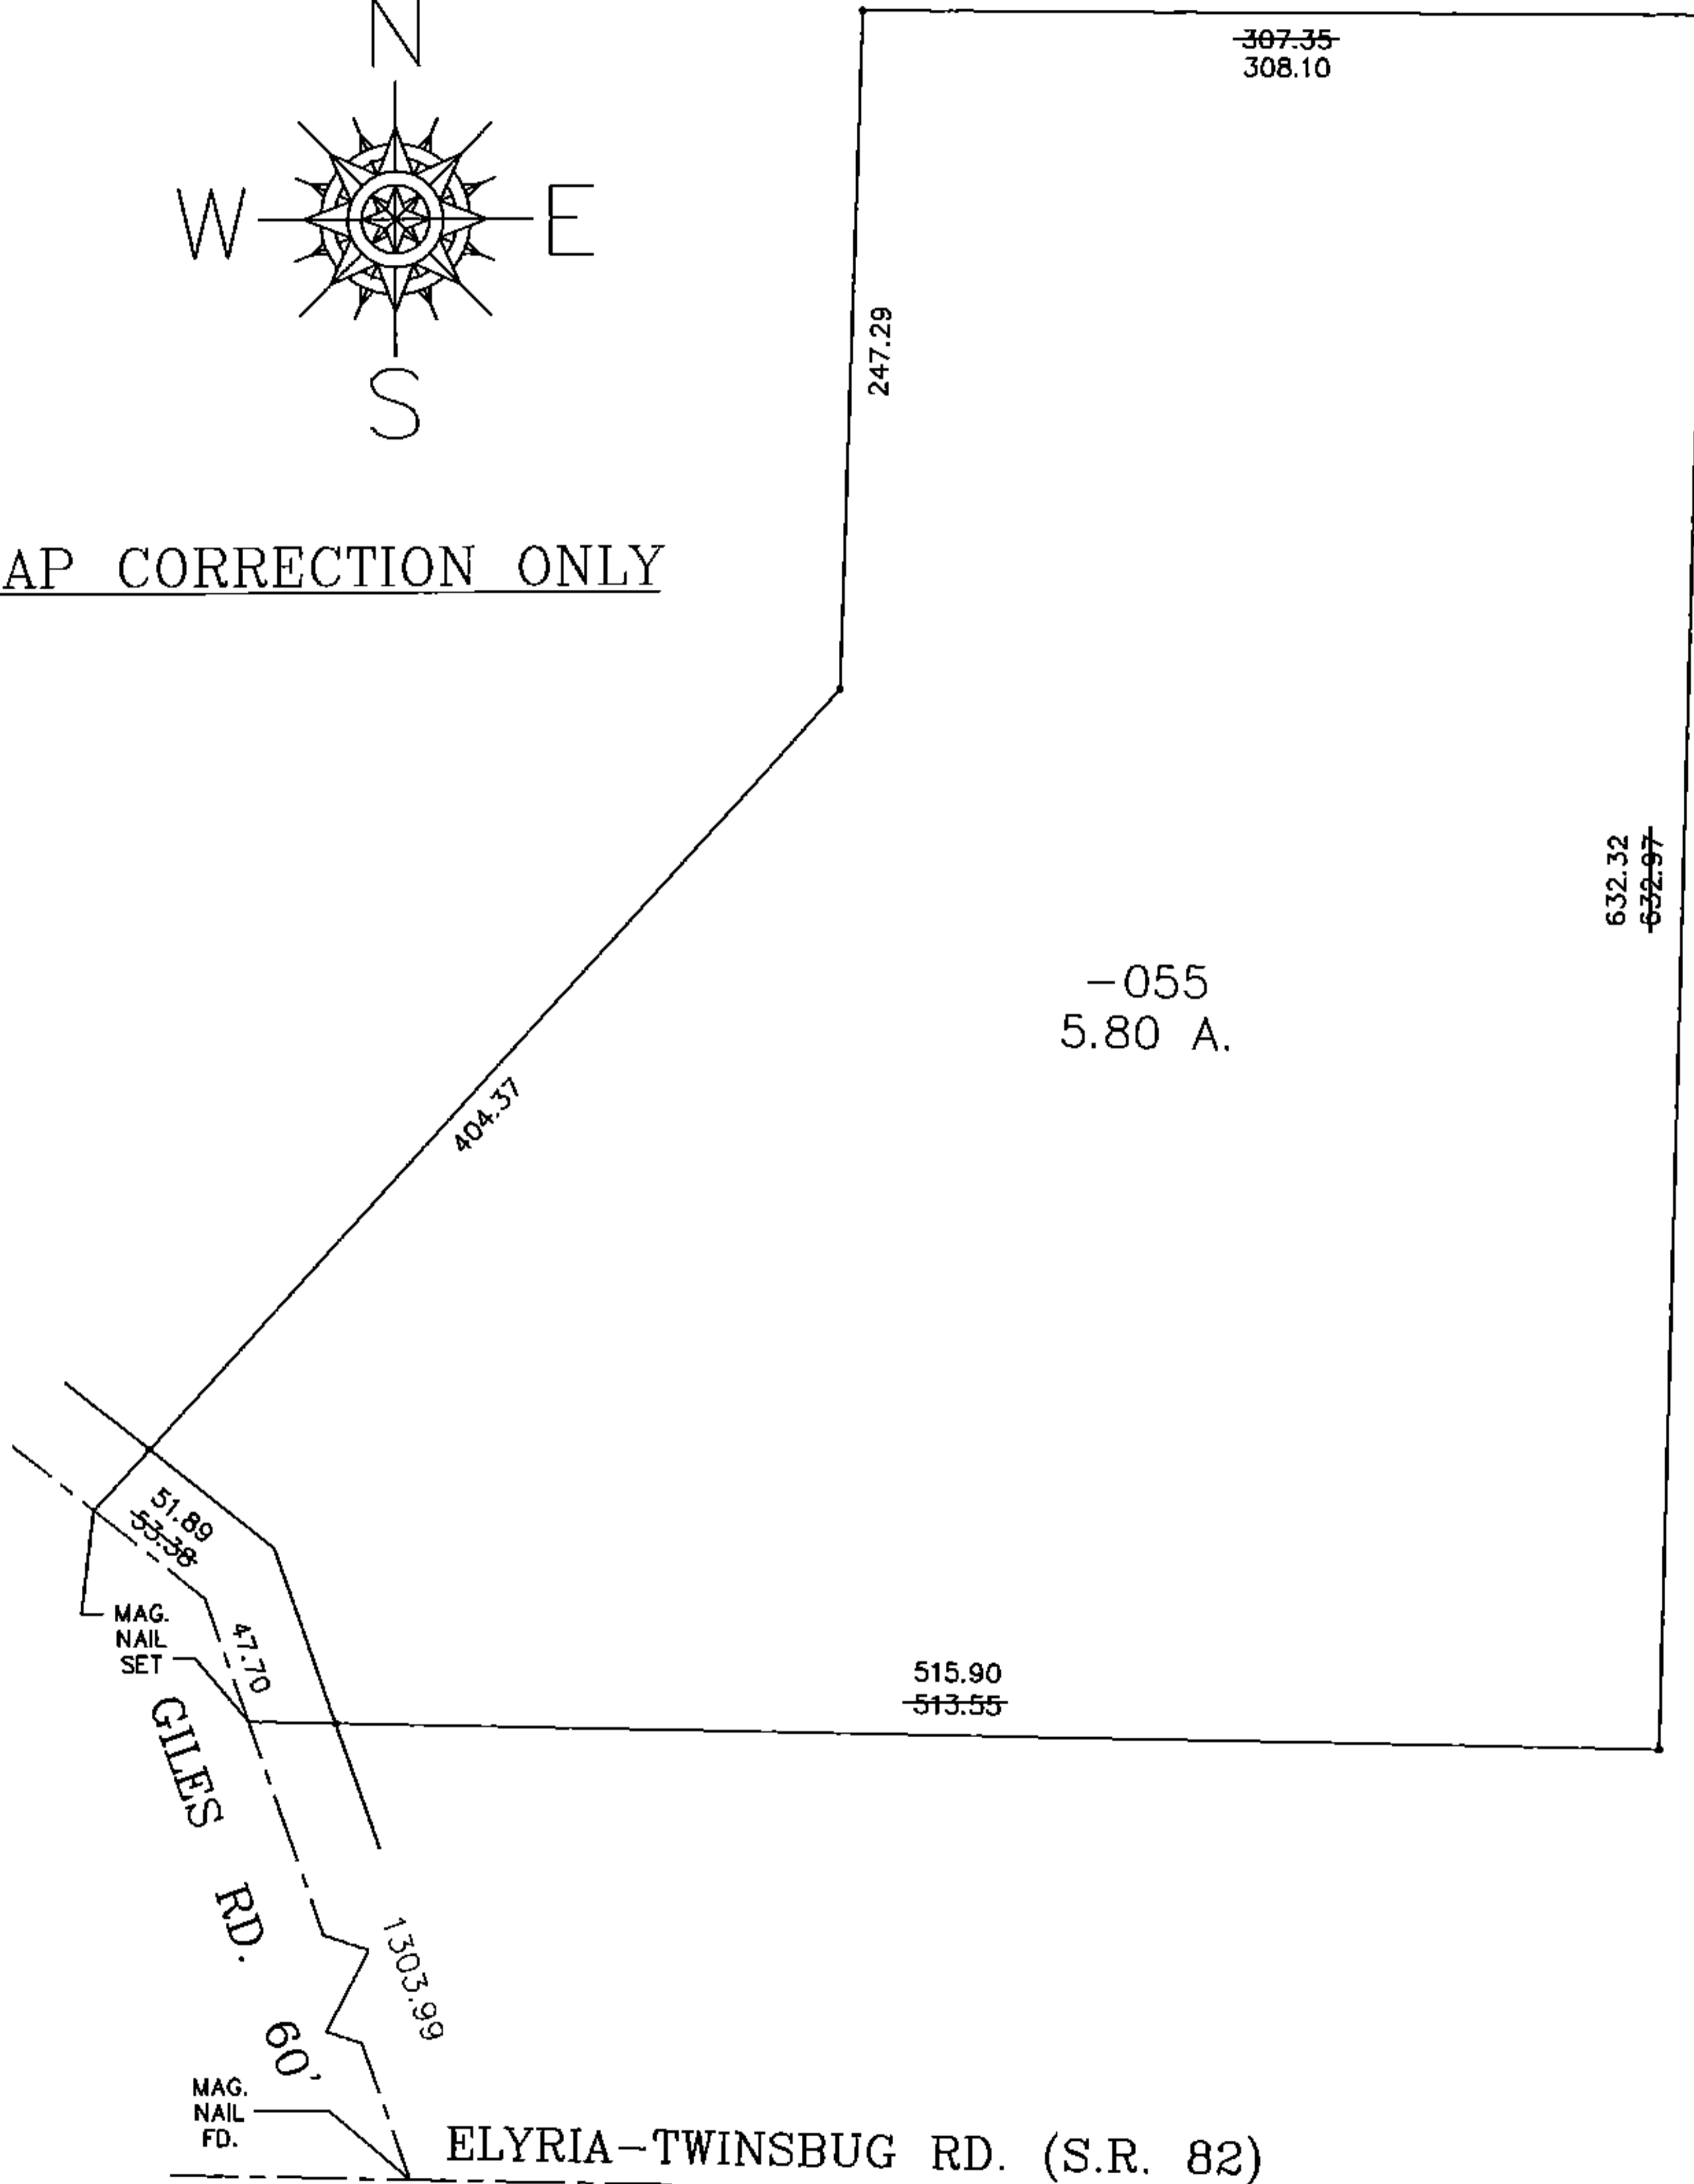

SPLITS/DEEDS PROCESSED

LORAIN COUNTY TAX MAP DEPARTMENT
226 MIDDLE AVE. ELYRIA, OHIO

SURVEYED BY: WILLIAM R. WALLACE

CLOSURE: 0.01 : 10,000

MAP PAGE(S): 11-B

APPROVED BY: TJS DATE: 8/15/14

SCALE: 1"= 100 PRIOR INST.: 20130486064