

PARENT PARCEL: 16-00-010-000-045, -046


CHILD PARCEL: 16-00-010-000-049

STARTING POINT: NORTHWESTERLY CORNER OF O.L. 10 & O.L. 9

12-02996

CROCKER RD

378.70

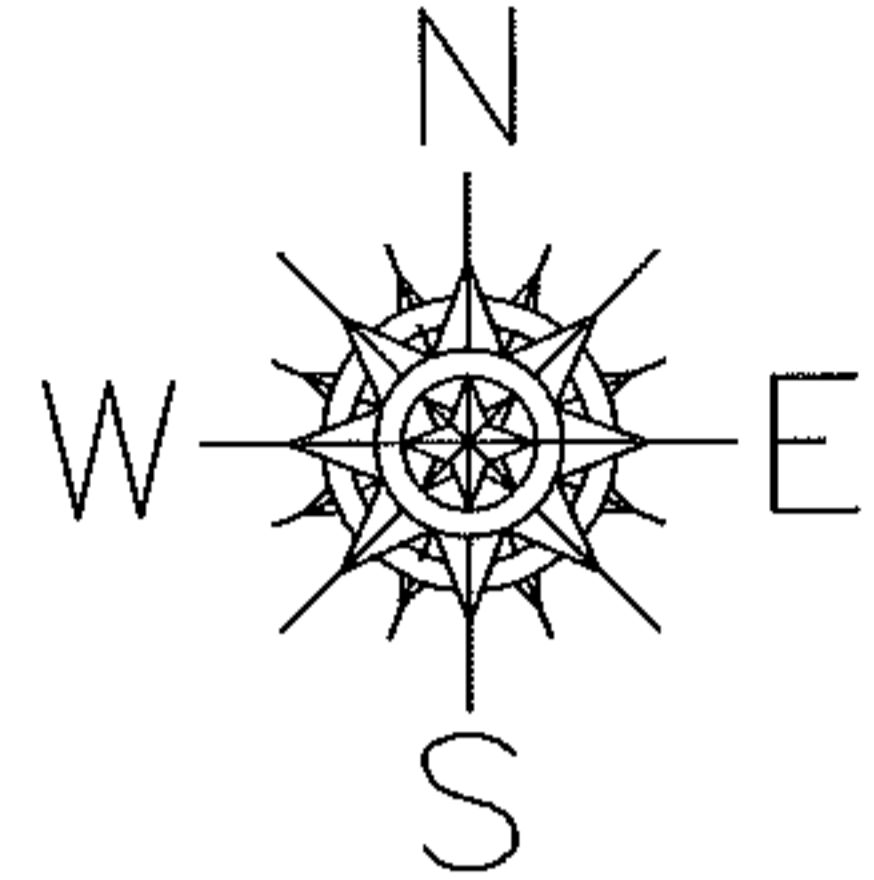

~~-045~~
~~3.21 A.~~

-049
5.37 A.

~~-046~~
~~2.16 A.~~

632.58

COWLEY RD


567.45

1

108.30

63.93

274.36

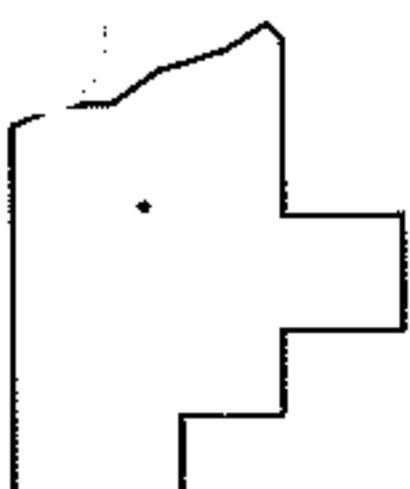

SPLITS/DEEDS PROCESSED

LORAIN COUNTY TAX MAP DEPARTMENT
226 MIDDLE AVE. ELYRIA, OHIO

SURVEYED BY: RICHARD CARLSON

CLOSURE: 0.00 : 10.000

MAP PAGE(S): 16-D

APPROVED BY: JAH DATE: 2/8/2012

SCALE: 1" = 100 PRIOR INSTRUMENT: 20060152300