
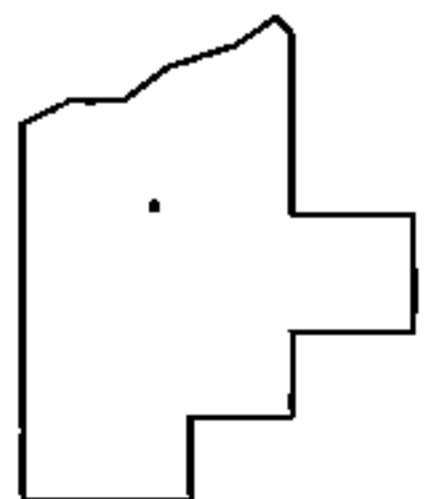
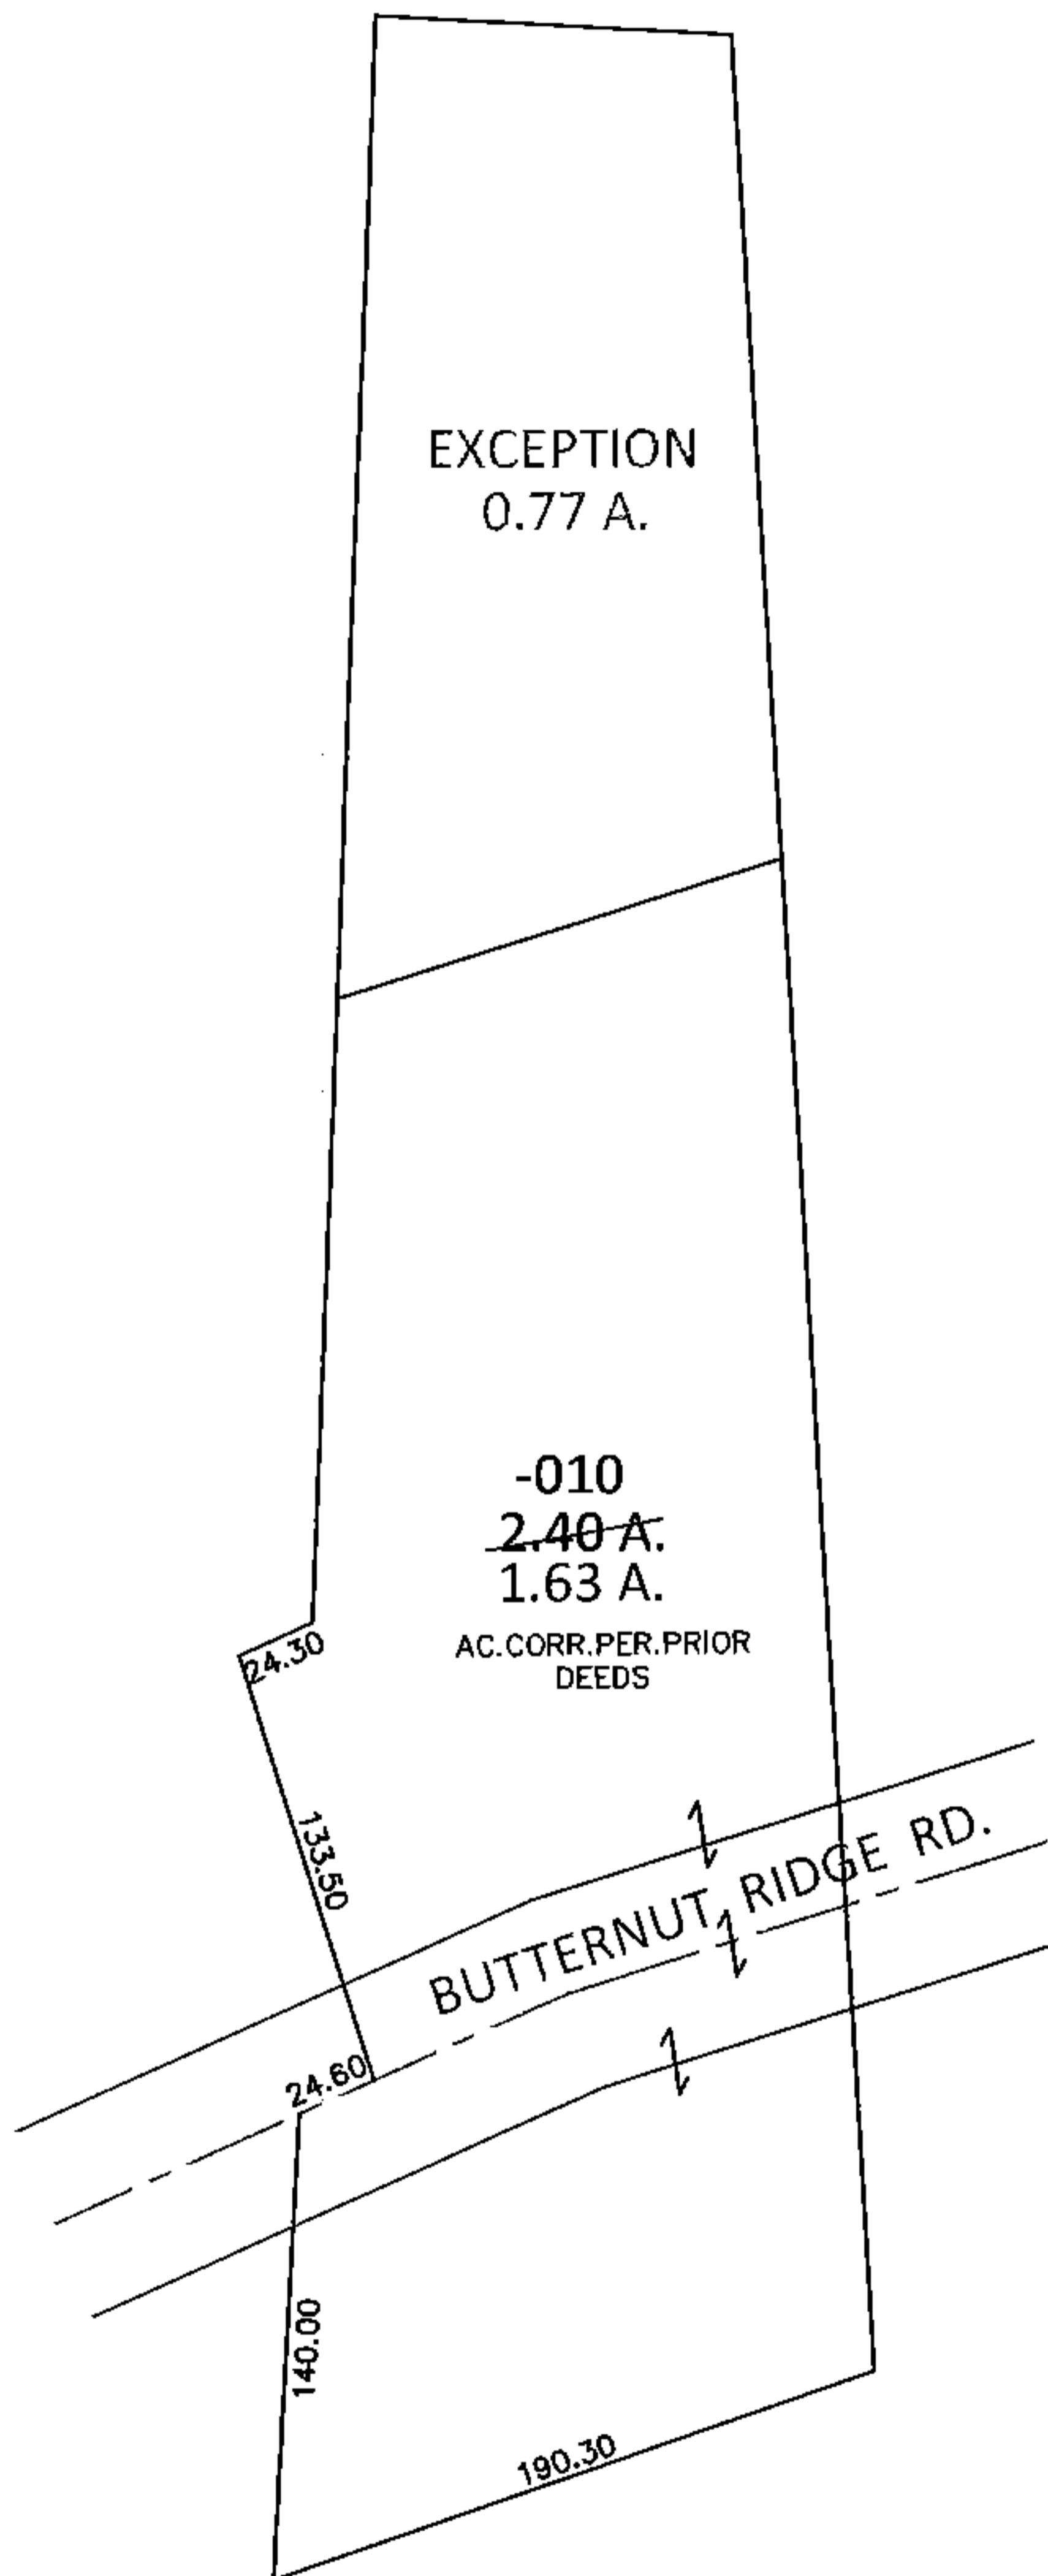


PARENT PARCEL: 10-00-006-118-010

CHILD PARCEL: _____

STARTING POINT: C/L OF BUTTERNUT RIDGE RD. AND NORTHEAST CORNER OF JOHN KOTHMAYER (DV 330/241)

14-02998-A

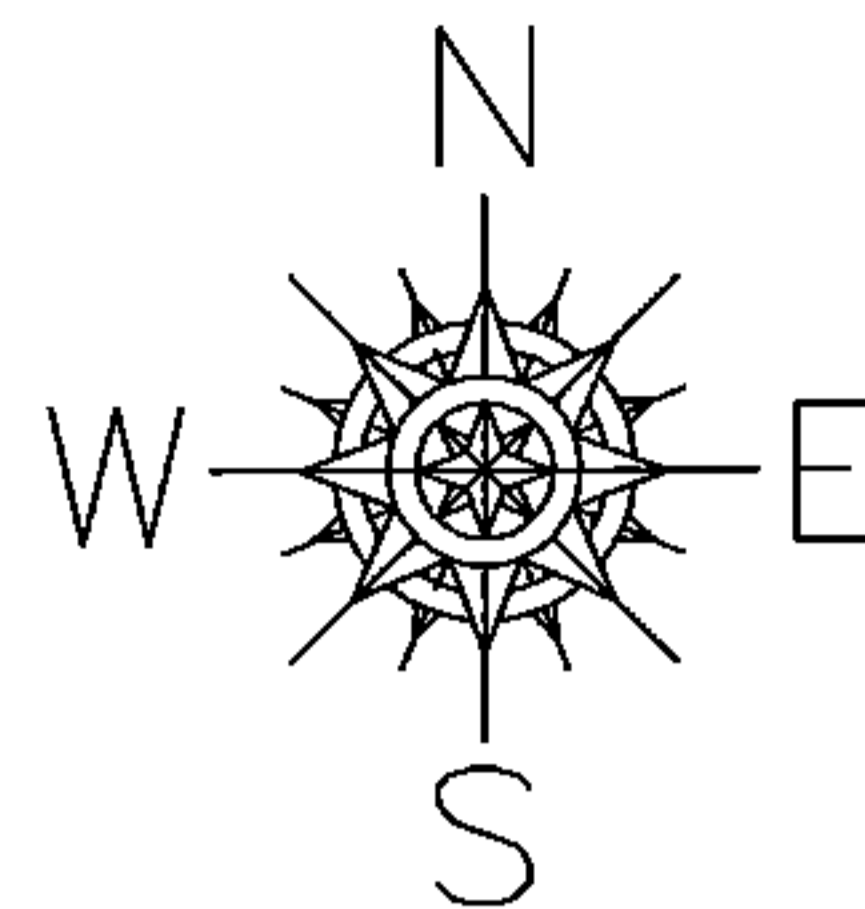

SPLITS/DEEDS PROCESSED

LORAIN COUNTY TAX MAP DEPARTMENT
226 MIDDLE AVE. ELYRIA, OHIO

SURVEYED BY: N/A

CLOSURE: 1:7093

MAP PAGE(S): 10-00-006-E

APPROVED BY: RRM DATE: 4-13-15

SCALE: 1"=100 PRIOR INST.: 19980556518