

PARENT PARCEL: 14-00-009-000-005

CHILD PARCEL: SAME

STARTING POINT: CENTERLINE OF QUARRY RD & O.L. 9

14-02999-A

RD

130.00

465.00
-005
~~1.32 A.~~
1.39 A.
A CORR SURVEY
DALE HAYWOOD

130.00



465.00

540.30

QUARRY

O.L. 9

O.L. 12

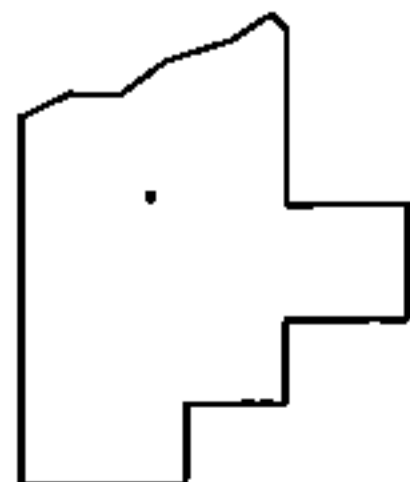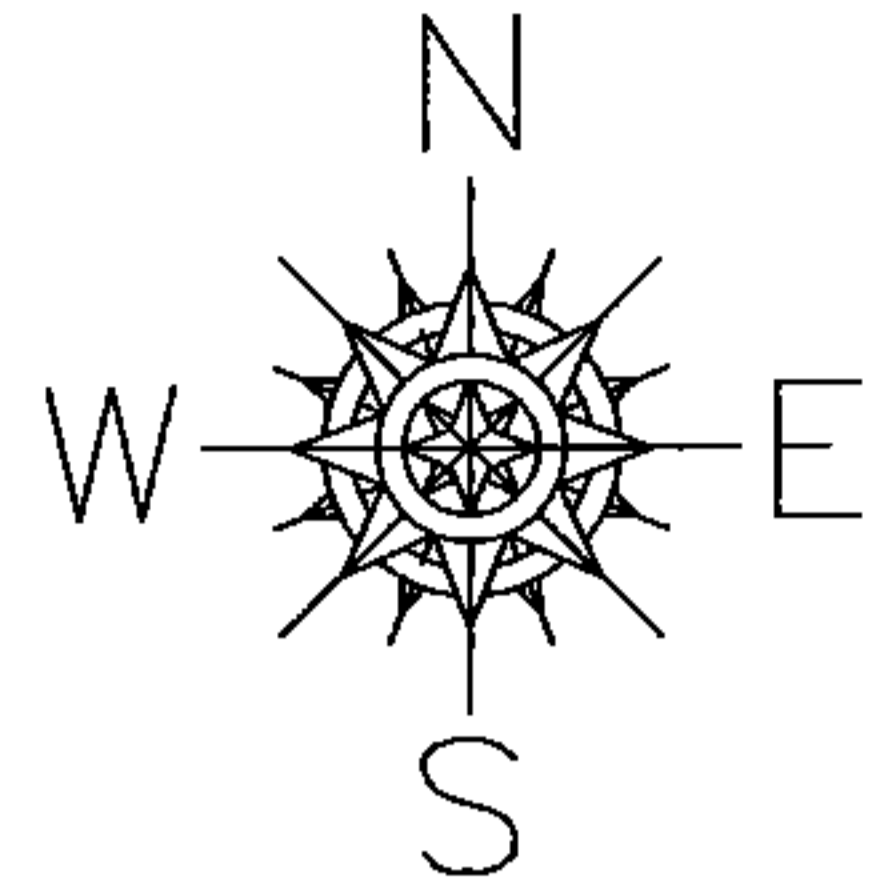

SPLITS/DEEDS PROCESSED

LORAIN COUNTY TAX MAP DEPARTMENT
226 MIDDLE AVE. ELYRIA, OHIO

SURVEYED BY: DALE HAYWOOD
CLOSURE: 0.00 : 10.000
MAP PAGE(S): 14-A
APPROVED BY: JAH DATE: 8/19/2014
SCALE: 1" = 100 PRIOR INSTRUMENT: 20130482121