
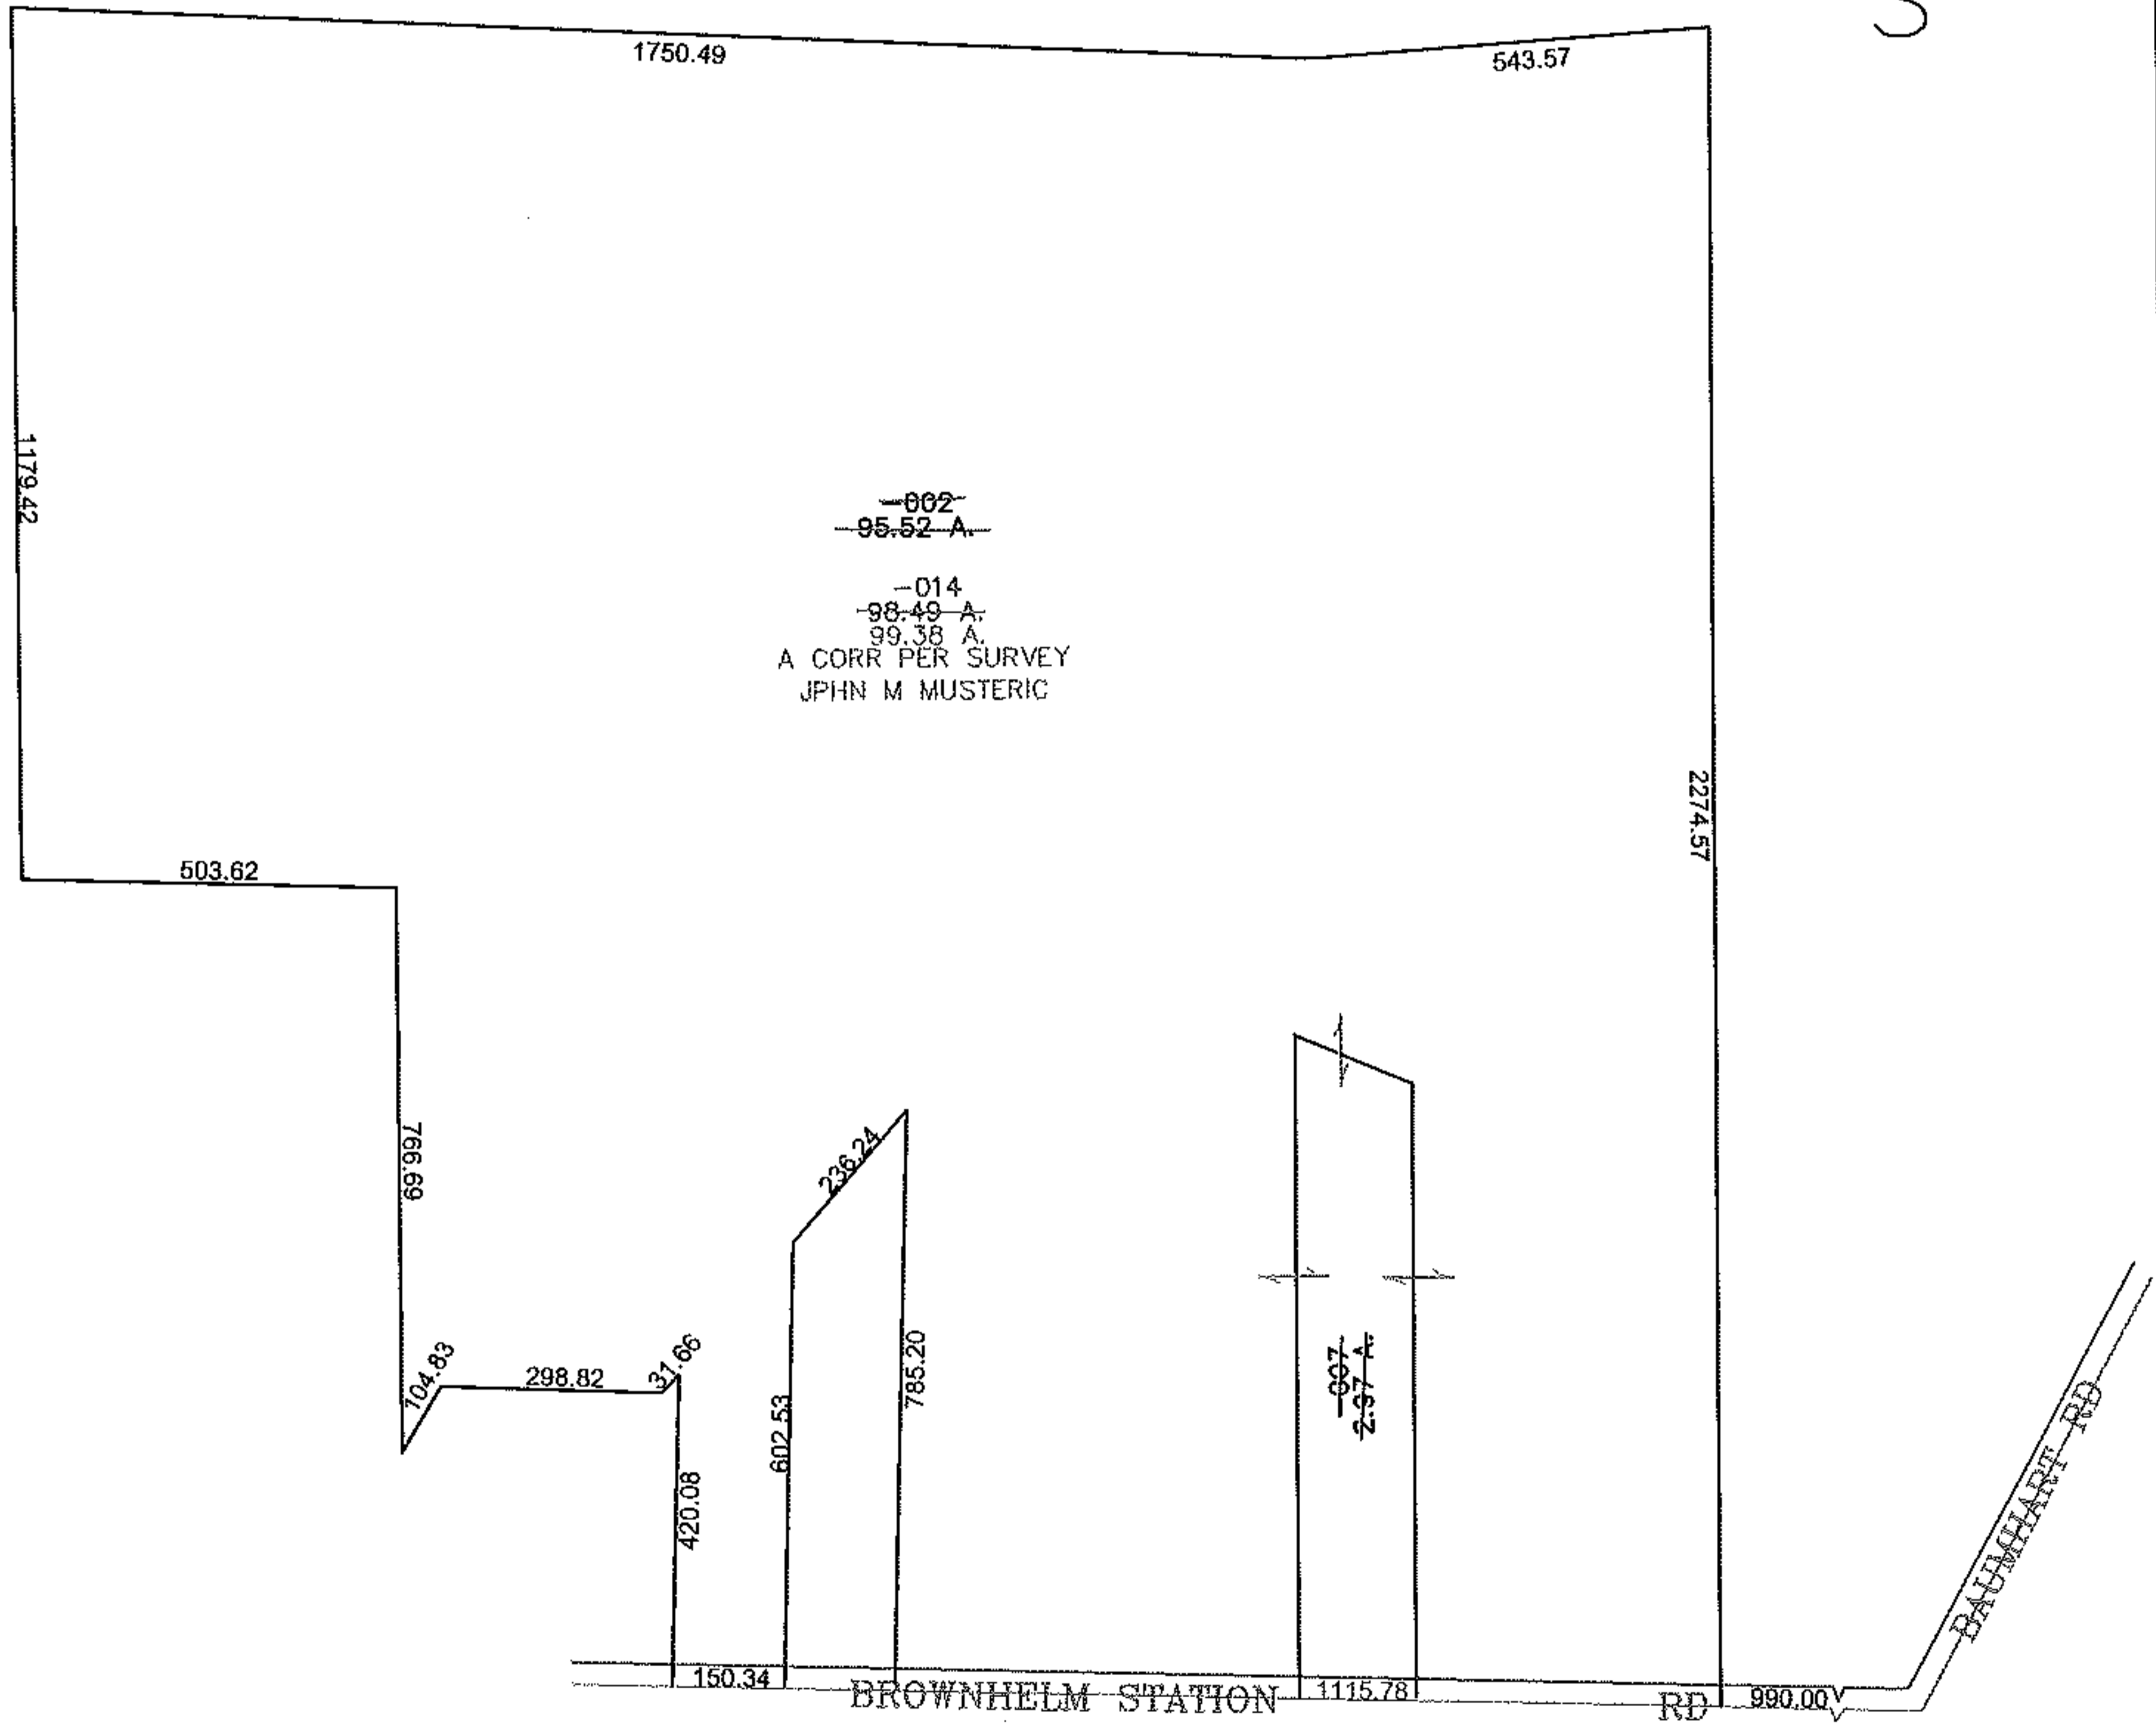


PARENT PARCEL: 01-00-011-000-002, -007

CHILD PARCEL: 01-00-011-000-014

STARTING POINT: CENTERLINE OF BROWNHELM STATION RD & BAUMHART RD

12-02999

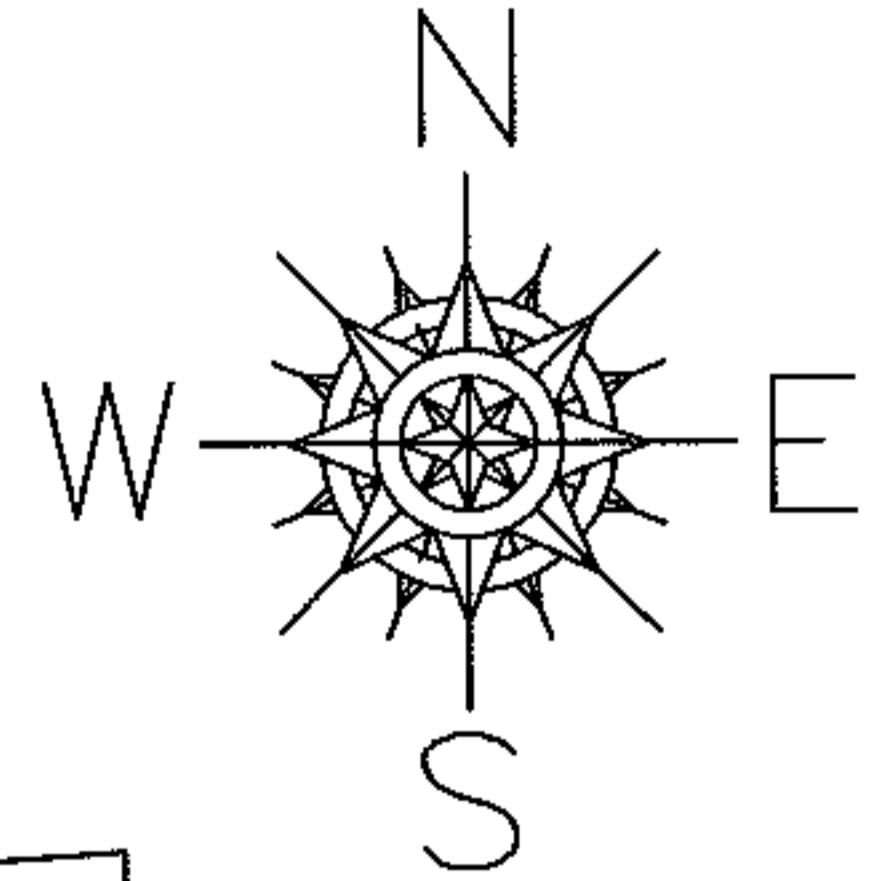

SPLITS/DEEDS PROCESSED

LORAIN COUNTY TAX MAP DEPARTMENT
226 MIDDLE AVE. ELYRIA, OHIO

SURVEYED BY: JOHN MUSTERIC

CLOSURE: 0.00 : 10.000

MAP PAGE(S): 01-00-011-B

APPROVED BY: JAH DATE: 2/16/2012

SCALE: 1" = 400 PRIOR INSTRUMENT: 20070216819