
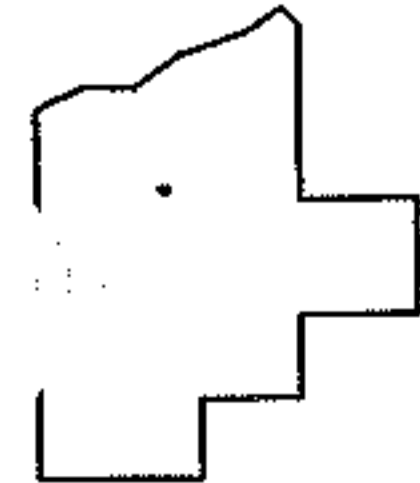


PARENT PARCEL: 03-00-039-118-061

CHILD PARCEL: 03-00-039-118-076, -077

STARTING POINT: SIDELINE OF HOLLYWOOD AVE. & FERNDALE AVE.

NO. 00005

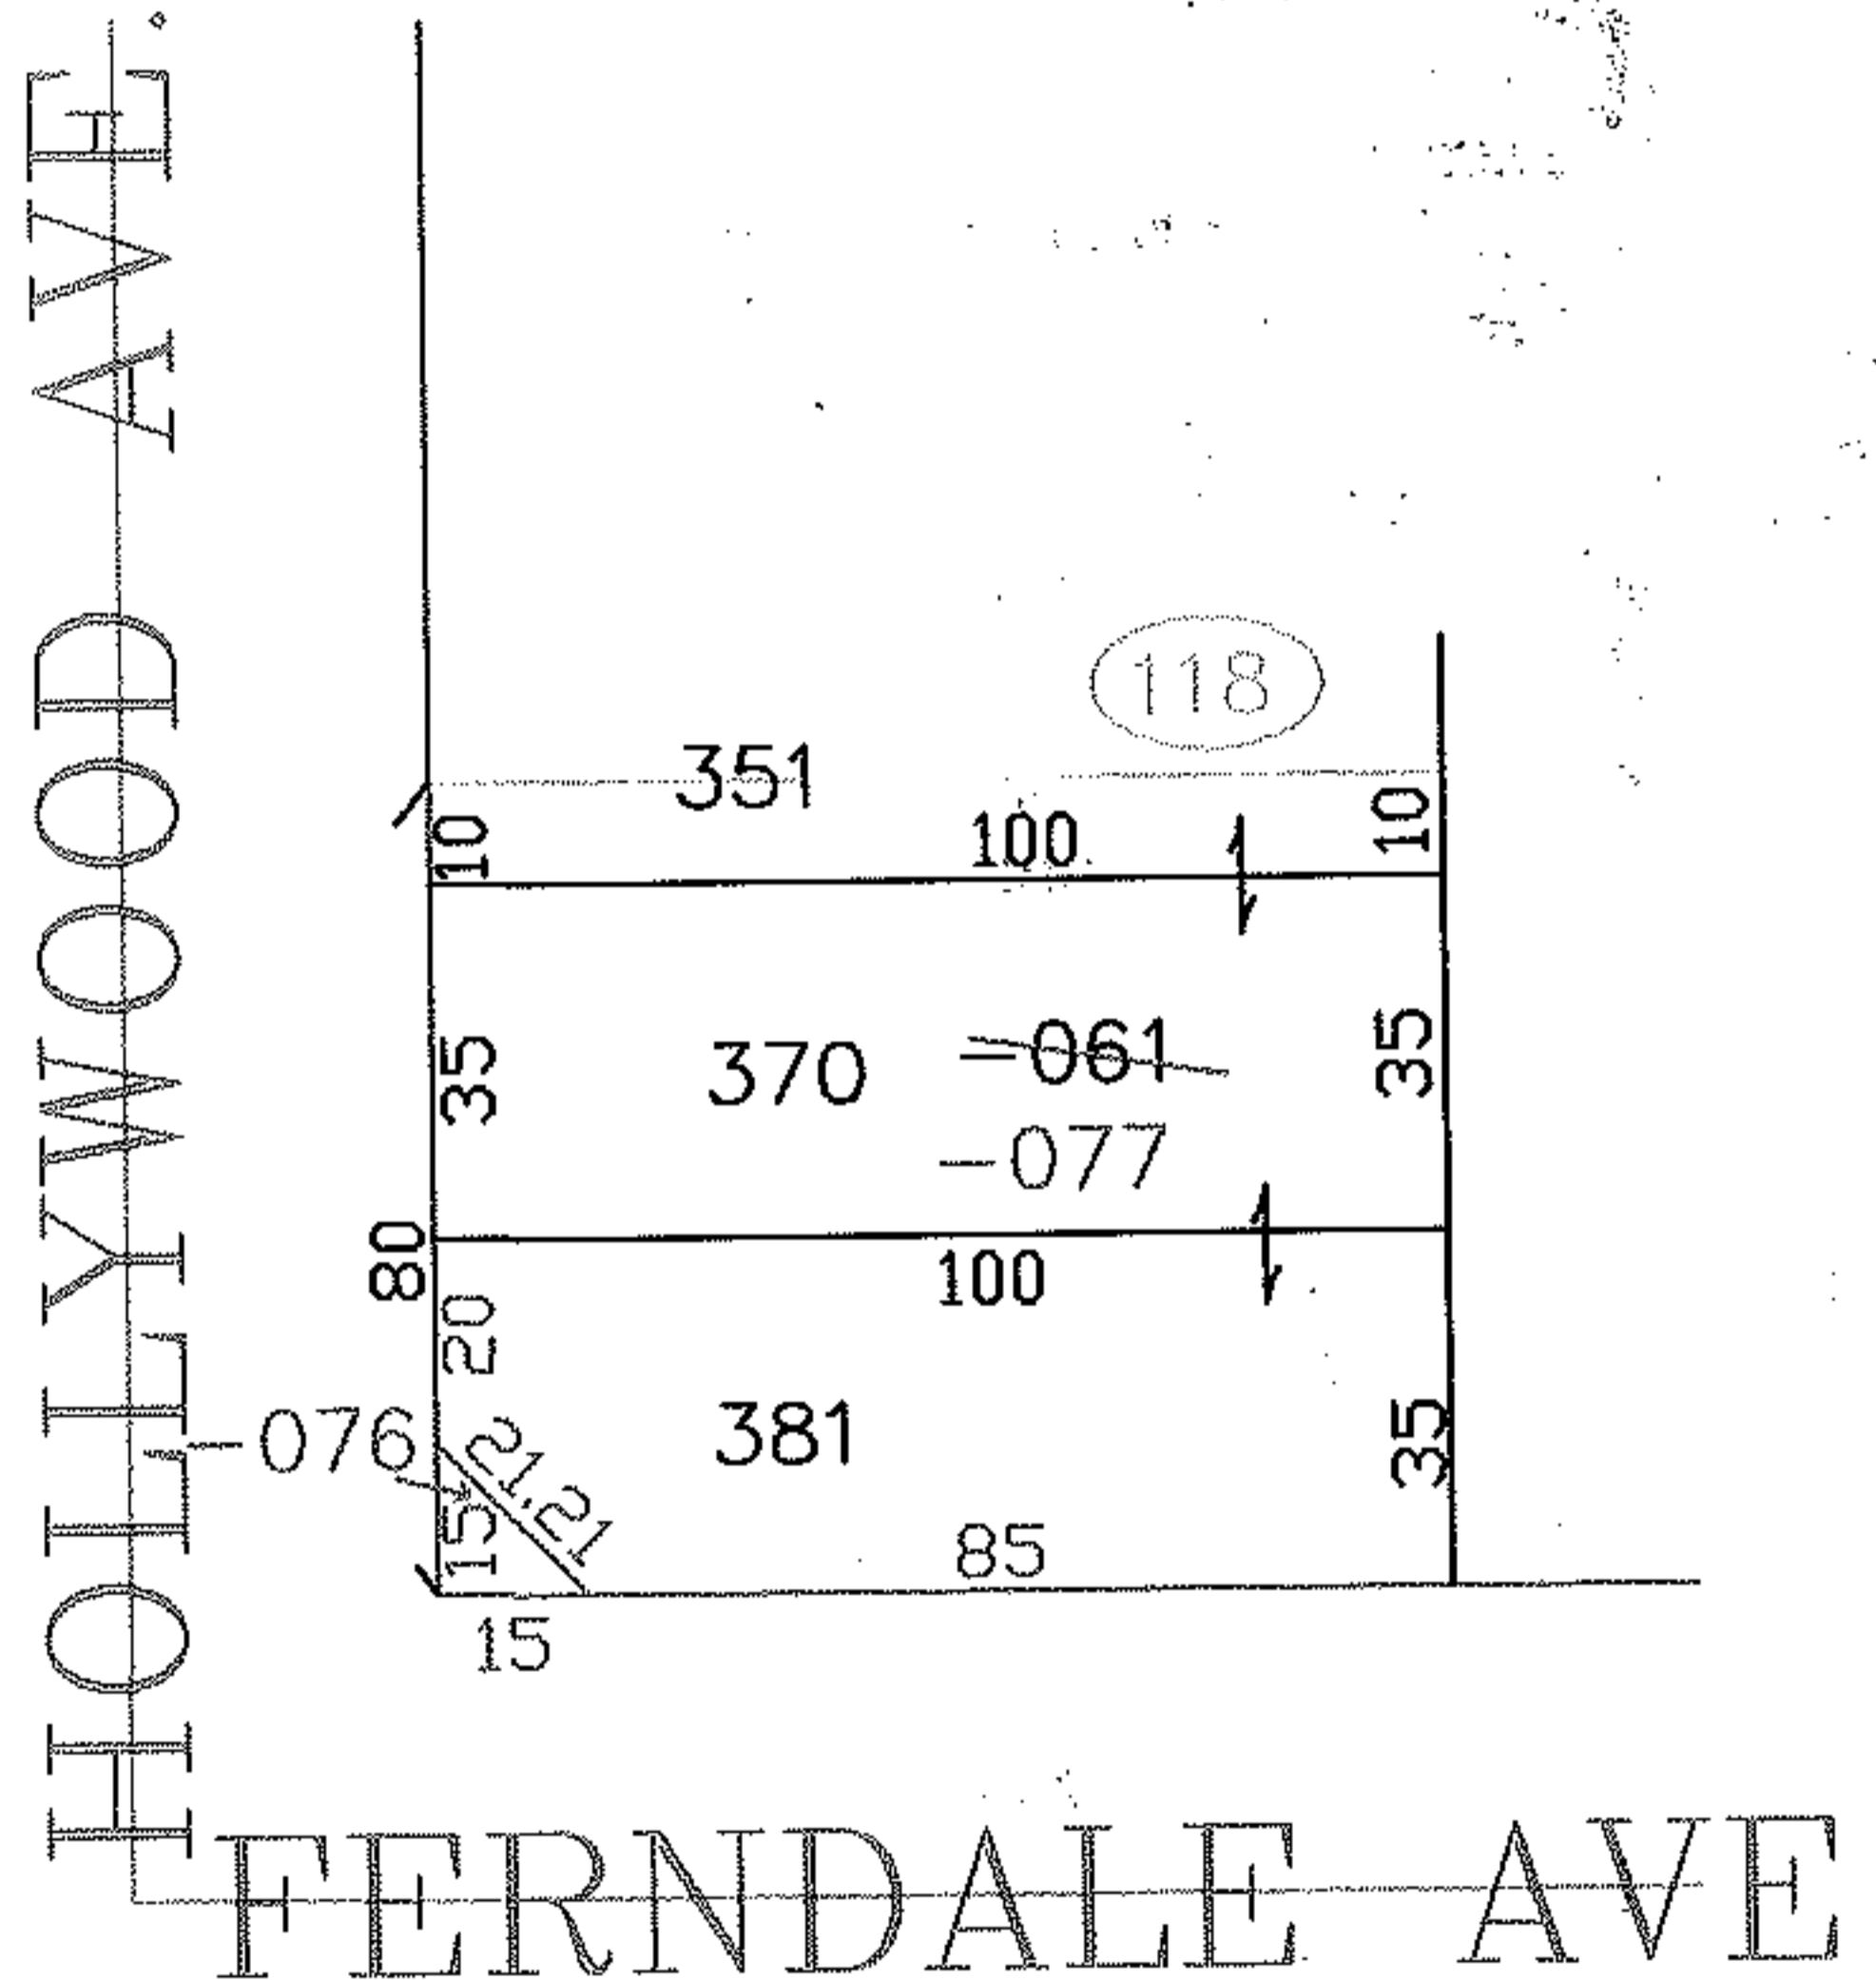

SPLITS/DEEDS PROCESSED
 LORAIN COUNTY TAX MAP DEPARTMENT
 226 MIDDLE AVE. ELYRIA, OHIO

SURVEYED BY: ROBERT J. MCAULEY
 CLOSURE: 0.00 : 10.000
 MAP PAGE(S): 3-00-039-B
 APPROVED BY: JAH DATE: 1-27
 SCALE: 1" = 50' PRIOR INSTRUMENT: OR 7