
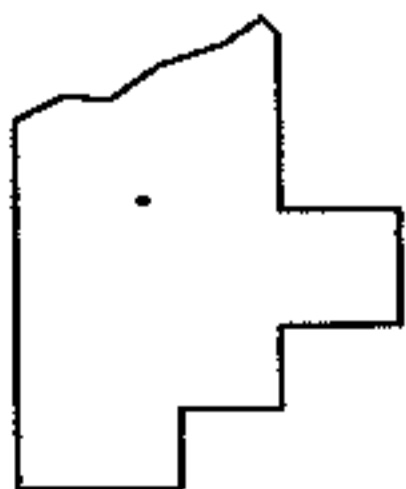
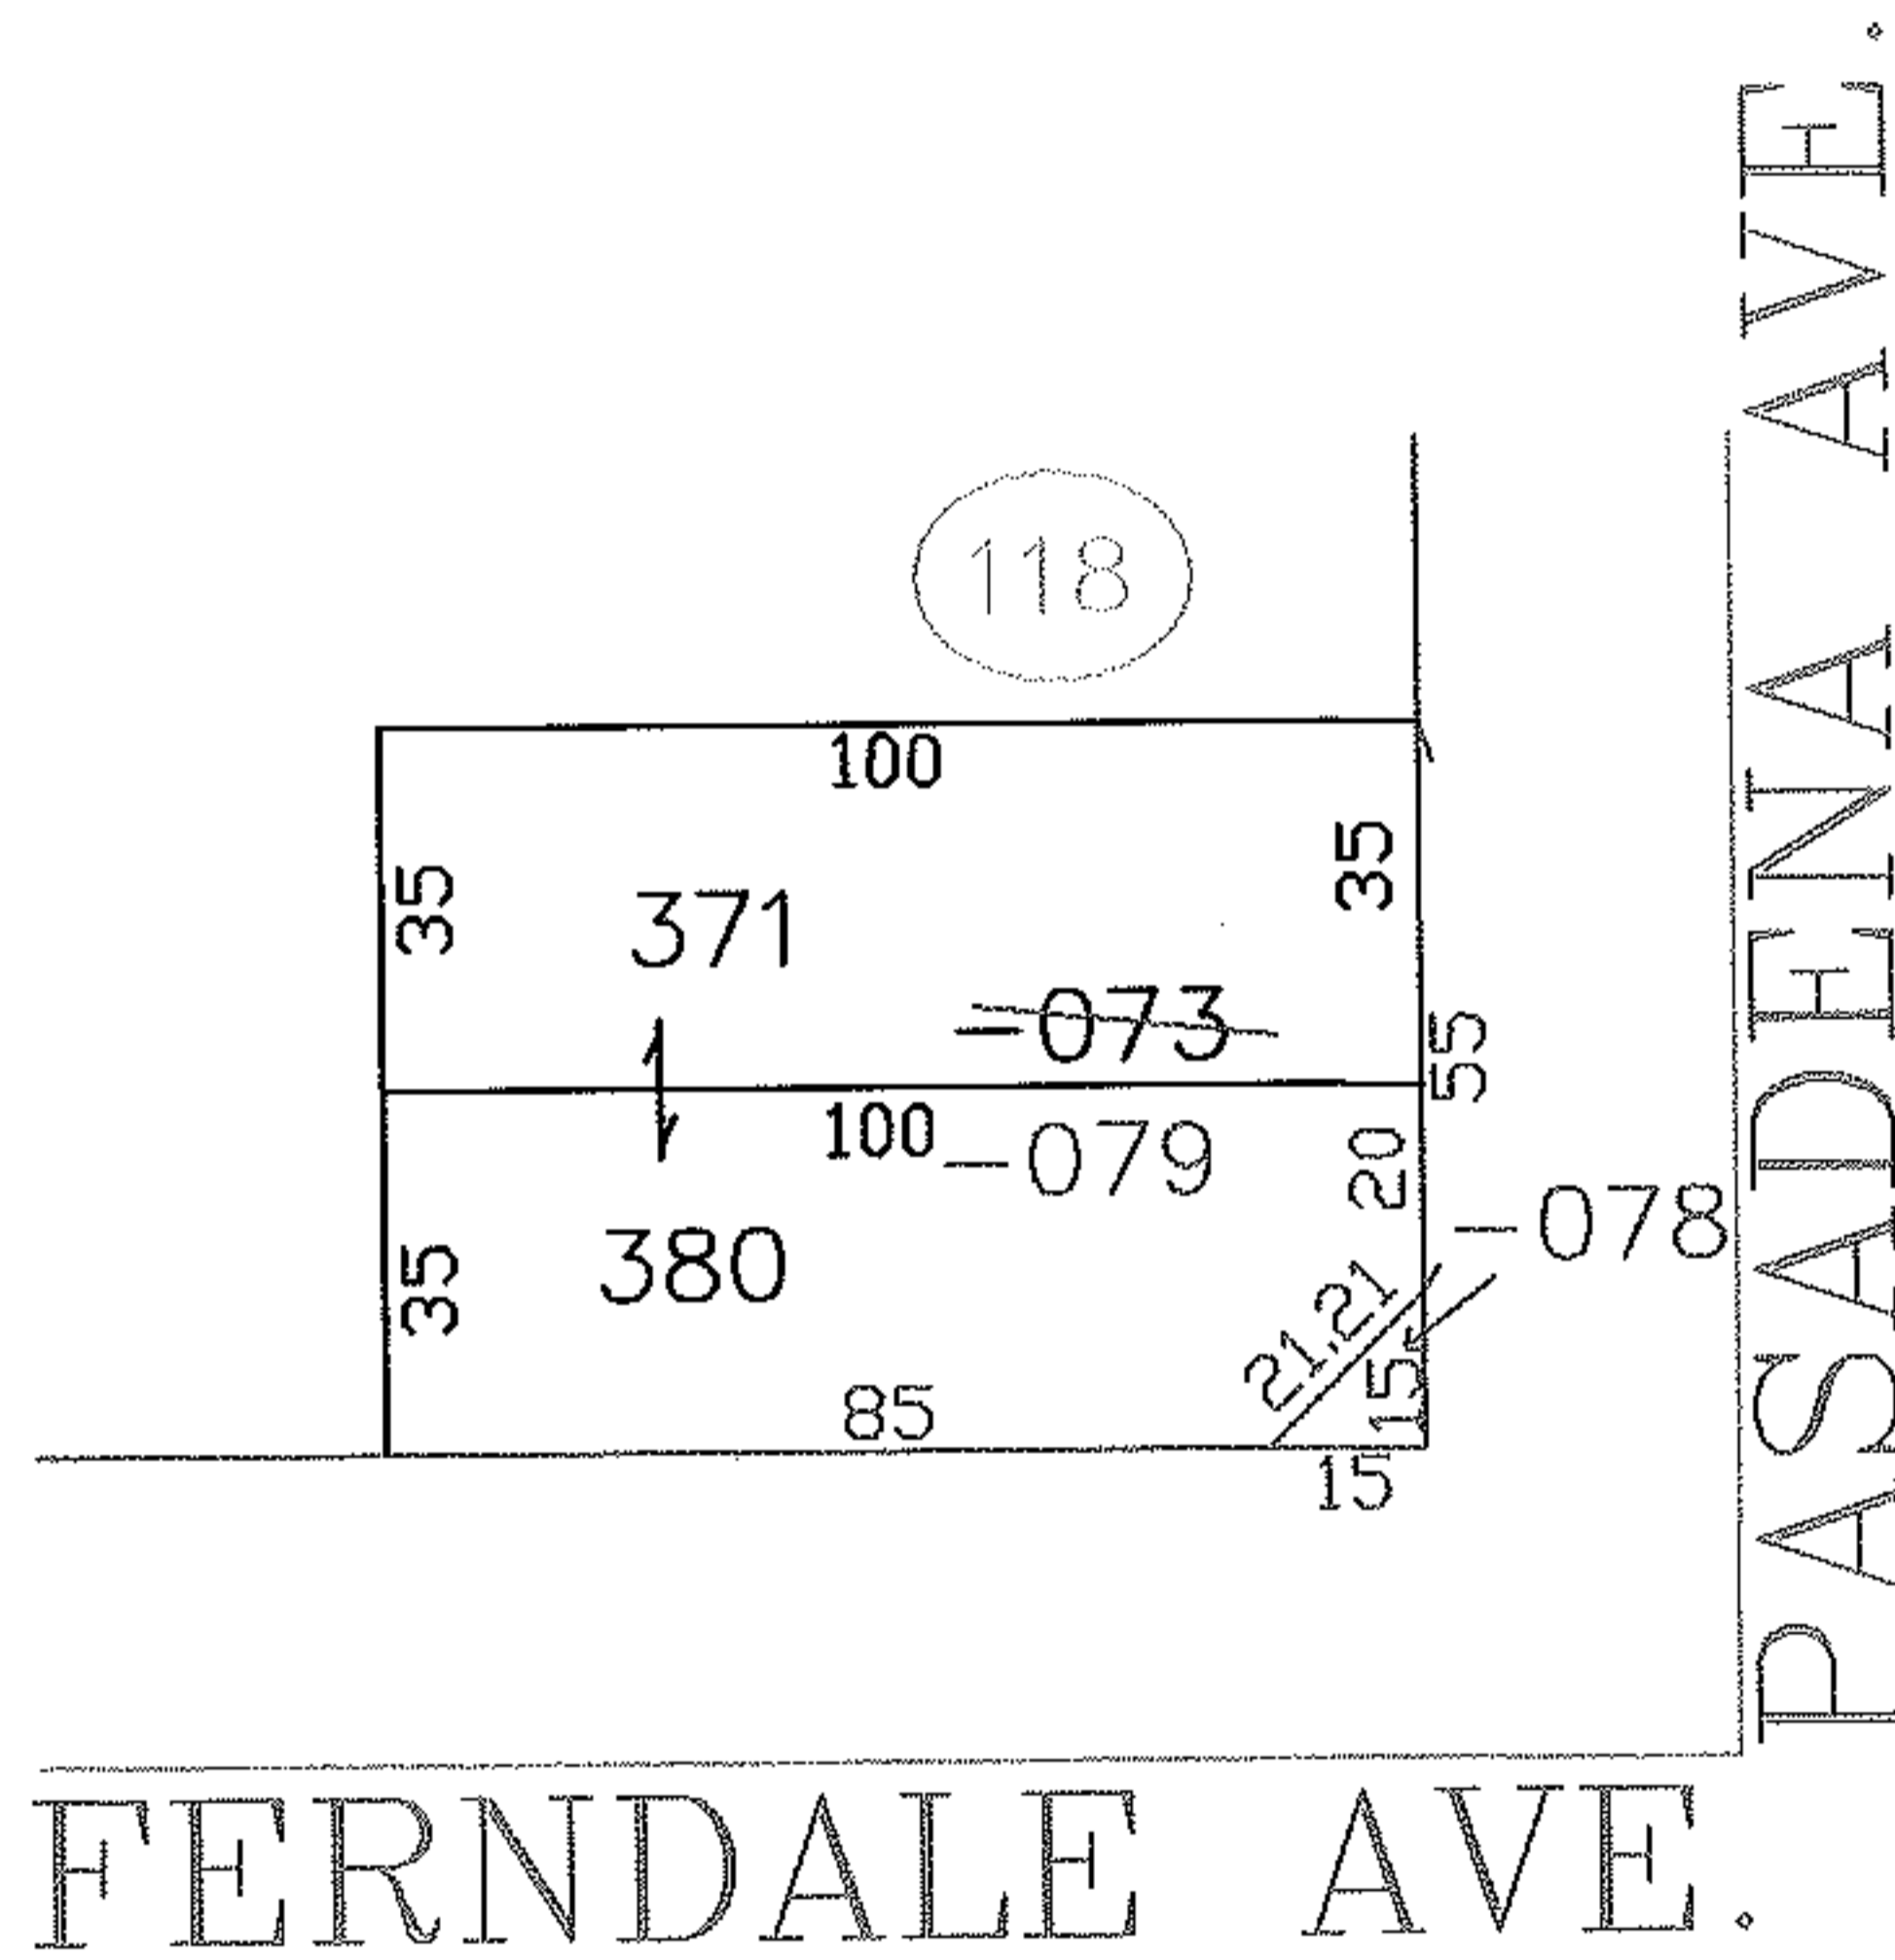


PARENT PARCEL: 03-00-039-118-073

CHILD PARCEL: 03-00-039-118-078, -079

STARTING POINT: SIDELINE OF FERNDALE AVE. & PASADENA AVE.

NO. 00006

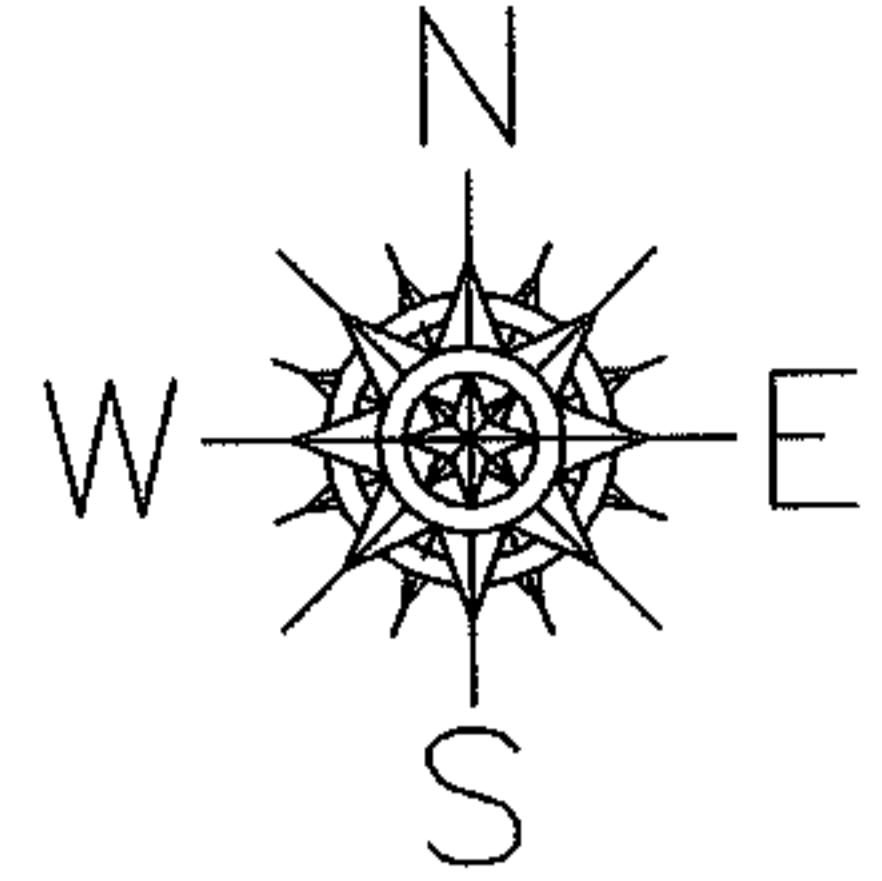

**SPLITS/DEEDS PROCESSED**

LORAIN COUNTY TAX MAP DEPARTMENT  
226 MIDDLE AVE. ELYRIA, OHIO

SURVEYED BY: ROBERT J. MCAULEY

CLOSURE: 0.00 : 10.000

MAP PAGE(S): 03-00-039-B

APPROVED BY: JAH DATE: 1-22-03

SCALE: 1" = 50' PRIOR INSTRUMENT: OR 35/82