


PARENT PARCEL: 03-00-039-119-025


CHILD PARCEL: 03-00-039-119-065, -066

STARTING POINT: SIDELINE OF FERNDALE AVE. & PASADENA AVE.


NO. 00007

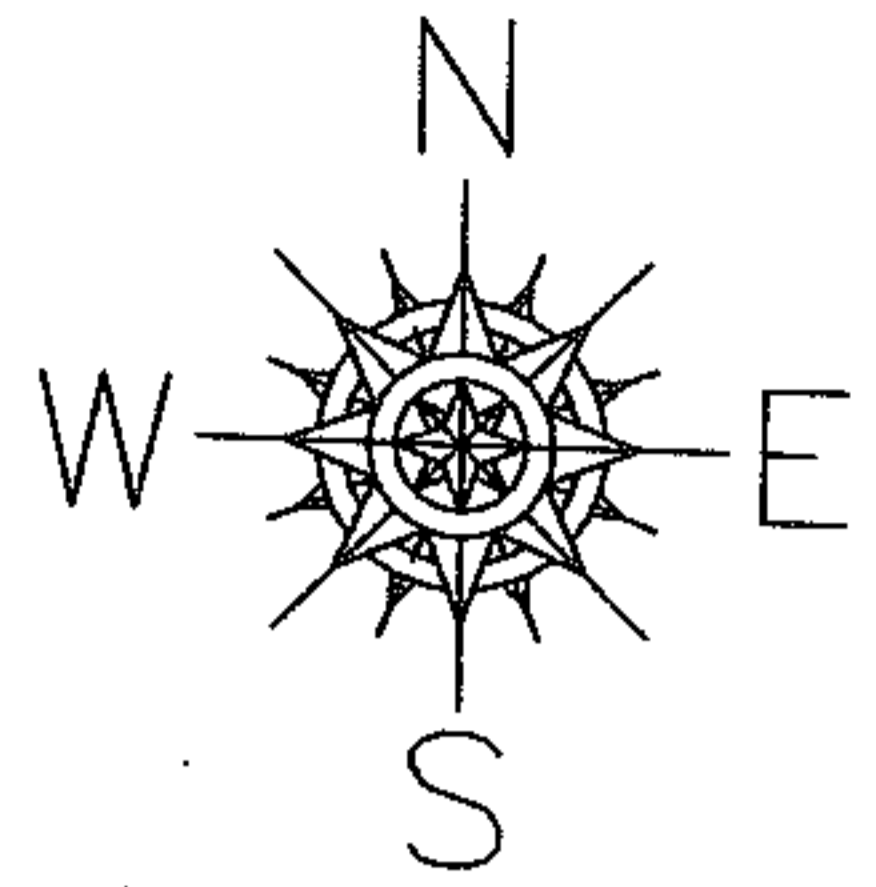

PASADENA AVE.

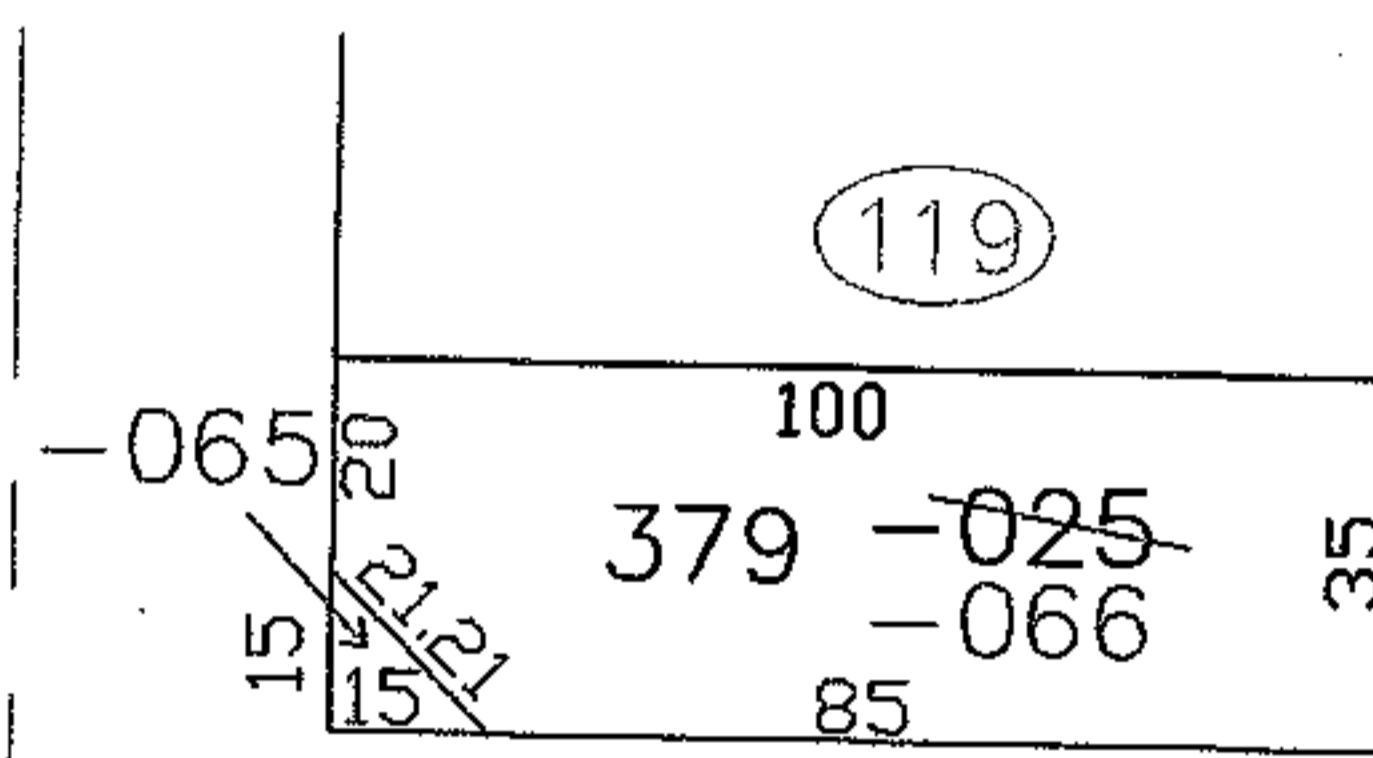

FERNDALE AVE.

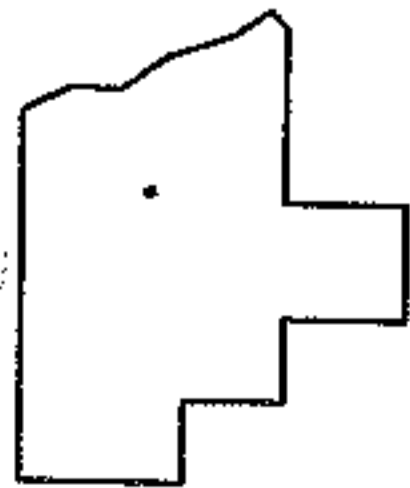

SPLITS/DEEDS PROCESSED

LORAIN COUNTY TAX MAP DEPARTMENT
226 MIDDLE AVE. ELYRIA, OHIO

SURVEYED BY: ROBERT J. MCAULEY

CLOSURE: 0.00: 10.000

MAP PAGE(S): 03-00-039-B

APPROVED BY: JAH DATE: 1-22-03

SCALE: 1" = 50' PRIOR INSTRUMENT: OR 1150/574

Raster