
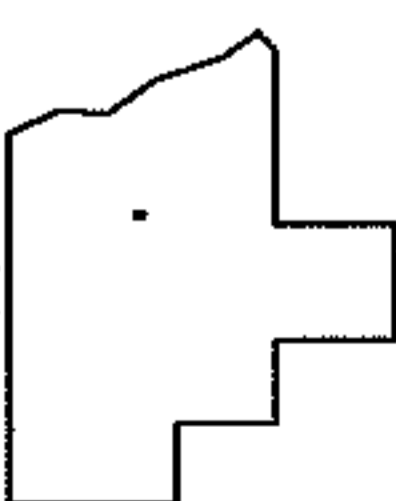
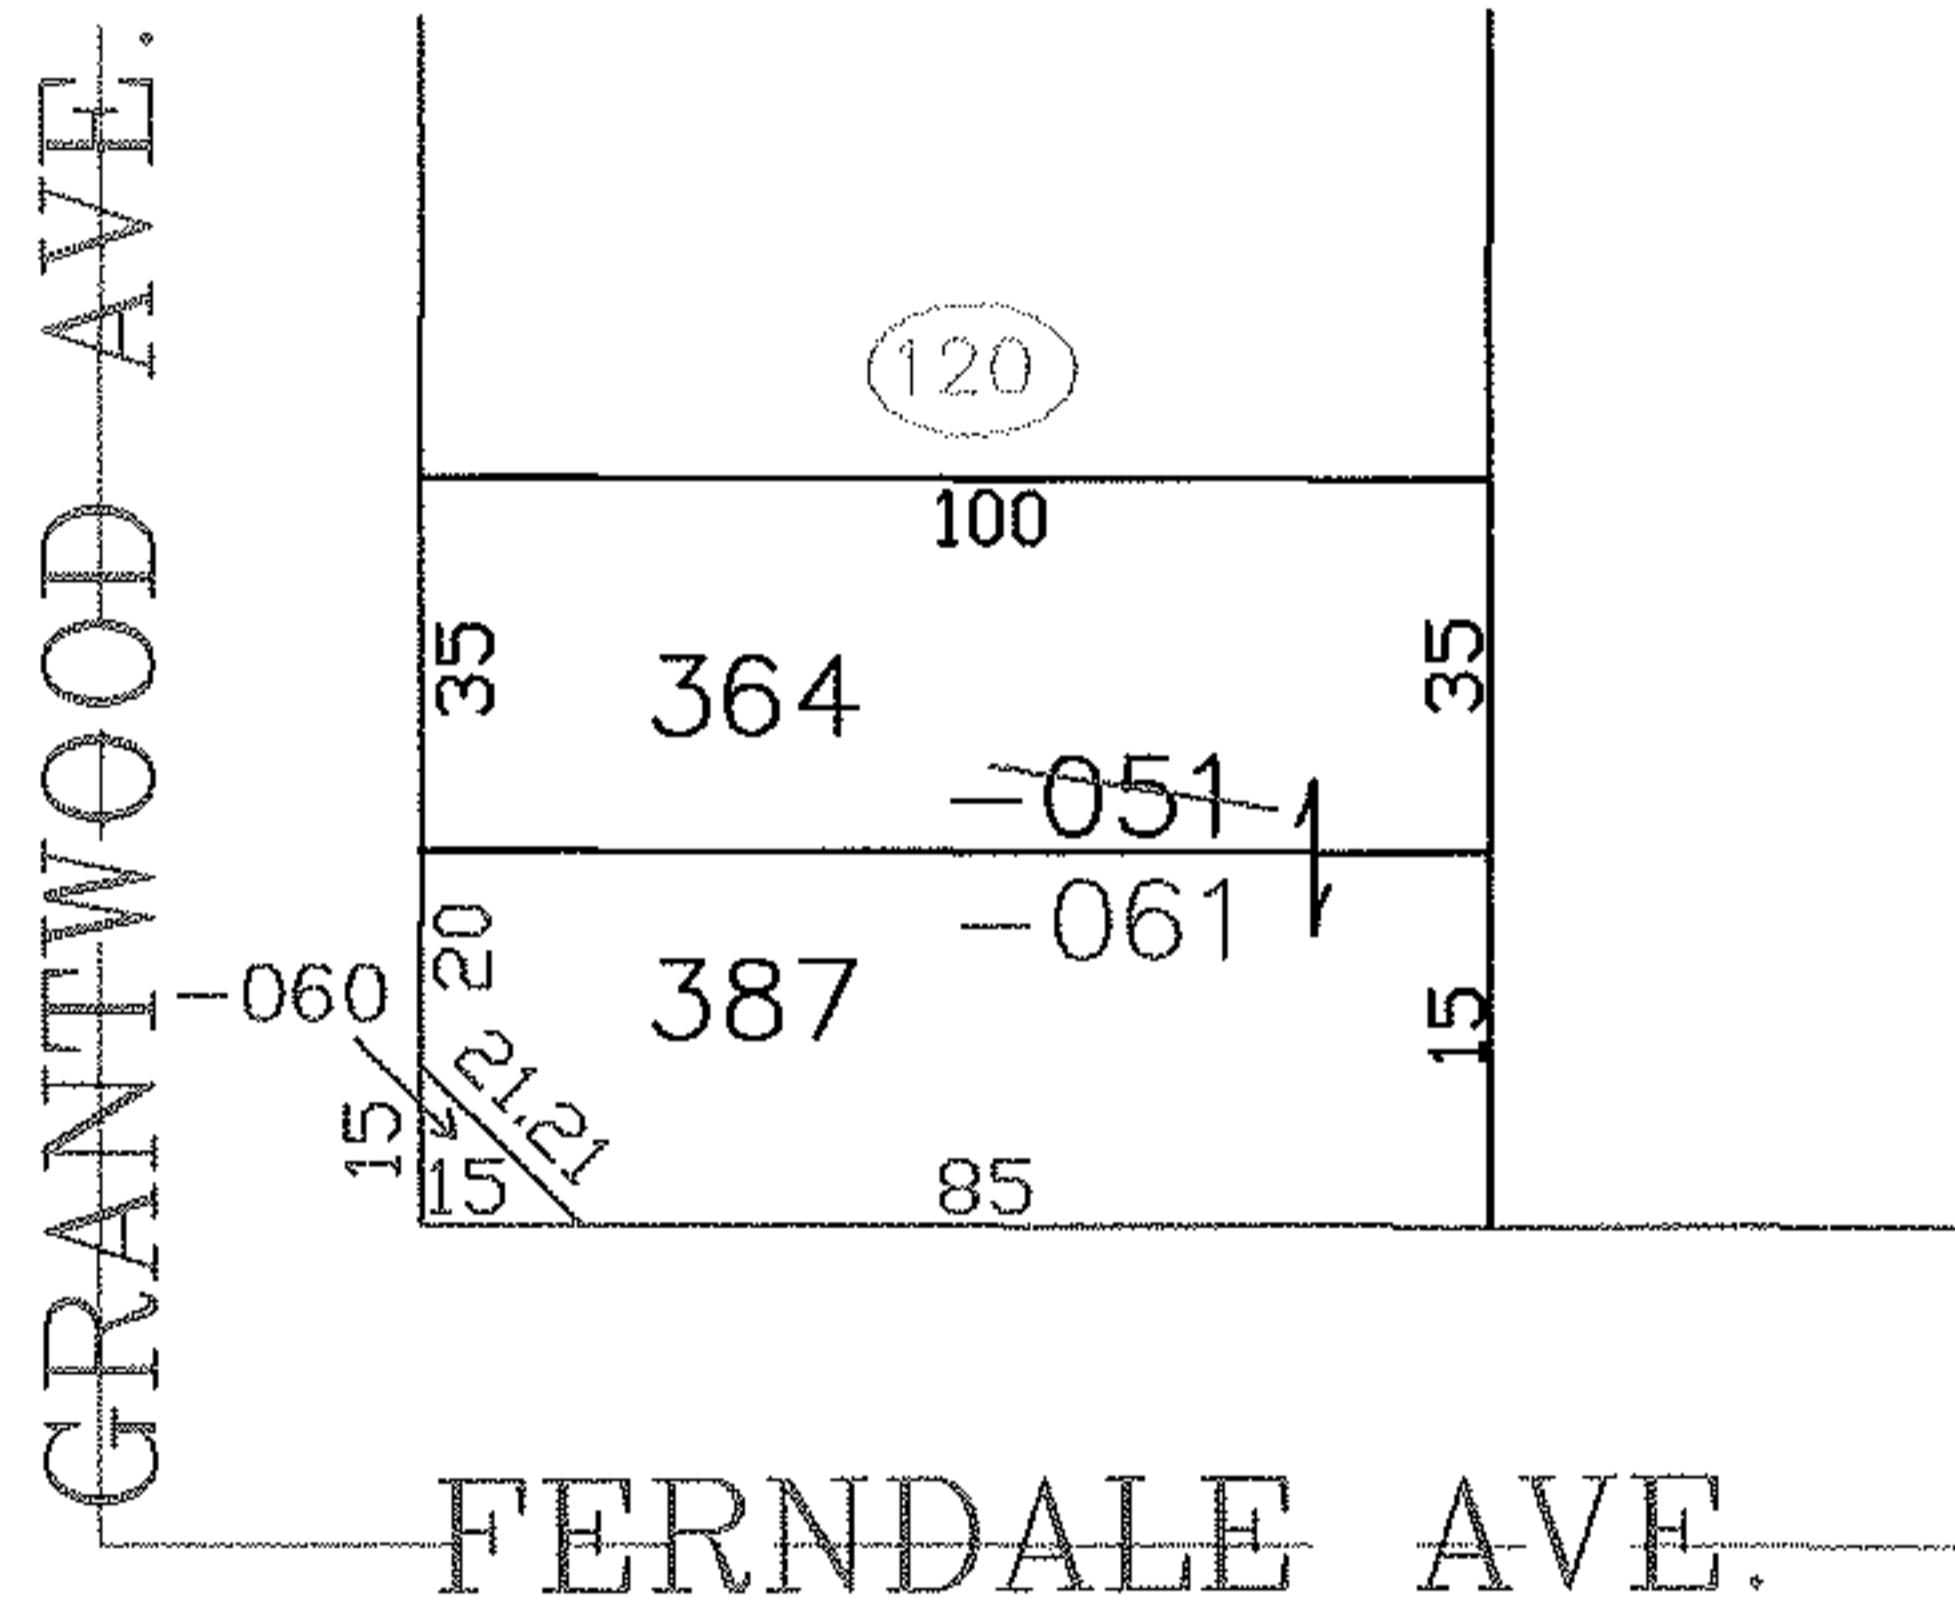


PARENT PARCEL: 03-00-040-120-051

CHILD PARCEL: 03-00-040-120-060, -061

STARTING POINT: SIDELINE OF GRANTWOOD AVE & FERNDALE AVE.

NO. 00011

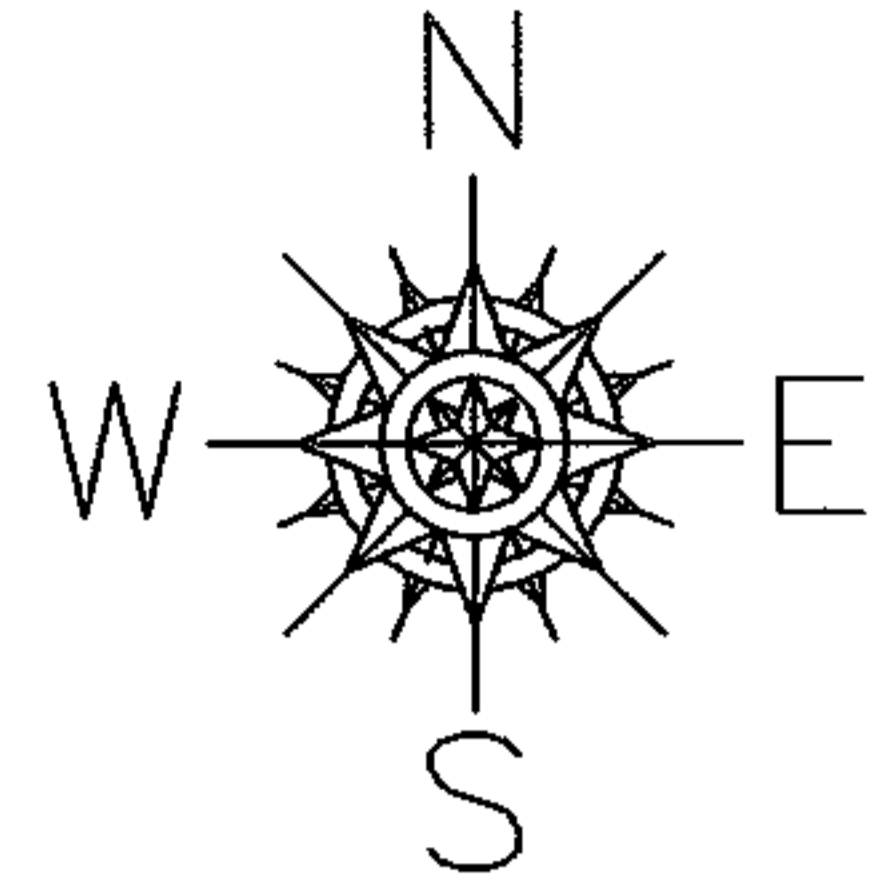

SPLITS/DEEDS PROCESSED
LORAIN COUNTY TAX MAP DEPARTMENT
 226 MIDDLE AVE. ELYRIA, OHIO

SURVEYED BY: ROBERT J. MCAULEY
 CLOSURE: 0.00 : 10,000
 MAP PAGE(S): 03-00-040
 APPROVED BY: JAH DATE: 1-27-03
 SCALE: 1" = 50' PRIOR INSTRUMENT: 20000705307