
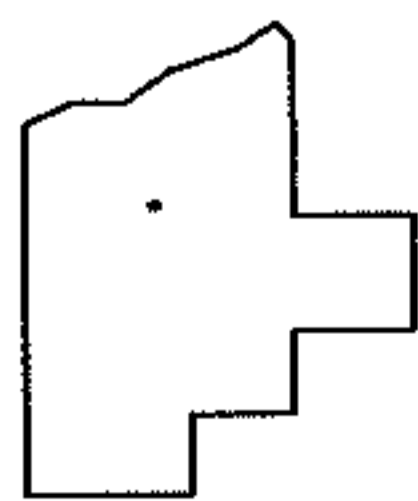
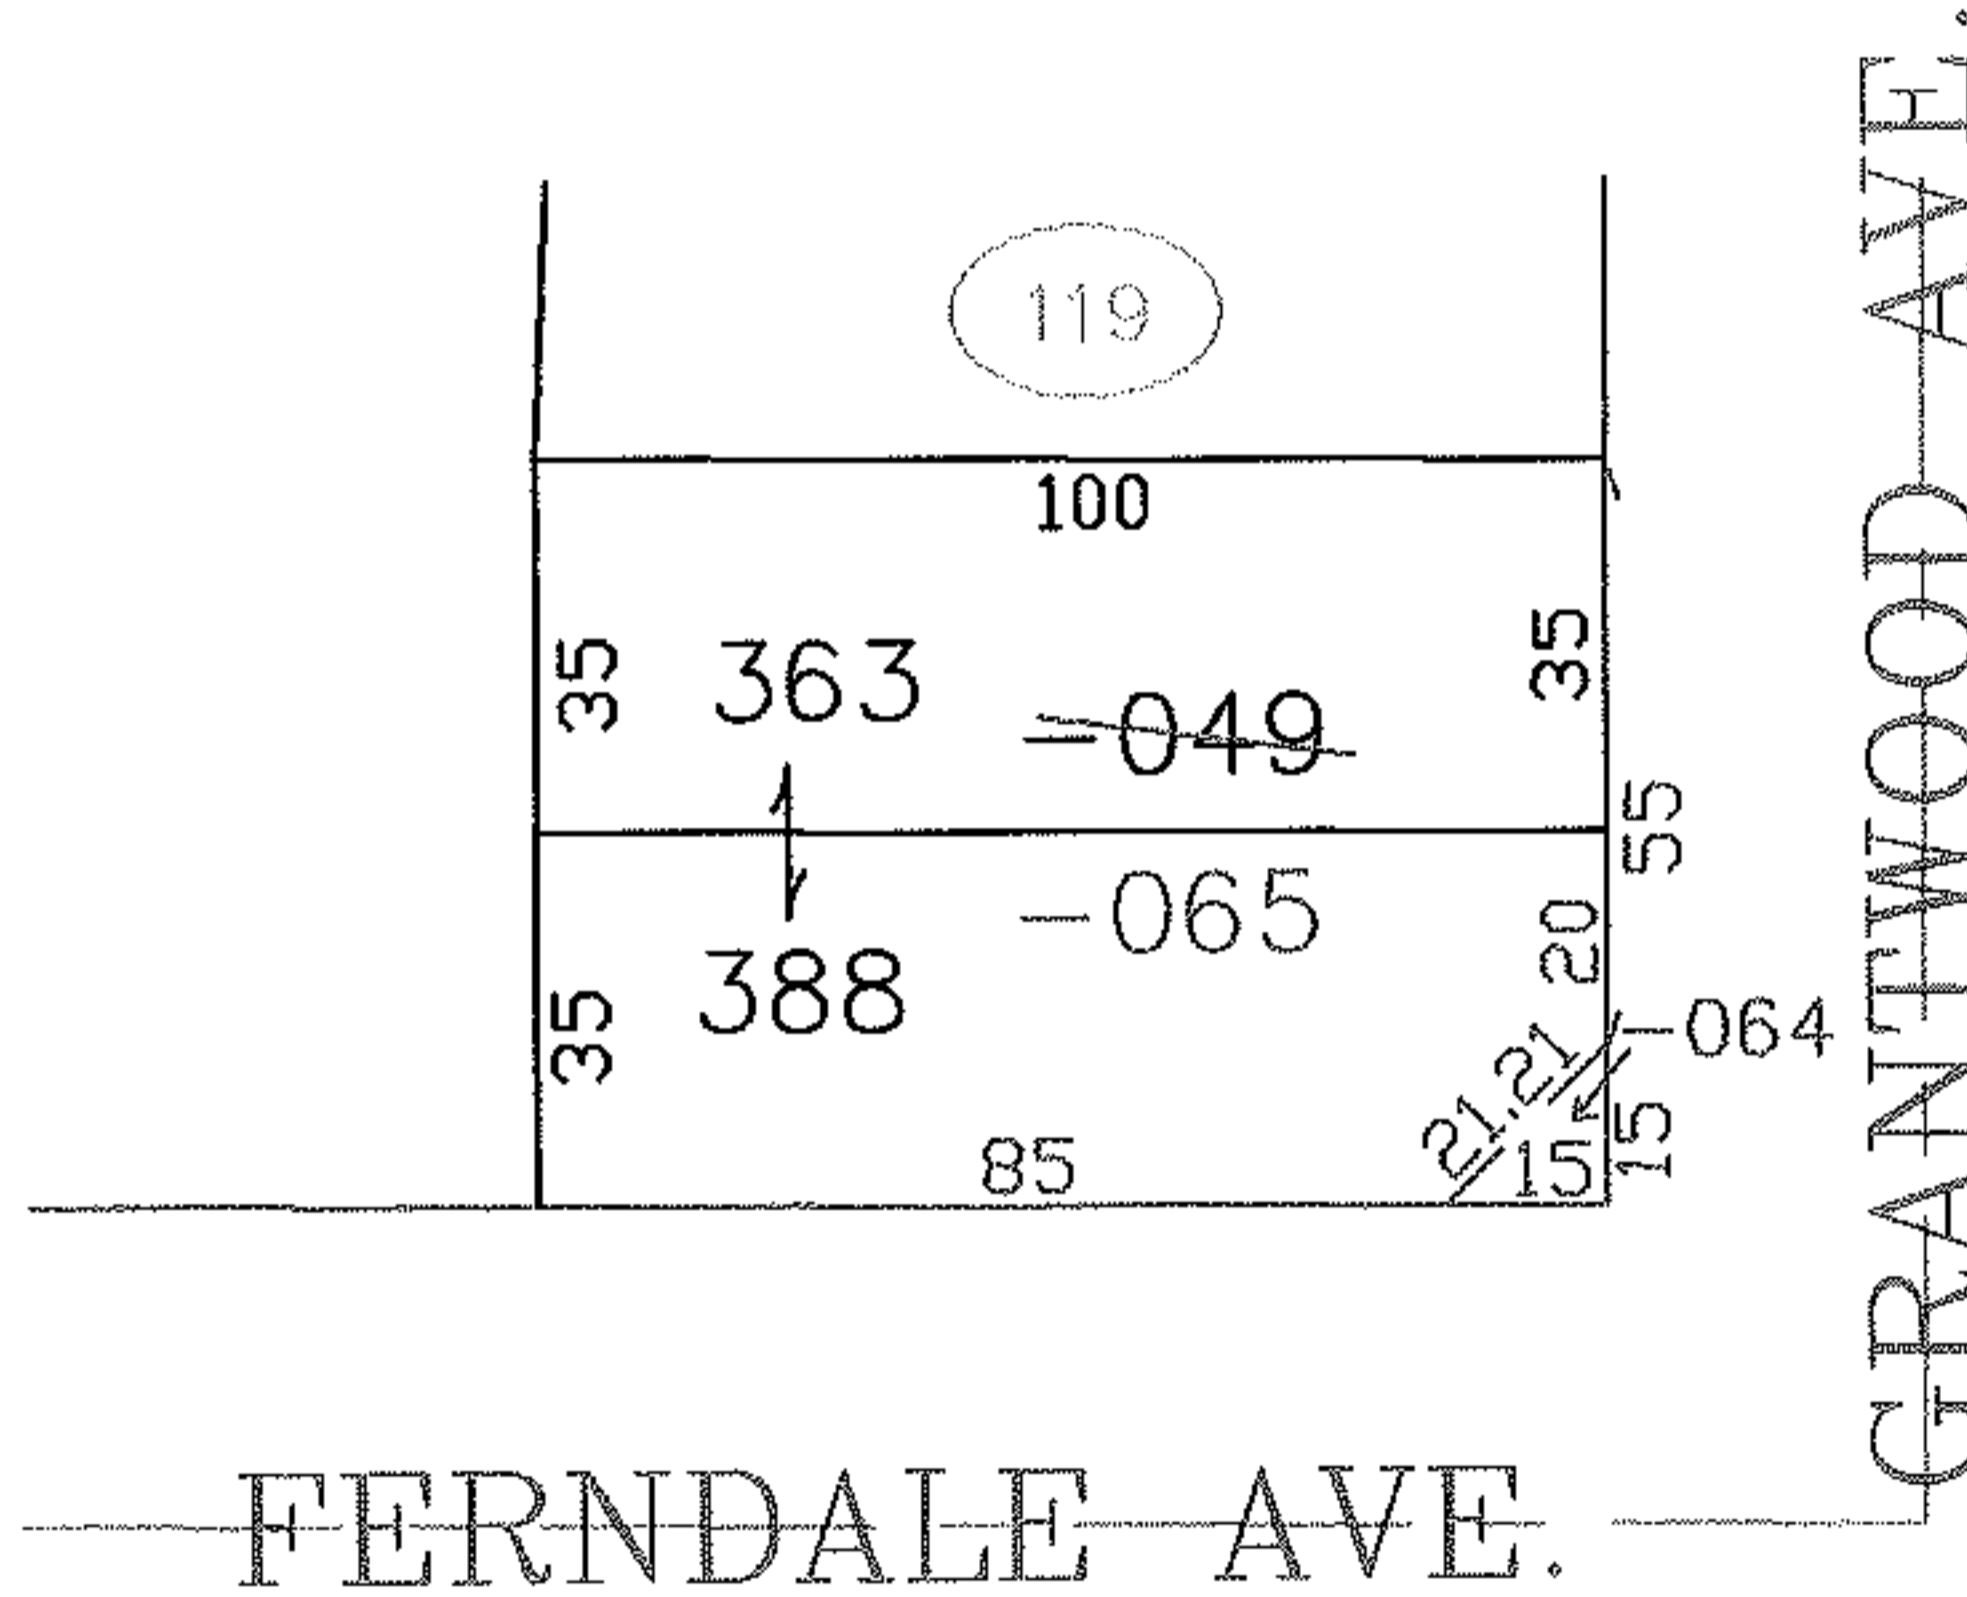


PARENT PARCEL: 03-00-040-119-049

CHILD PARCEL: 03-00-040-119-064, -065

STARTING POINT: SIDELINE OF FERNDALE AVE & GRANTWOOD AVE.

NO. 00014

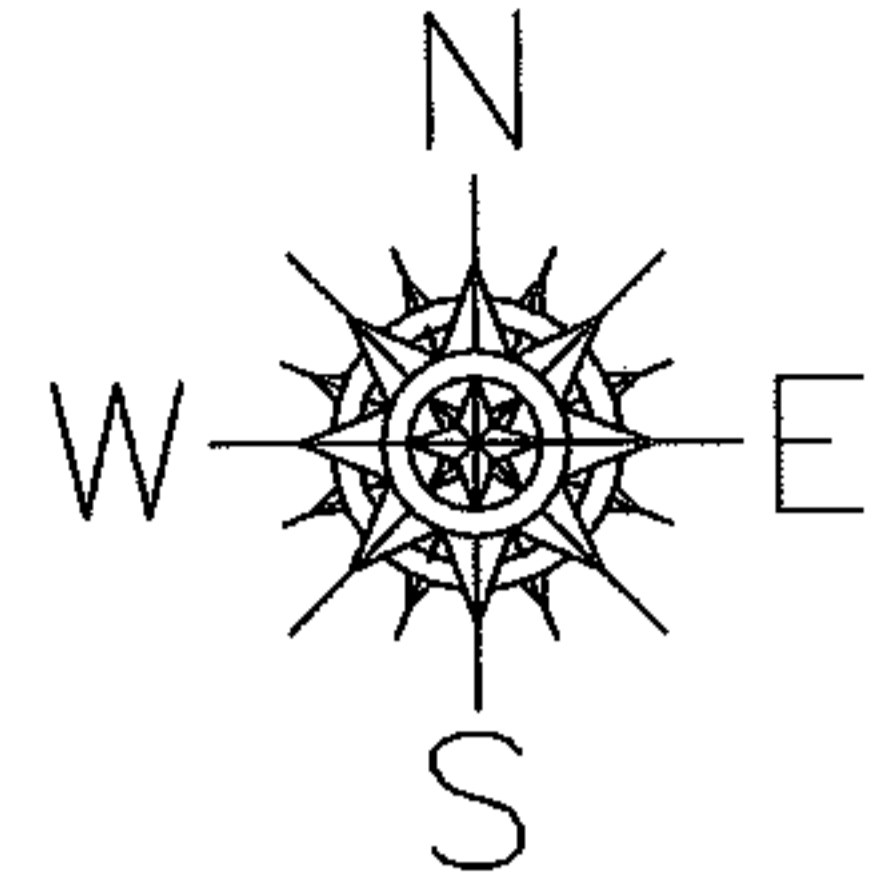

SPLITS/DEEDS PROCESSED

LORAIN COUNTY TAX MAP DEPARTMENT
226 MIDDLE AVE. ELYRIA, OHIO

SURVEYED BY: ROBERT J MCAULEY

CLOSURE: 0.00 : 10.000

MAP PAGE(S): 03-00-040

APPROVED BY: JAH DATE: 1-27-03

SCALE: 1" = 50' PRIOR INSTRUMENT: 20010743718