
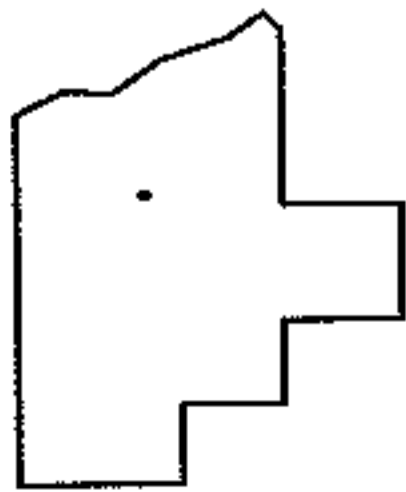
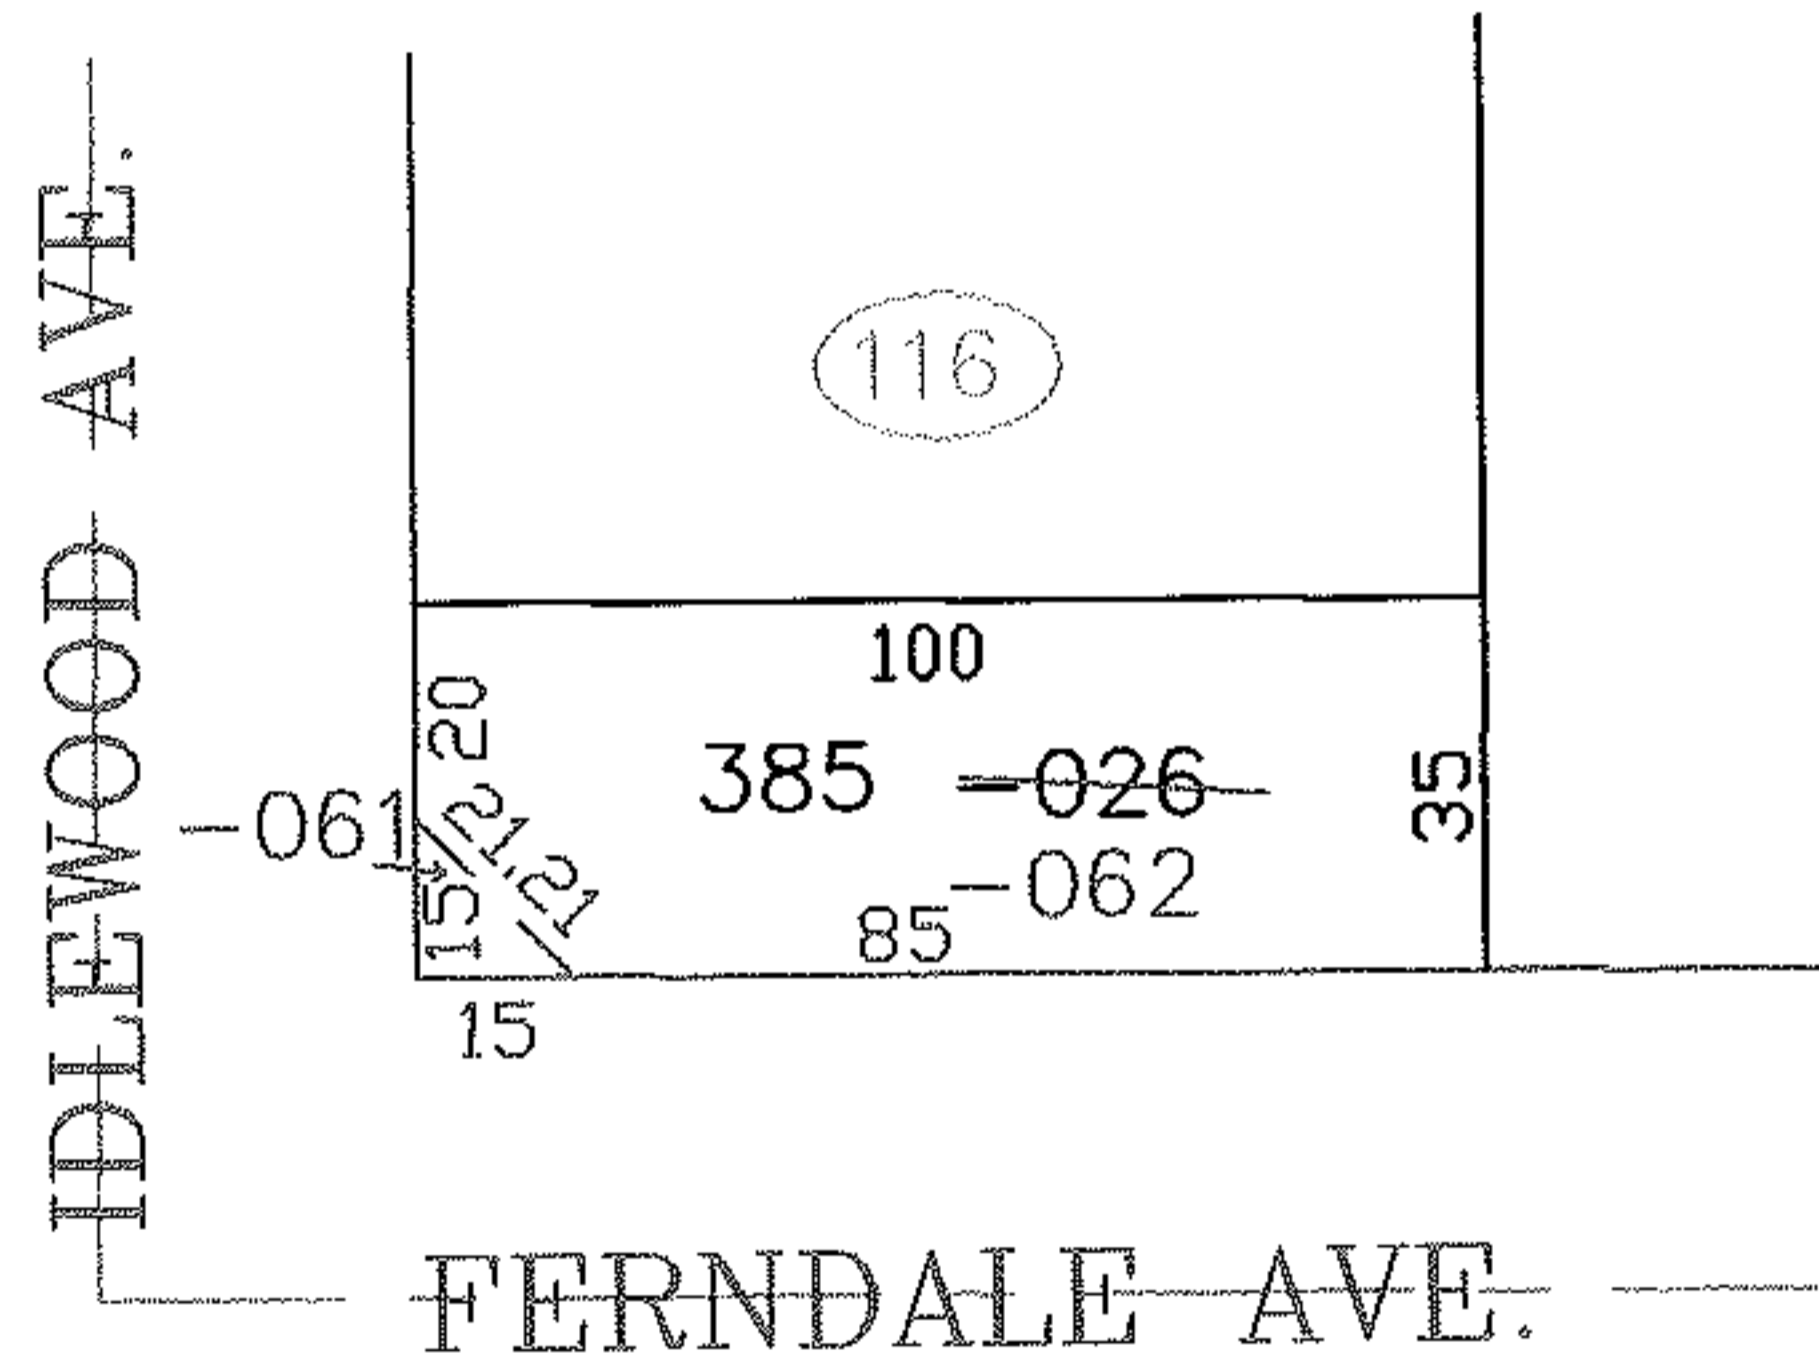


PARENT PARCEL: 03-00-039-116-026

CHILD PARCEL: 03-00-039-116-061, -062

STARTING POINT: SIDELINE OF FERNDALE AVE. & IDLEWOOD AVE.

NO. 00017

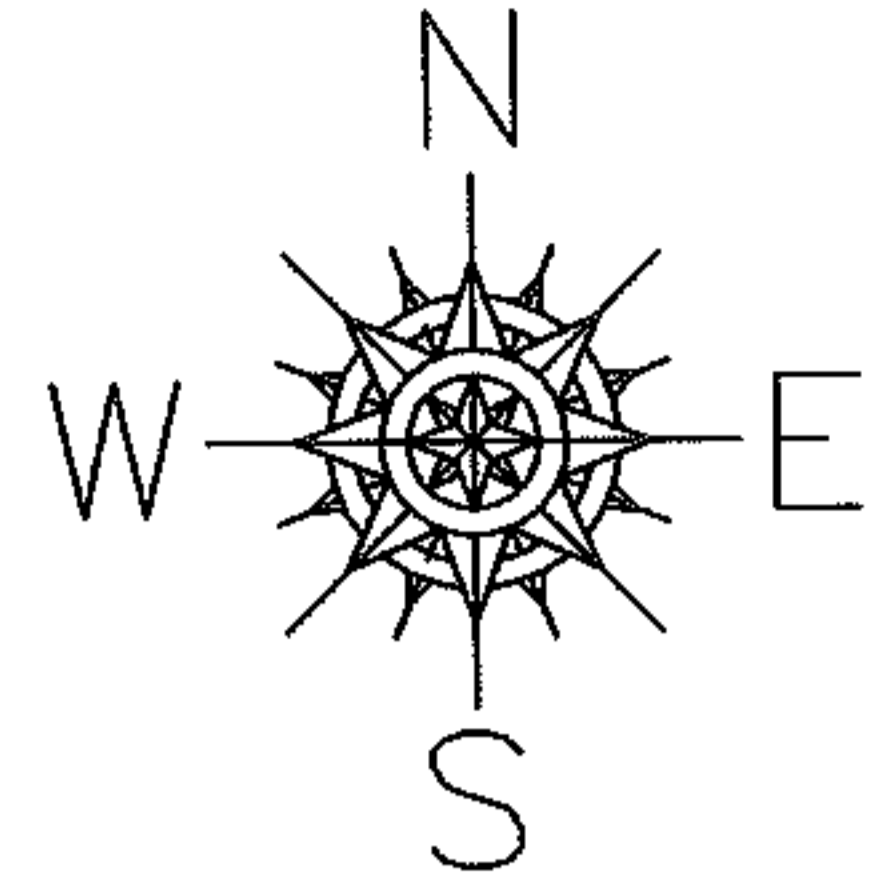

SPLITS/DEEDS PROCESSED
 LORAIN COUNTY TAX MAP DEPARTMENT
 226 MIDDLE AVE. ELYRIA, OHIO

SURVEYED BY: ROBERT J. MCAULEY
 CLOSURE: 0.00 : 10.000
 MAP PAGE(S): 03-00-039-B
 APPROVED BY: JAH DATE: 1-27-03
 SCALE: 1" = 50' PRIOR INSTRUMENT: OR 30/295