
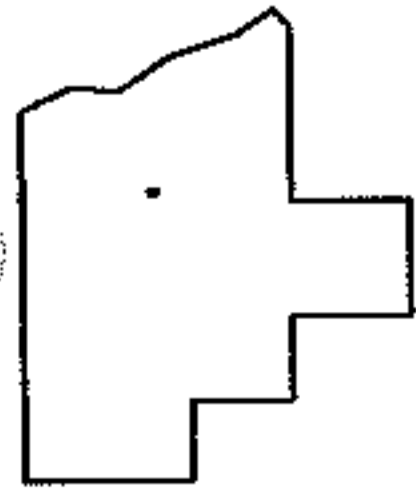
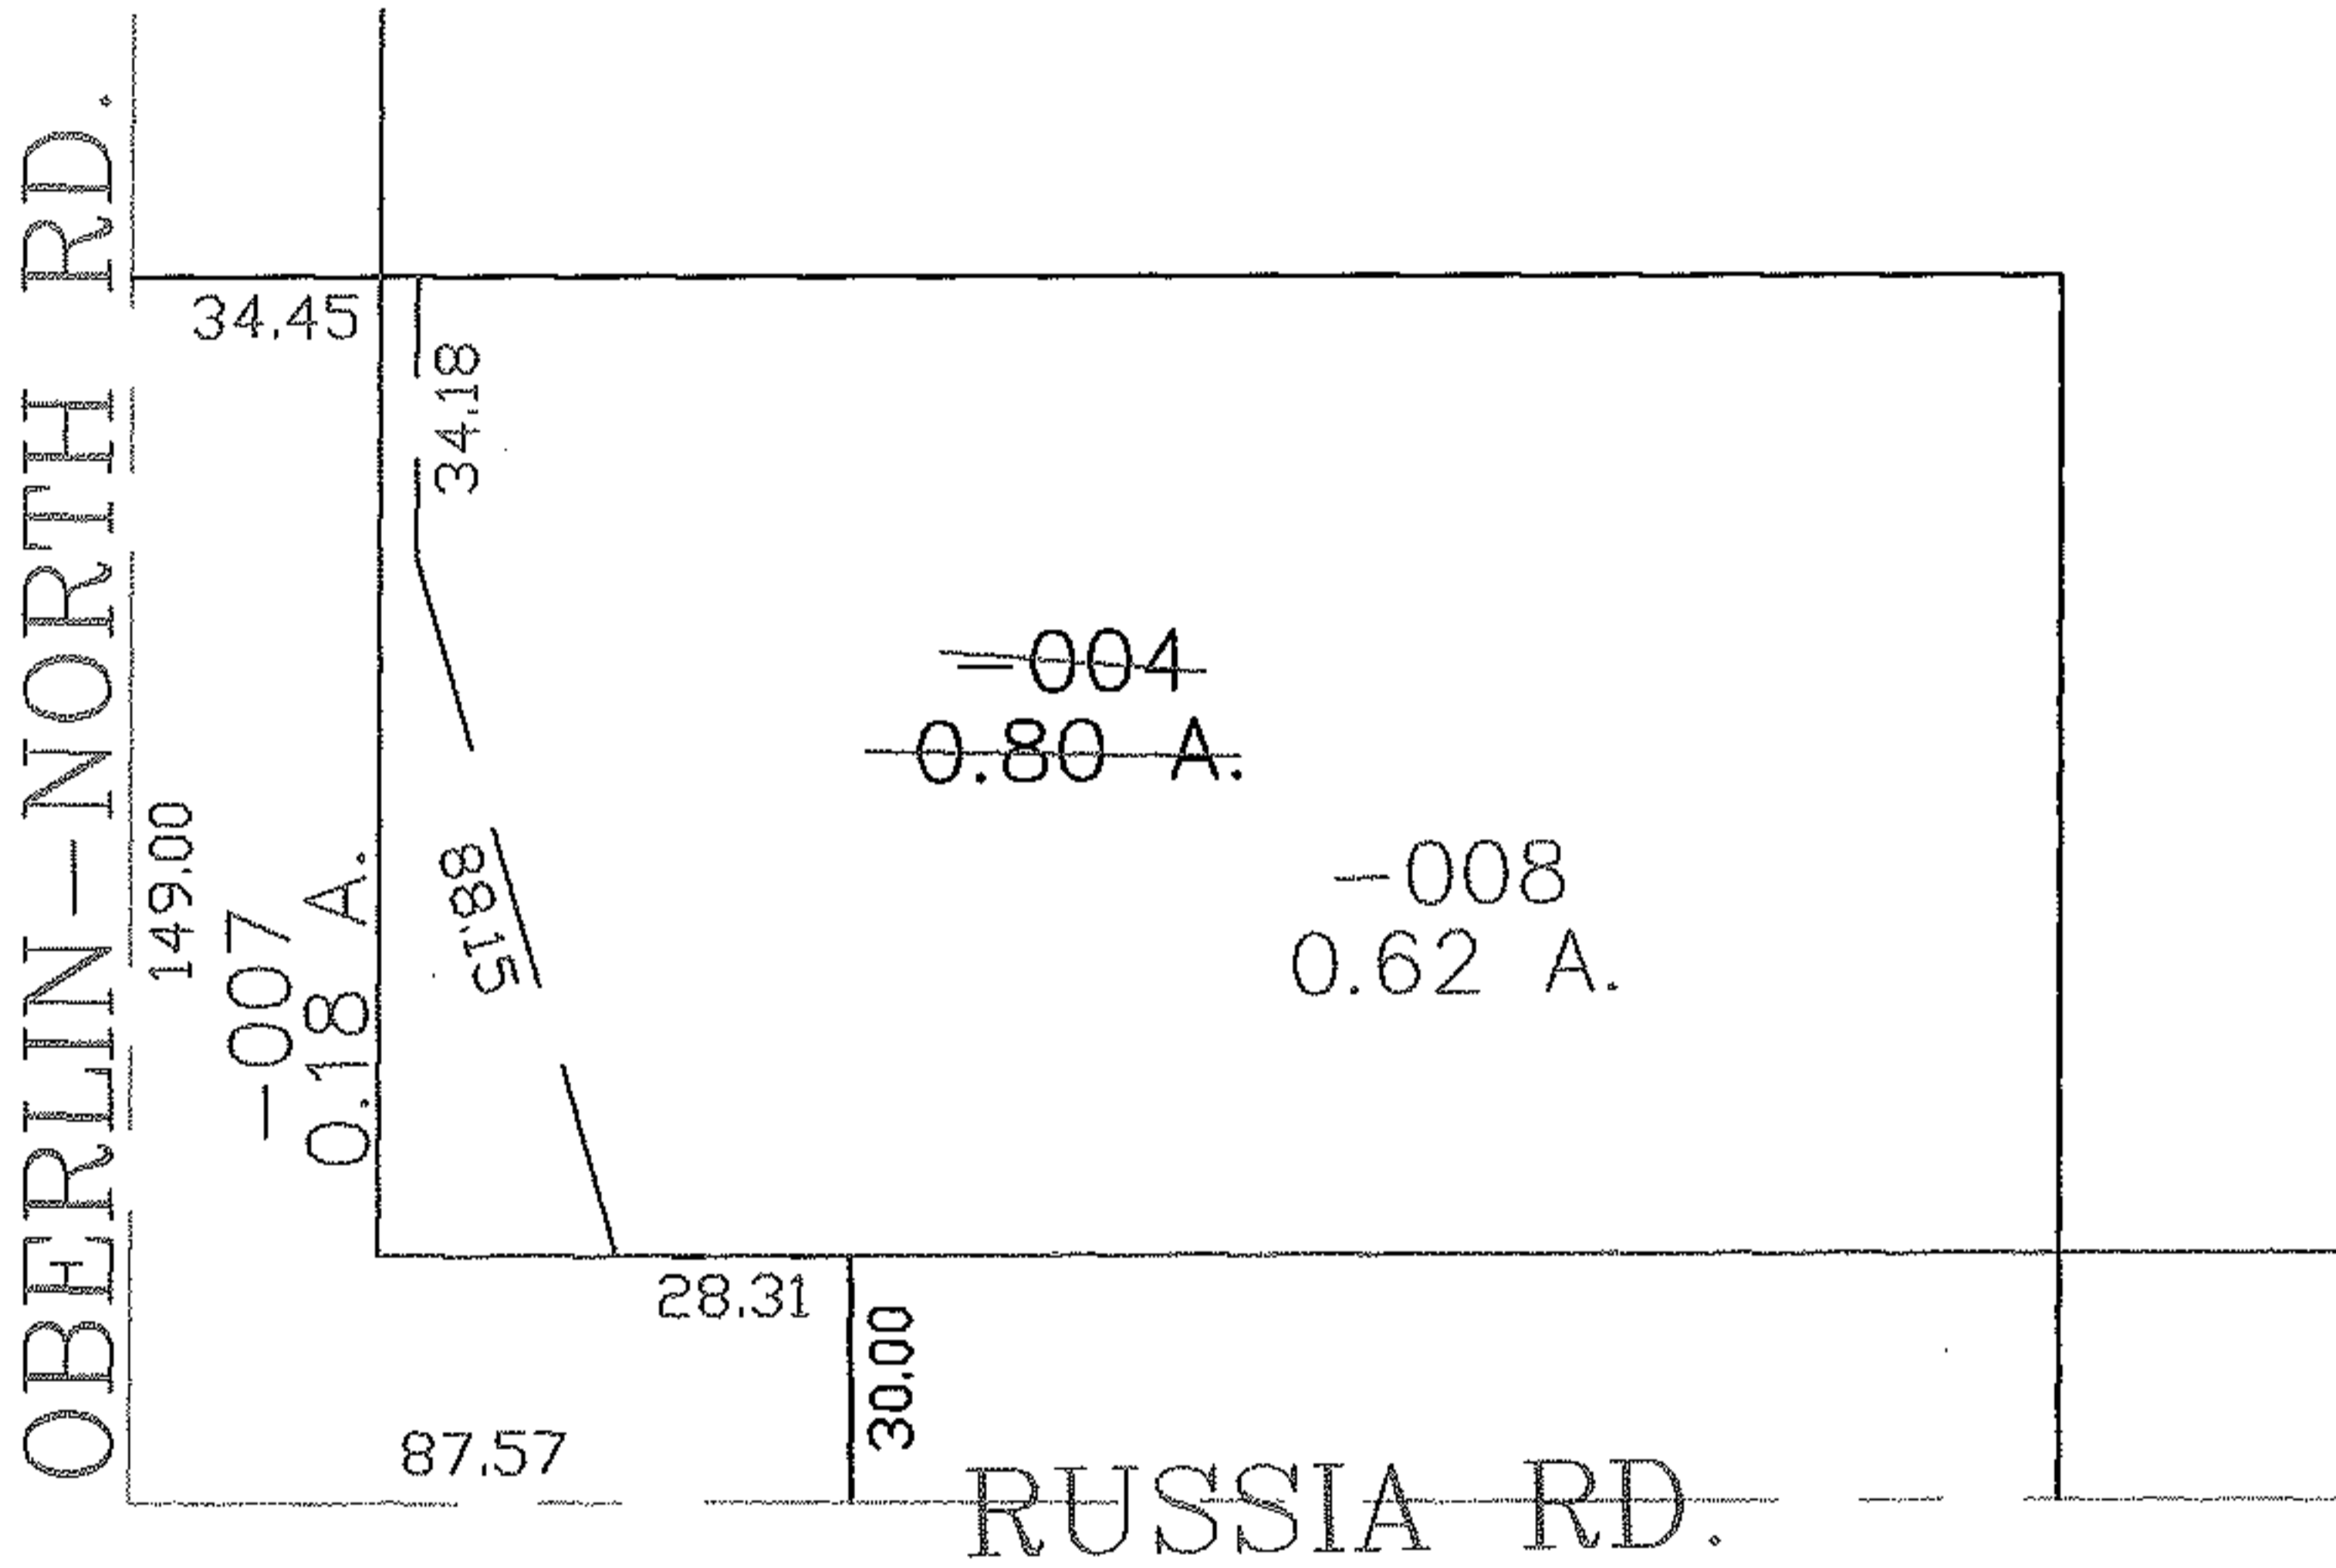


PARENT PARCEL: 09-00-016-000-004

CHILD PARCEL: 09-00-016-000-007, -008

STARTING POINT: CENTERLINE OF RUSSIA RD. & OBERLIN-NORTH RD.

NO. 00019

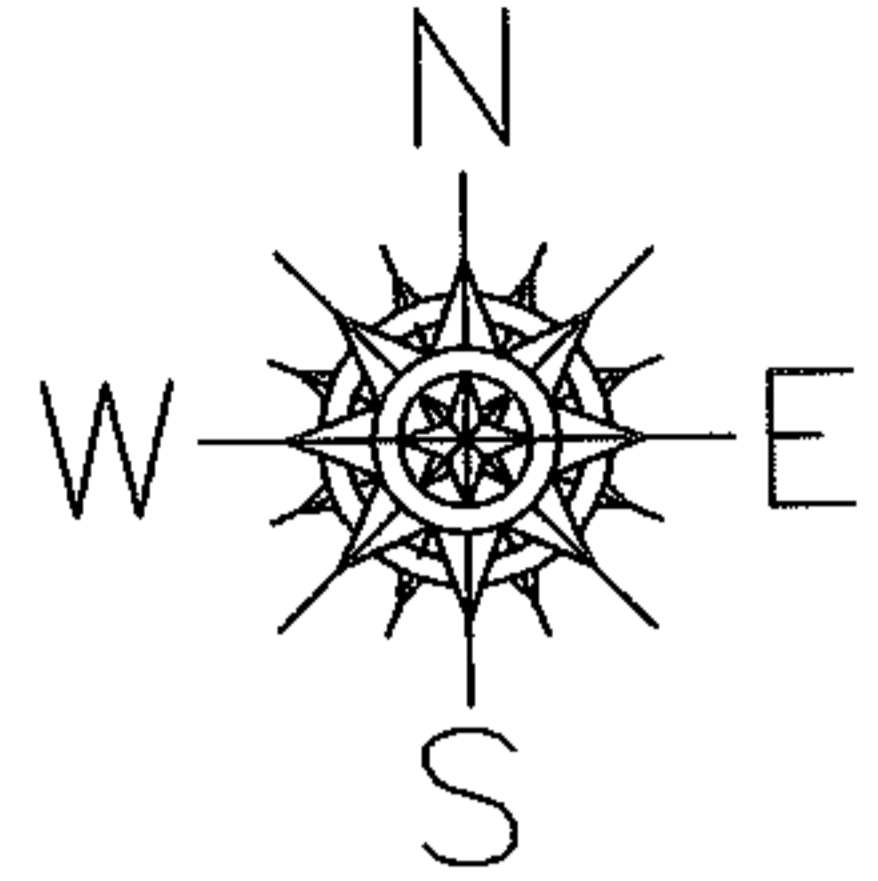

**SPLITS/DEEDS PROCESSED**  
 LORAIN COUNTY TAX MAP DEPARTMENT  
 226 MIDDLE AVE. ELYRIA, OHIO

SURVEYED BY: JAMES E. KENYON  
 CLOSURE: 0.01 : 10,000  
 MAP PAGE(S): 9-C  
 APPROVED BY: JAH DATE: 2-6-03  
 SCALE: 1" = 50' PRIOR INSTRUMENT: 990653044