


PARENT PARCEL: 03-00-040-123-062


CHILD PARCEL: 03-00-040-123-065, -066

STARTING POINT: SIDELINE OF FERNDALE AVE & DUNNY AVE.

NO. 00020

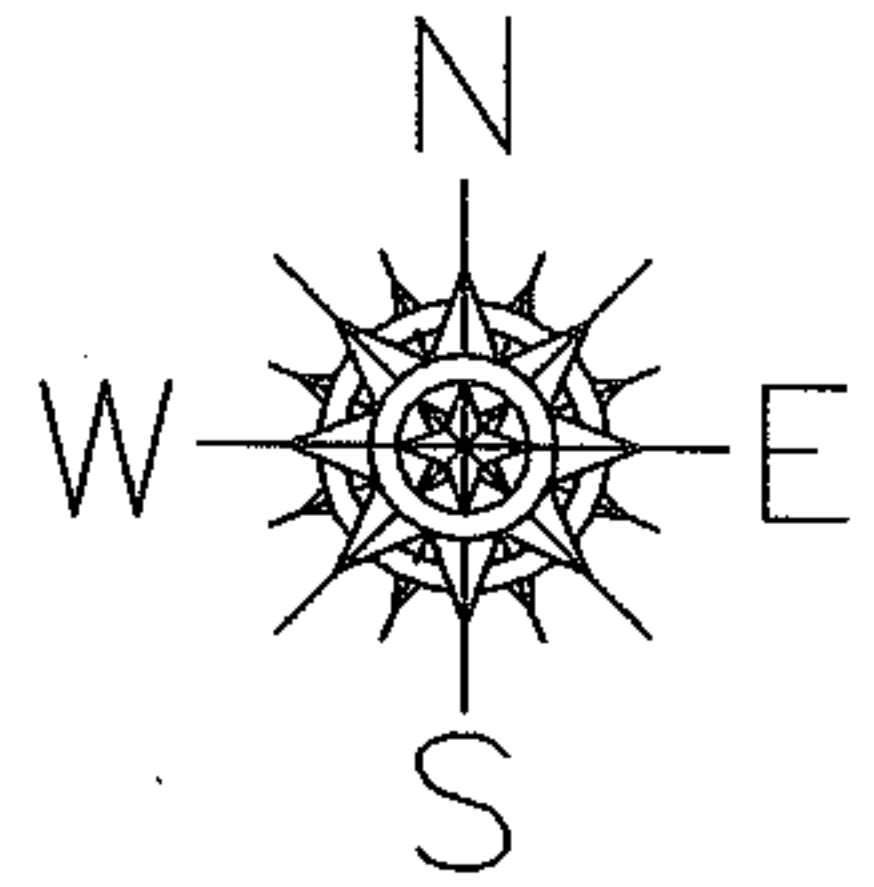

FERNDALE AVE.

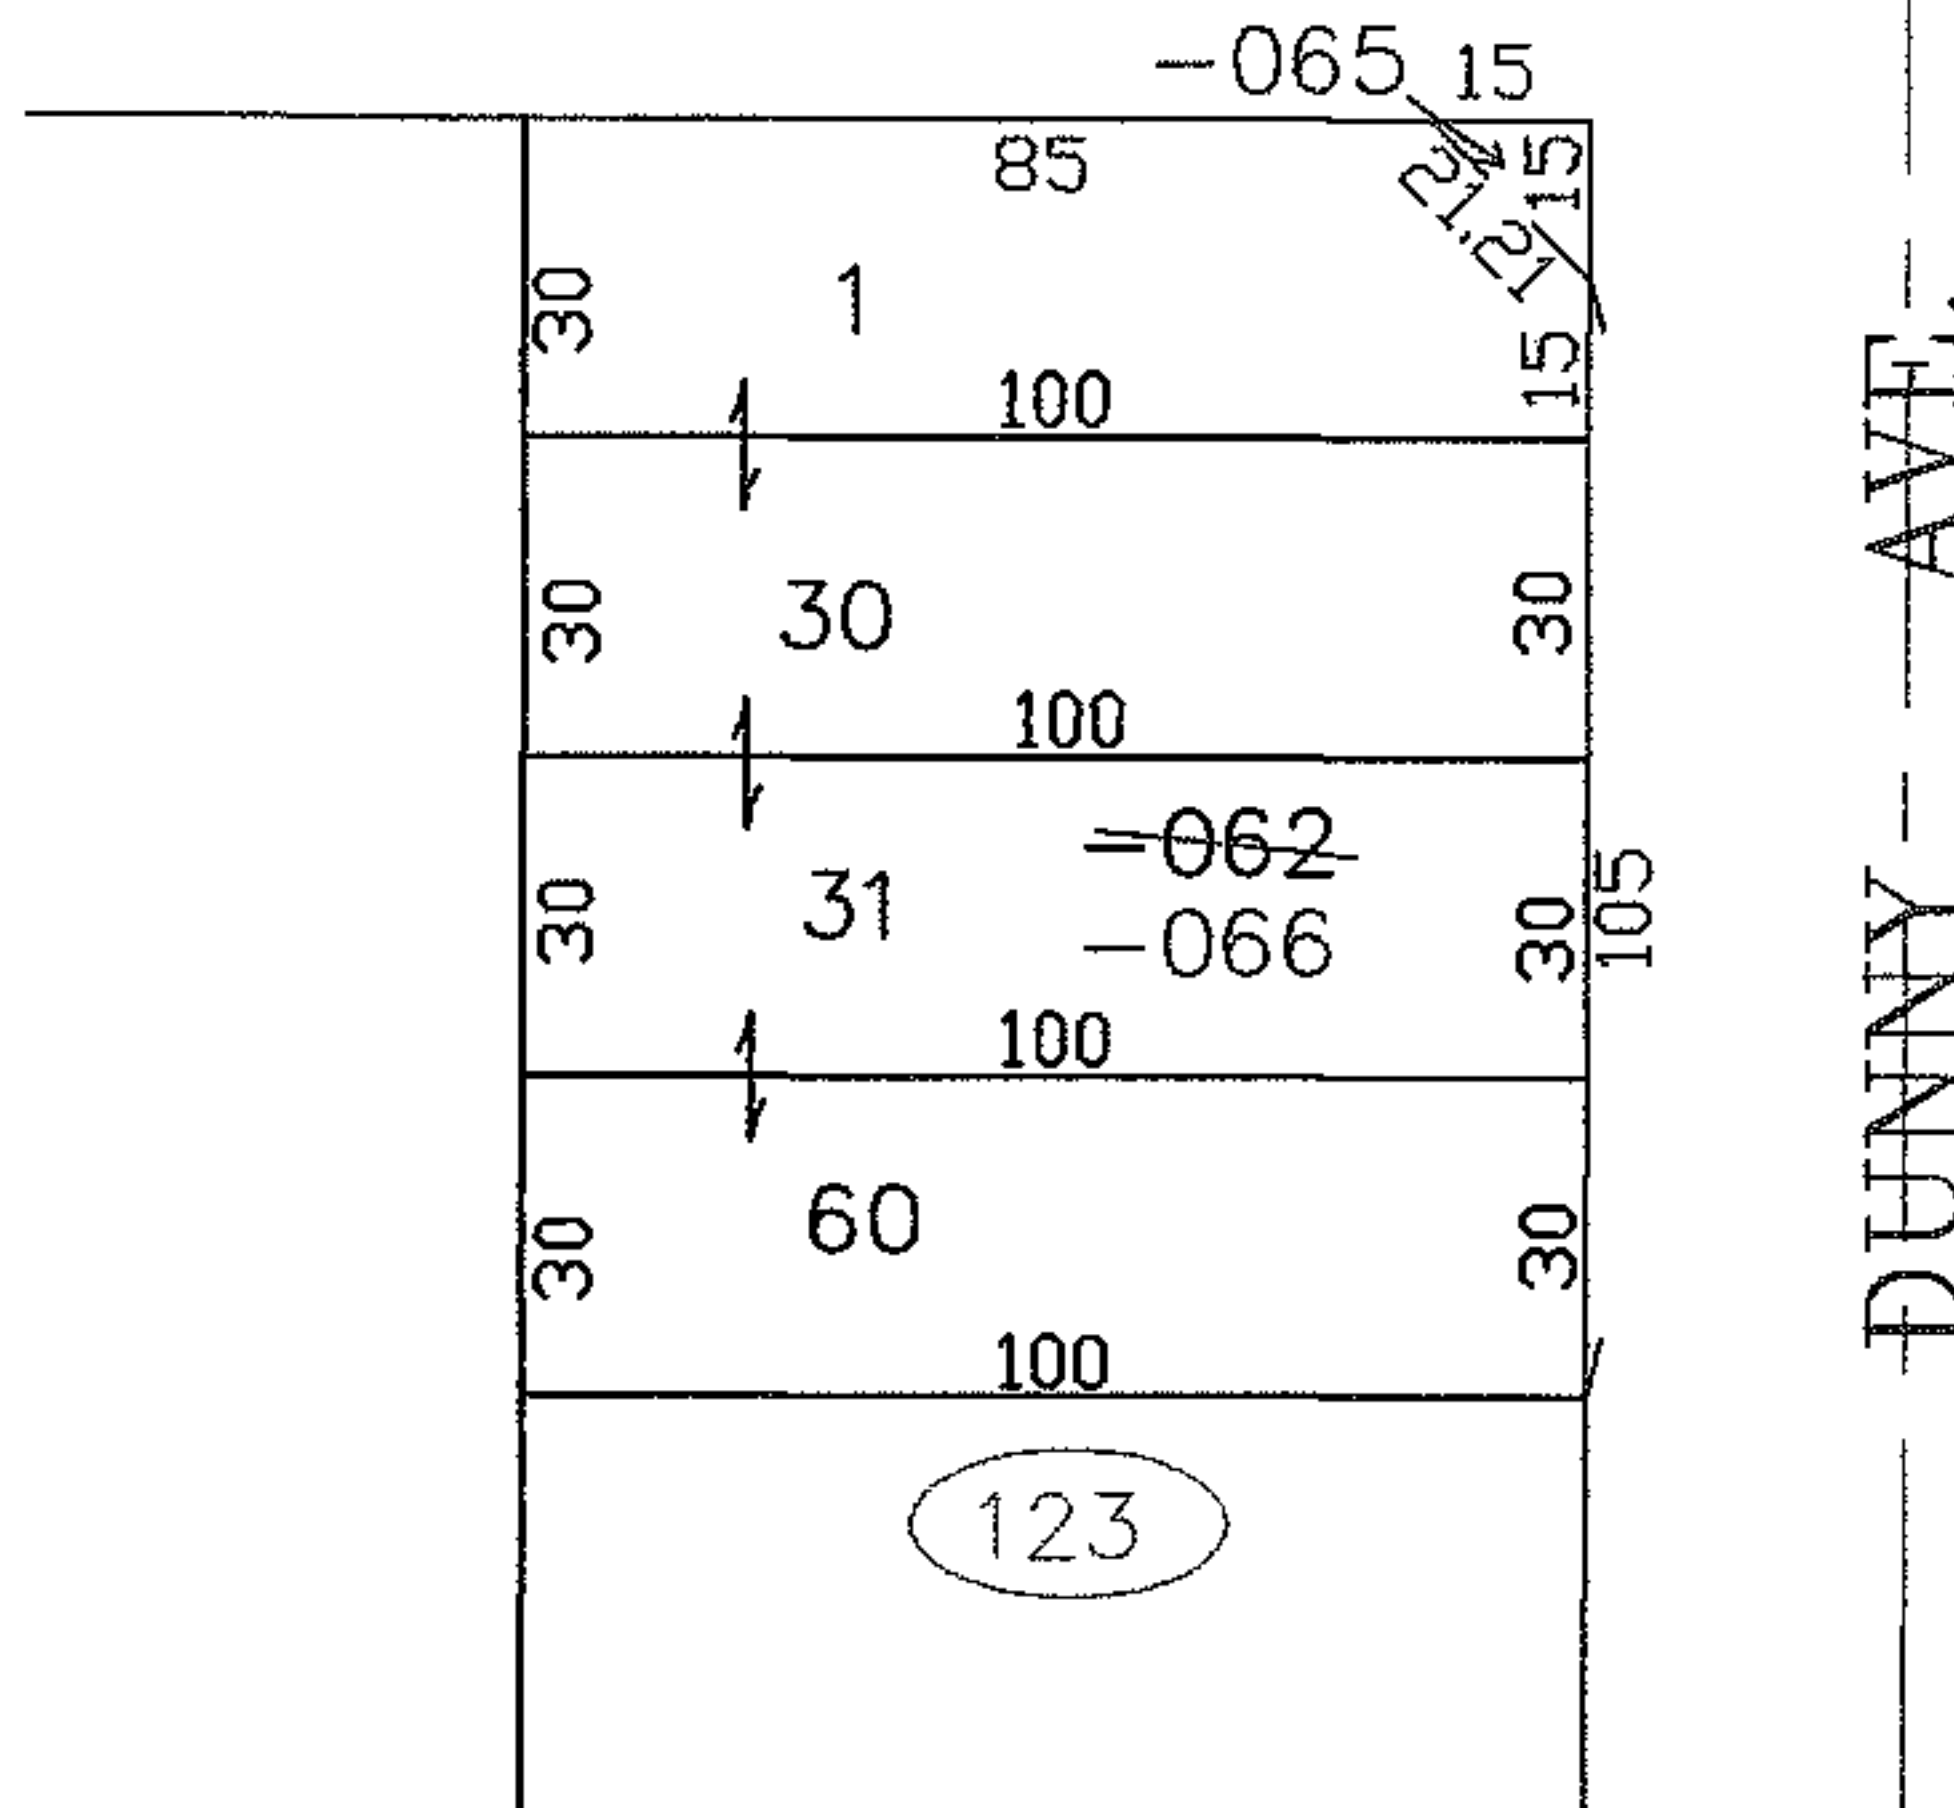

SPLITS/DEEDS PROCESSED

LORAIN COUNTY TAX MAP DEPARTMENT
226 MIDDLE AVE. ELYRIA, OHIO

SURVEYED BY: ROBERT J. MCAULEY

CLOSURE: 0.00 : 10.000

MAP PAGE(S): 03-00-040

APPROVED BY: JAH DATE: 1-28-03

SCALE: 1" = 50' PRIOR INSTRUMENT: 02 32 / 71

Raster