
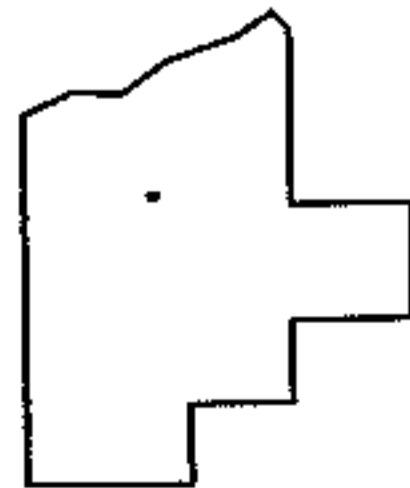
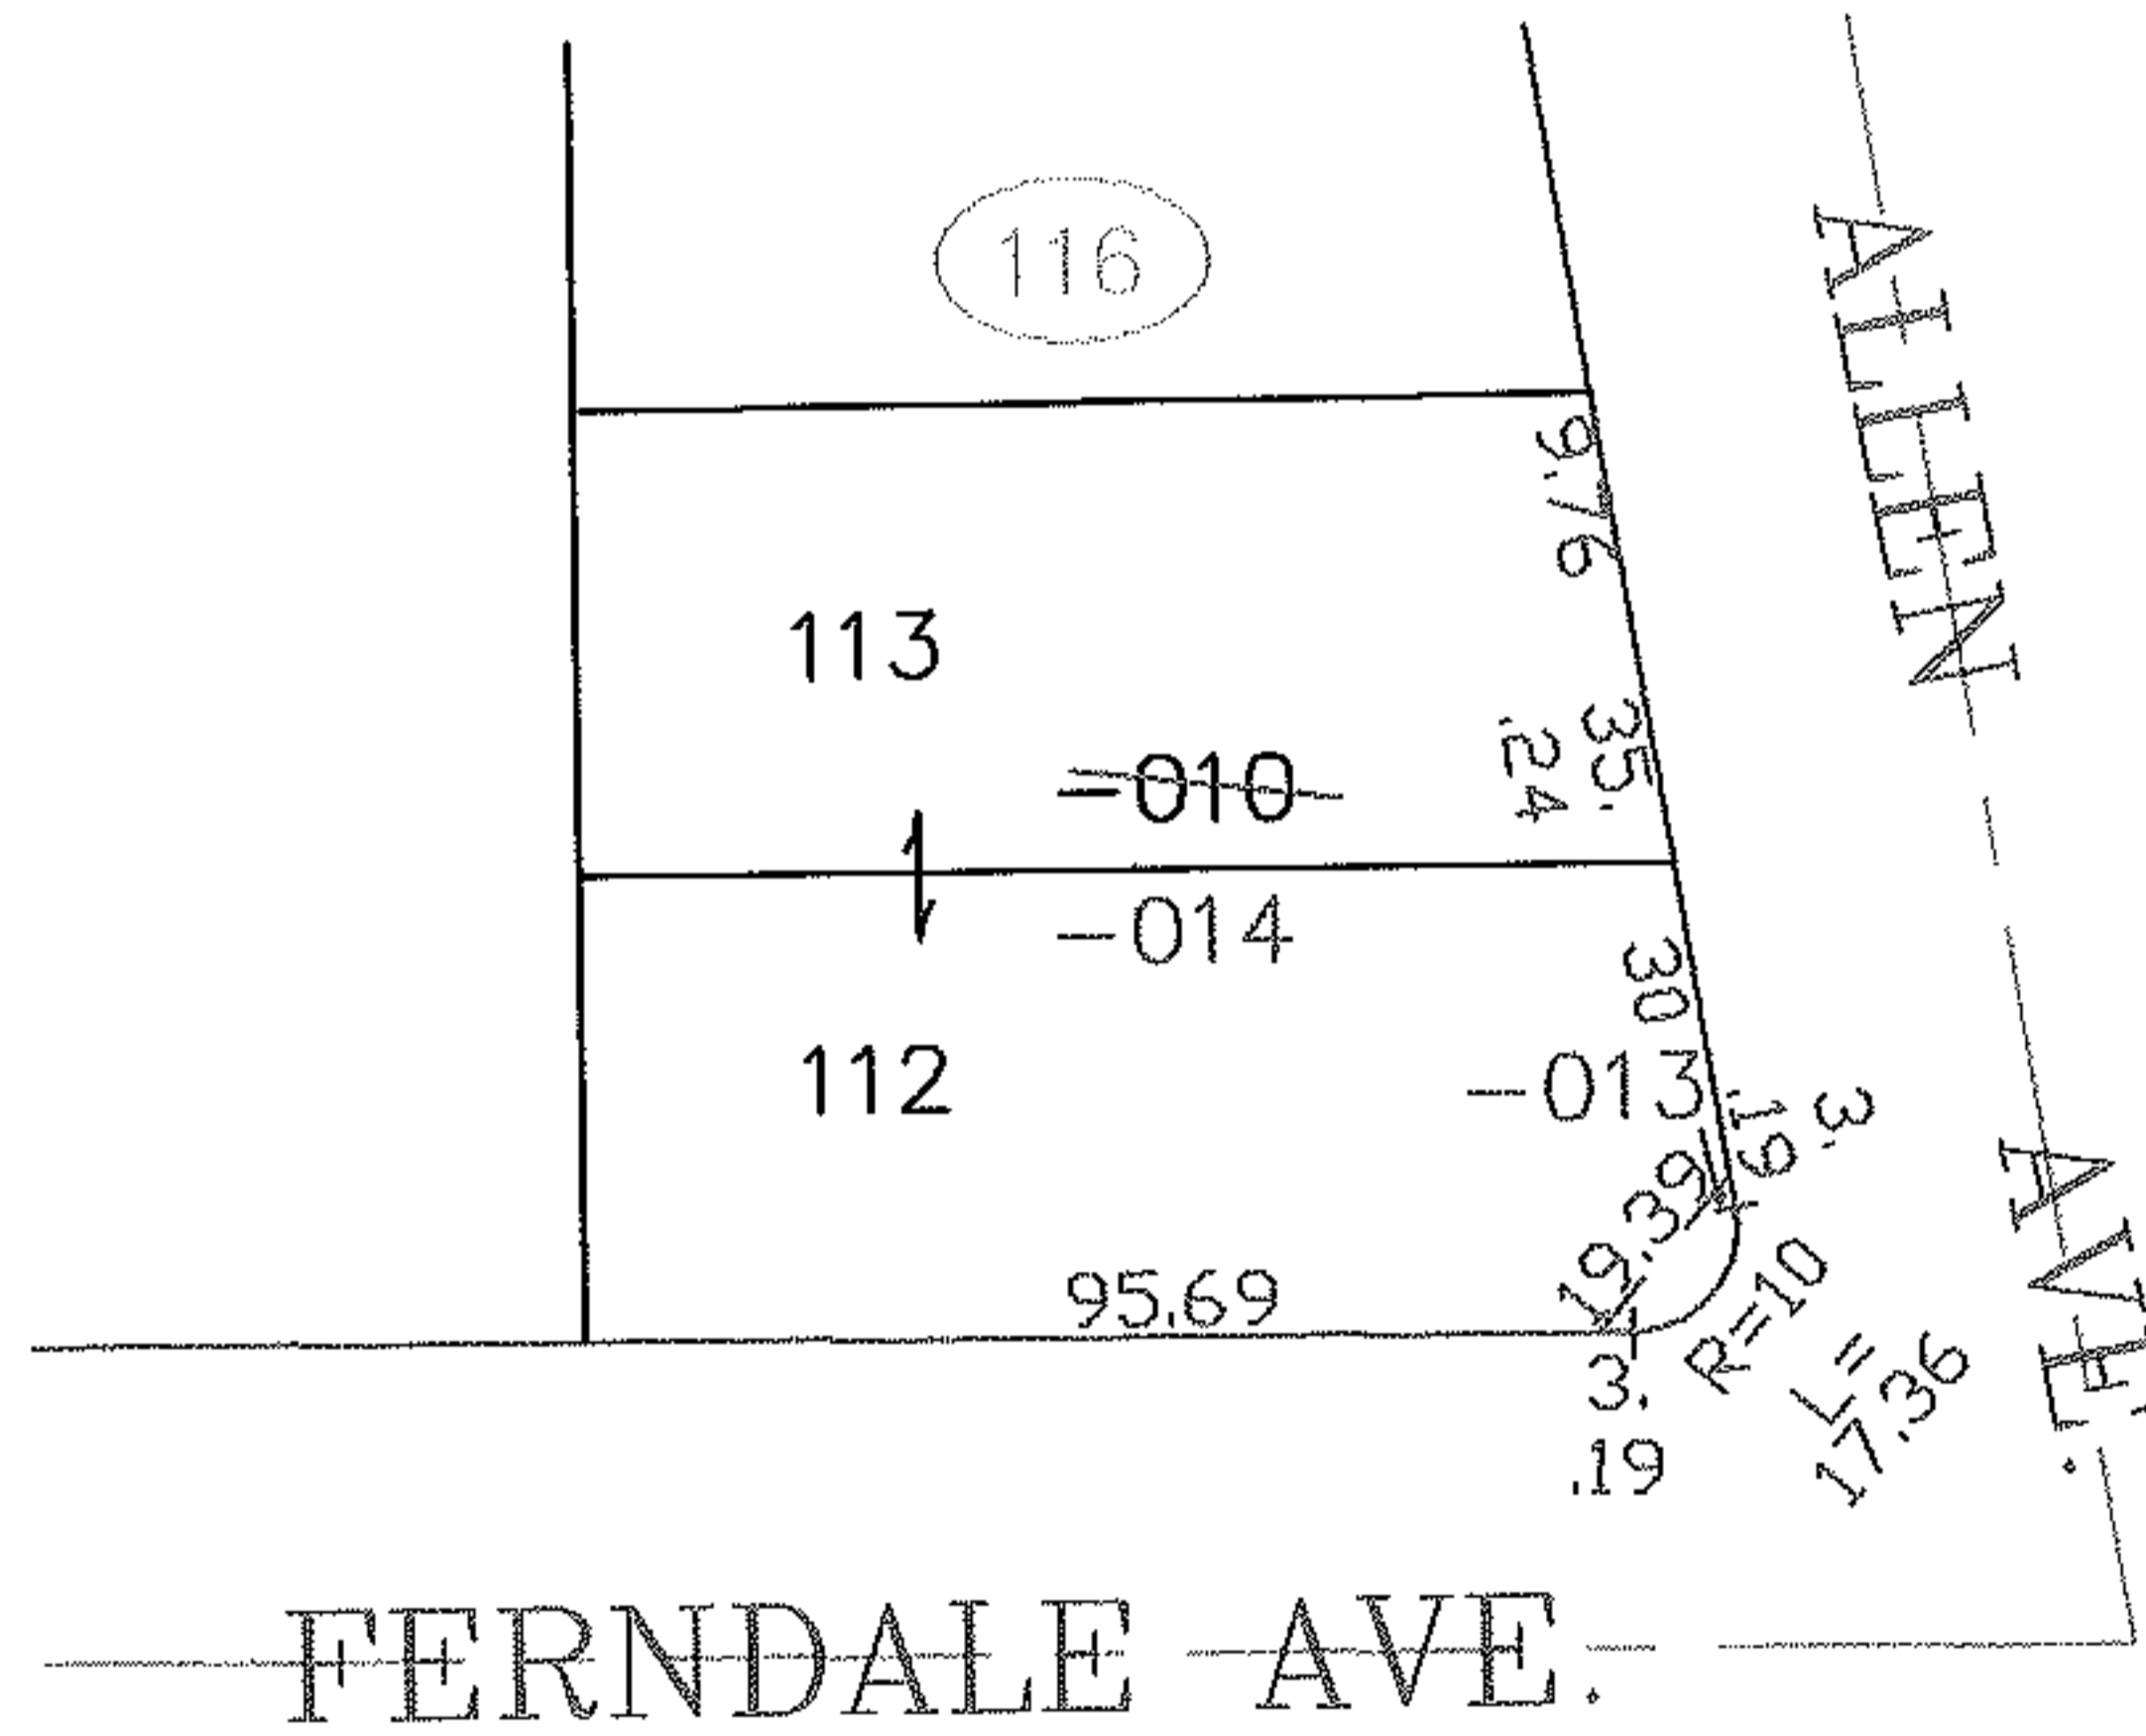


PARENT PARCEL: 03-00-040-116-010

CHILD PARCEL: 03-00-040-116-013, -014

STARTING POINT: SIDELINE OF FERNDALE AVE & ALLEN AVE.

NO. 00029

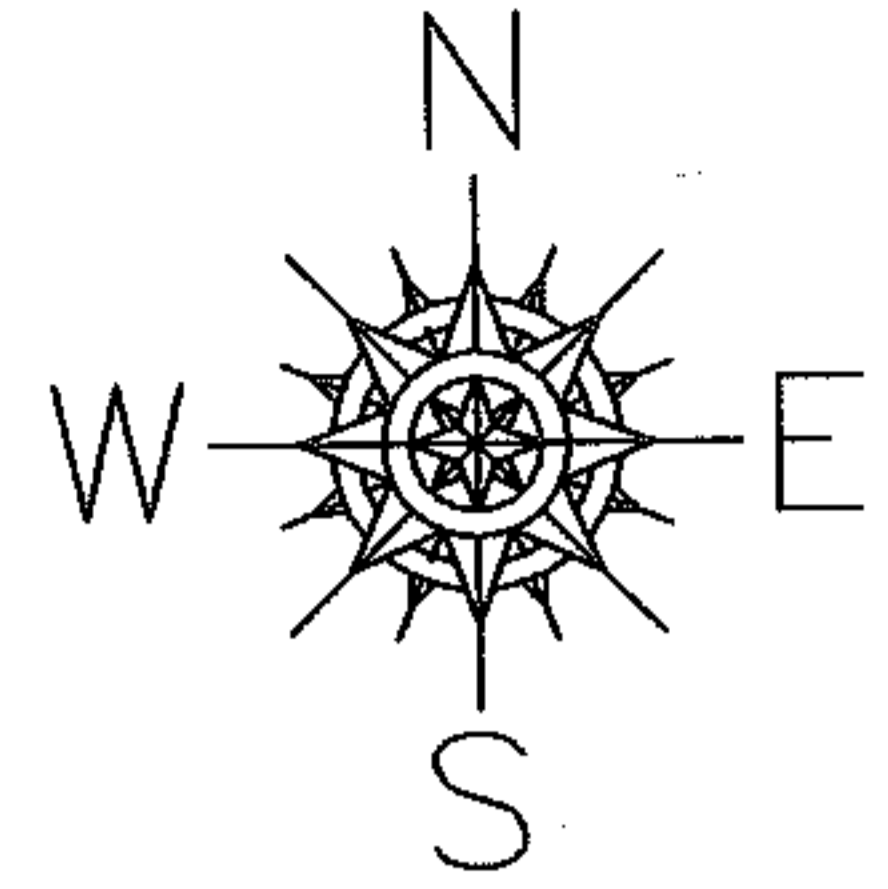

SPLITS/DEEDS PROCESSED
LORAIN COUNTY TAX MAP DEPARTMENT
 226 MIDDLE AVE. ELYRIA, OHIO

SURVEYED BY: ROBERT J. MCAULEY
 CLOSURE: 0.00 : 10.000
 MAP PAGE(S): 03-00-040
 APPROVED BY: JAH DATE: 02-03-03
 SCALE: 1" = 50' PRIOR INSTRUMENT: OR 1185/0091