
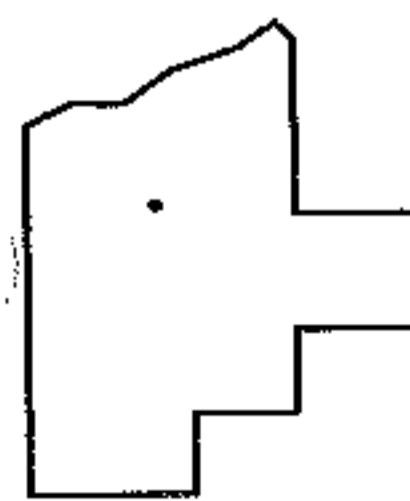
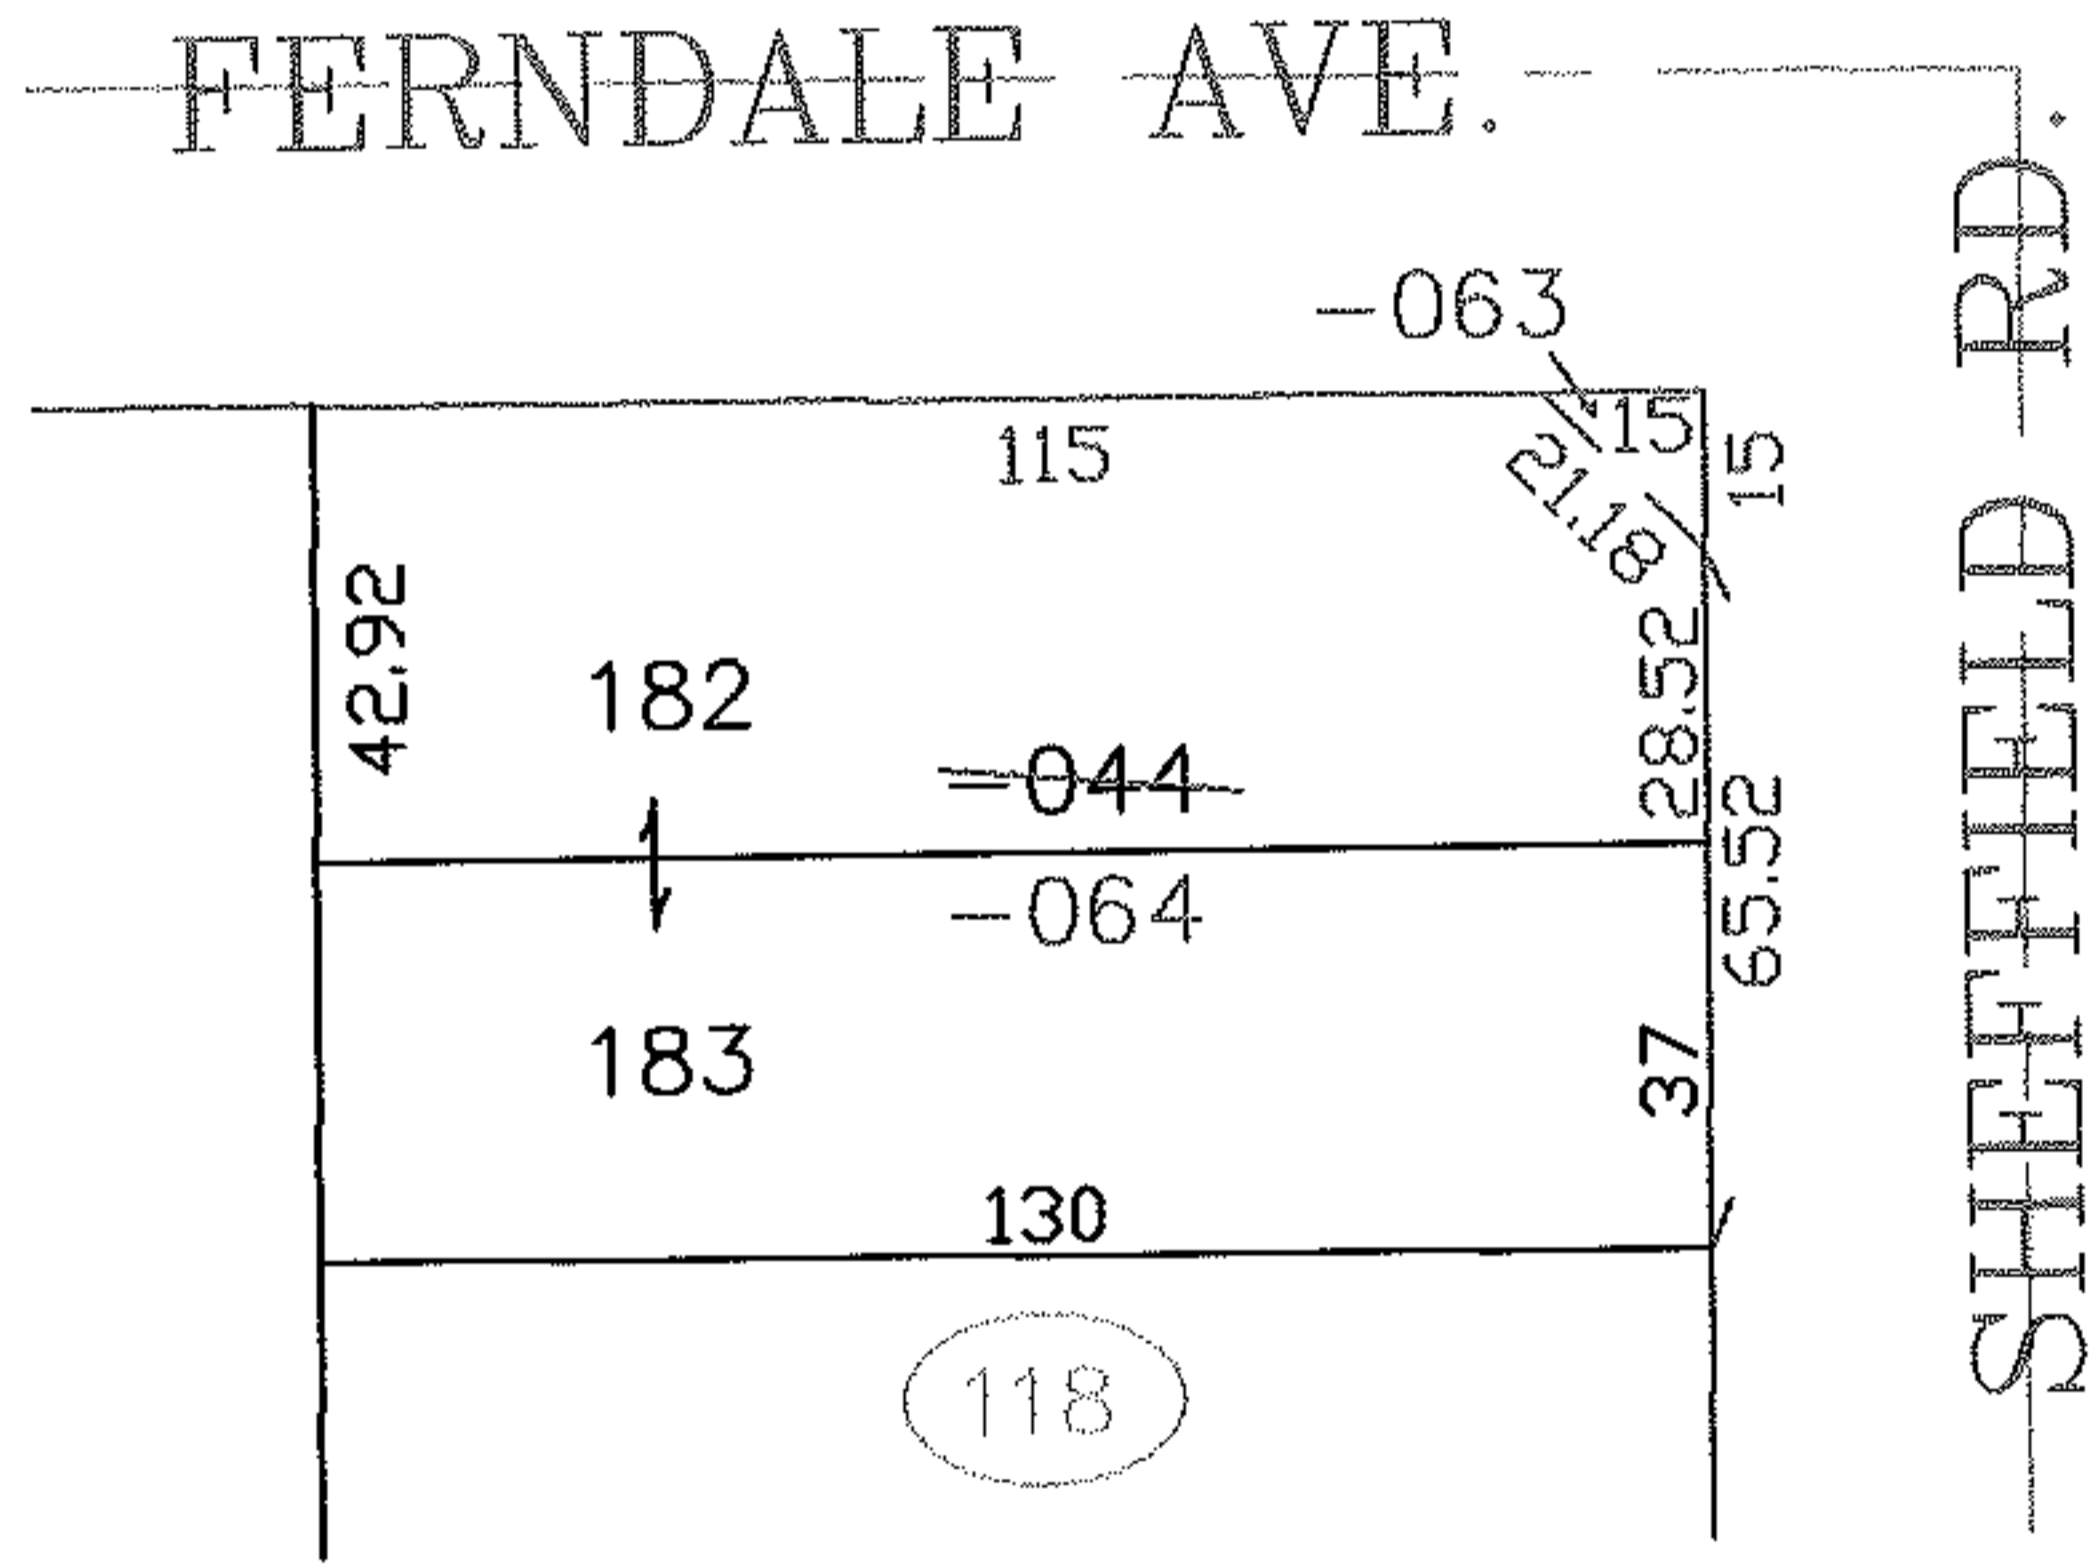


PARENT PARCEL: 03-00-041-118-044

CHILD PARCEL: 03-00-041-118-063, -064

STARTING POINT: SIDELINE OF FERNDALE AVE. & SHEFFIELD RD.

NO. 00030

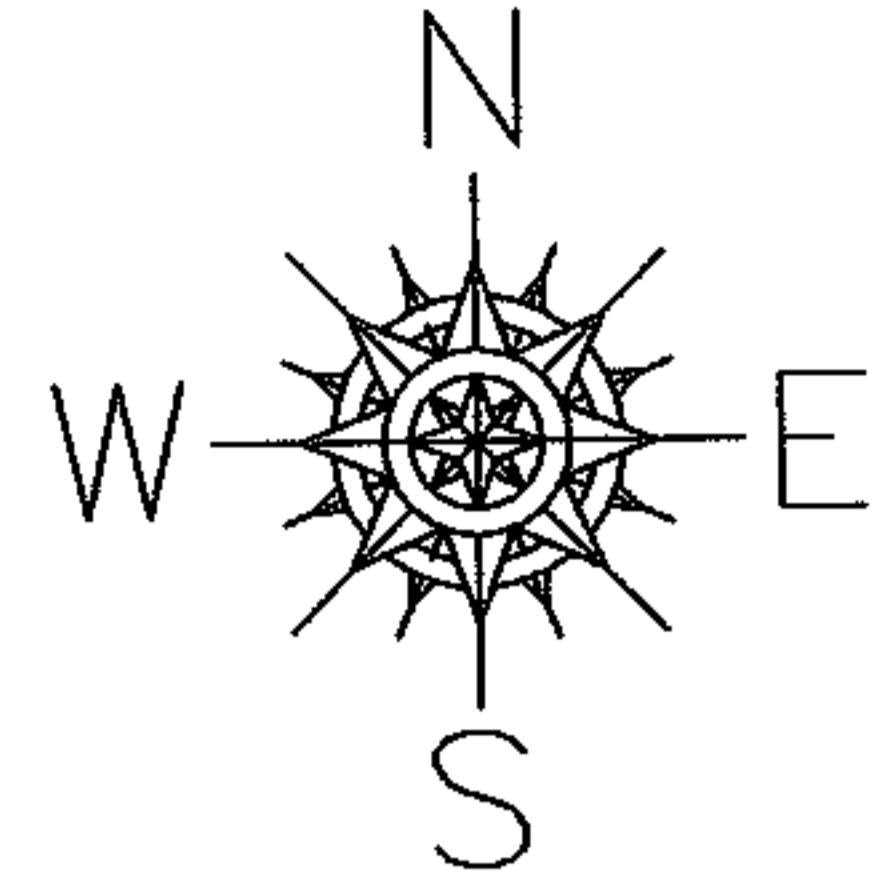

SPLITS/DEEDS PROCESSED
 LORAIN COUNTY TAX MAP DEPARTMENT
 226 MIDDLE AVE. ELYRIA, OHIO

SURVEYED BY: ROBERT J. MCAULEY
 CLOSURE: 0.00 : 10.000
 MAP PAGE(S): 03-00-041-A
 APPROVED BY: JAH DATE: 02-03-03
 SCALE: 1" = 50' PRIOR INSTRUMENT: 20020825693