
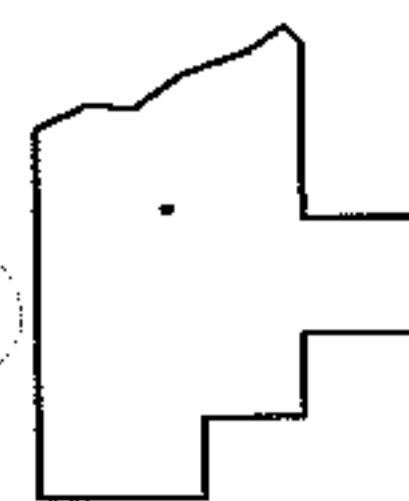
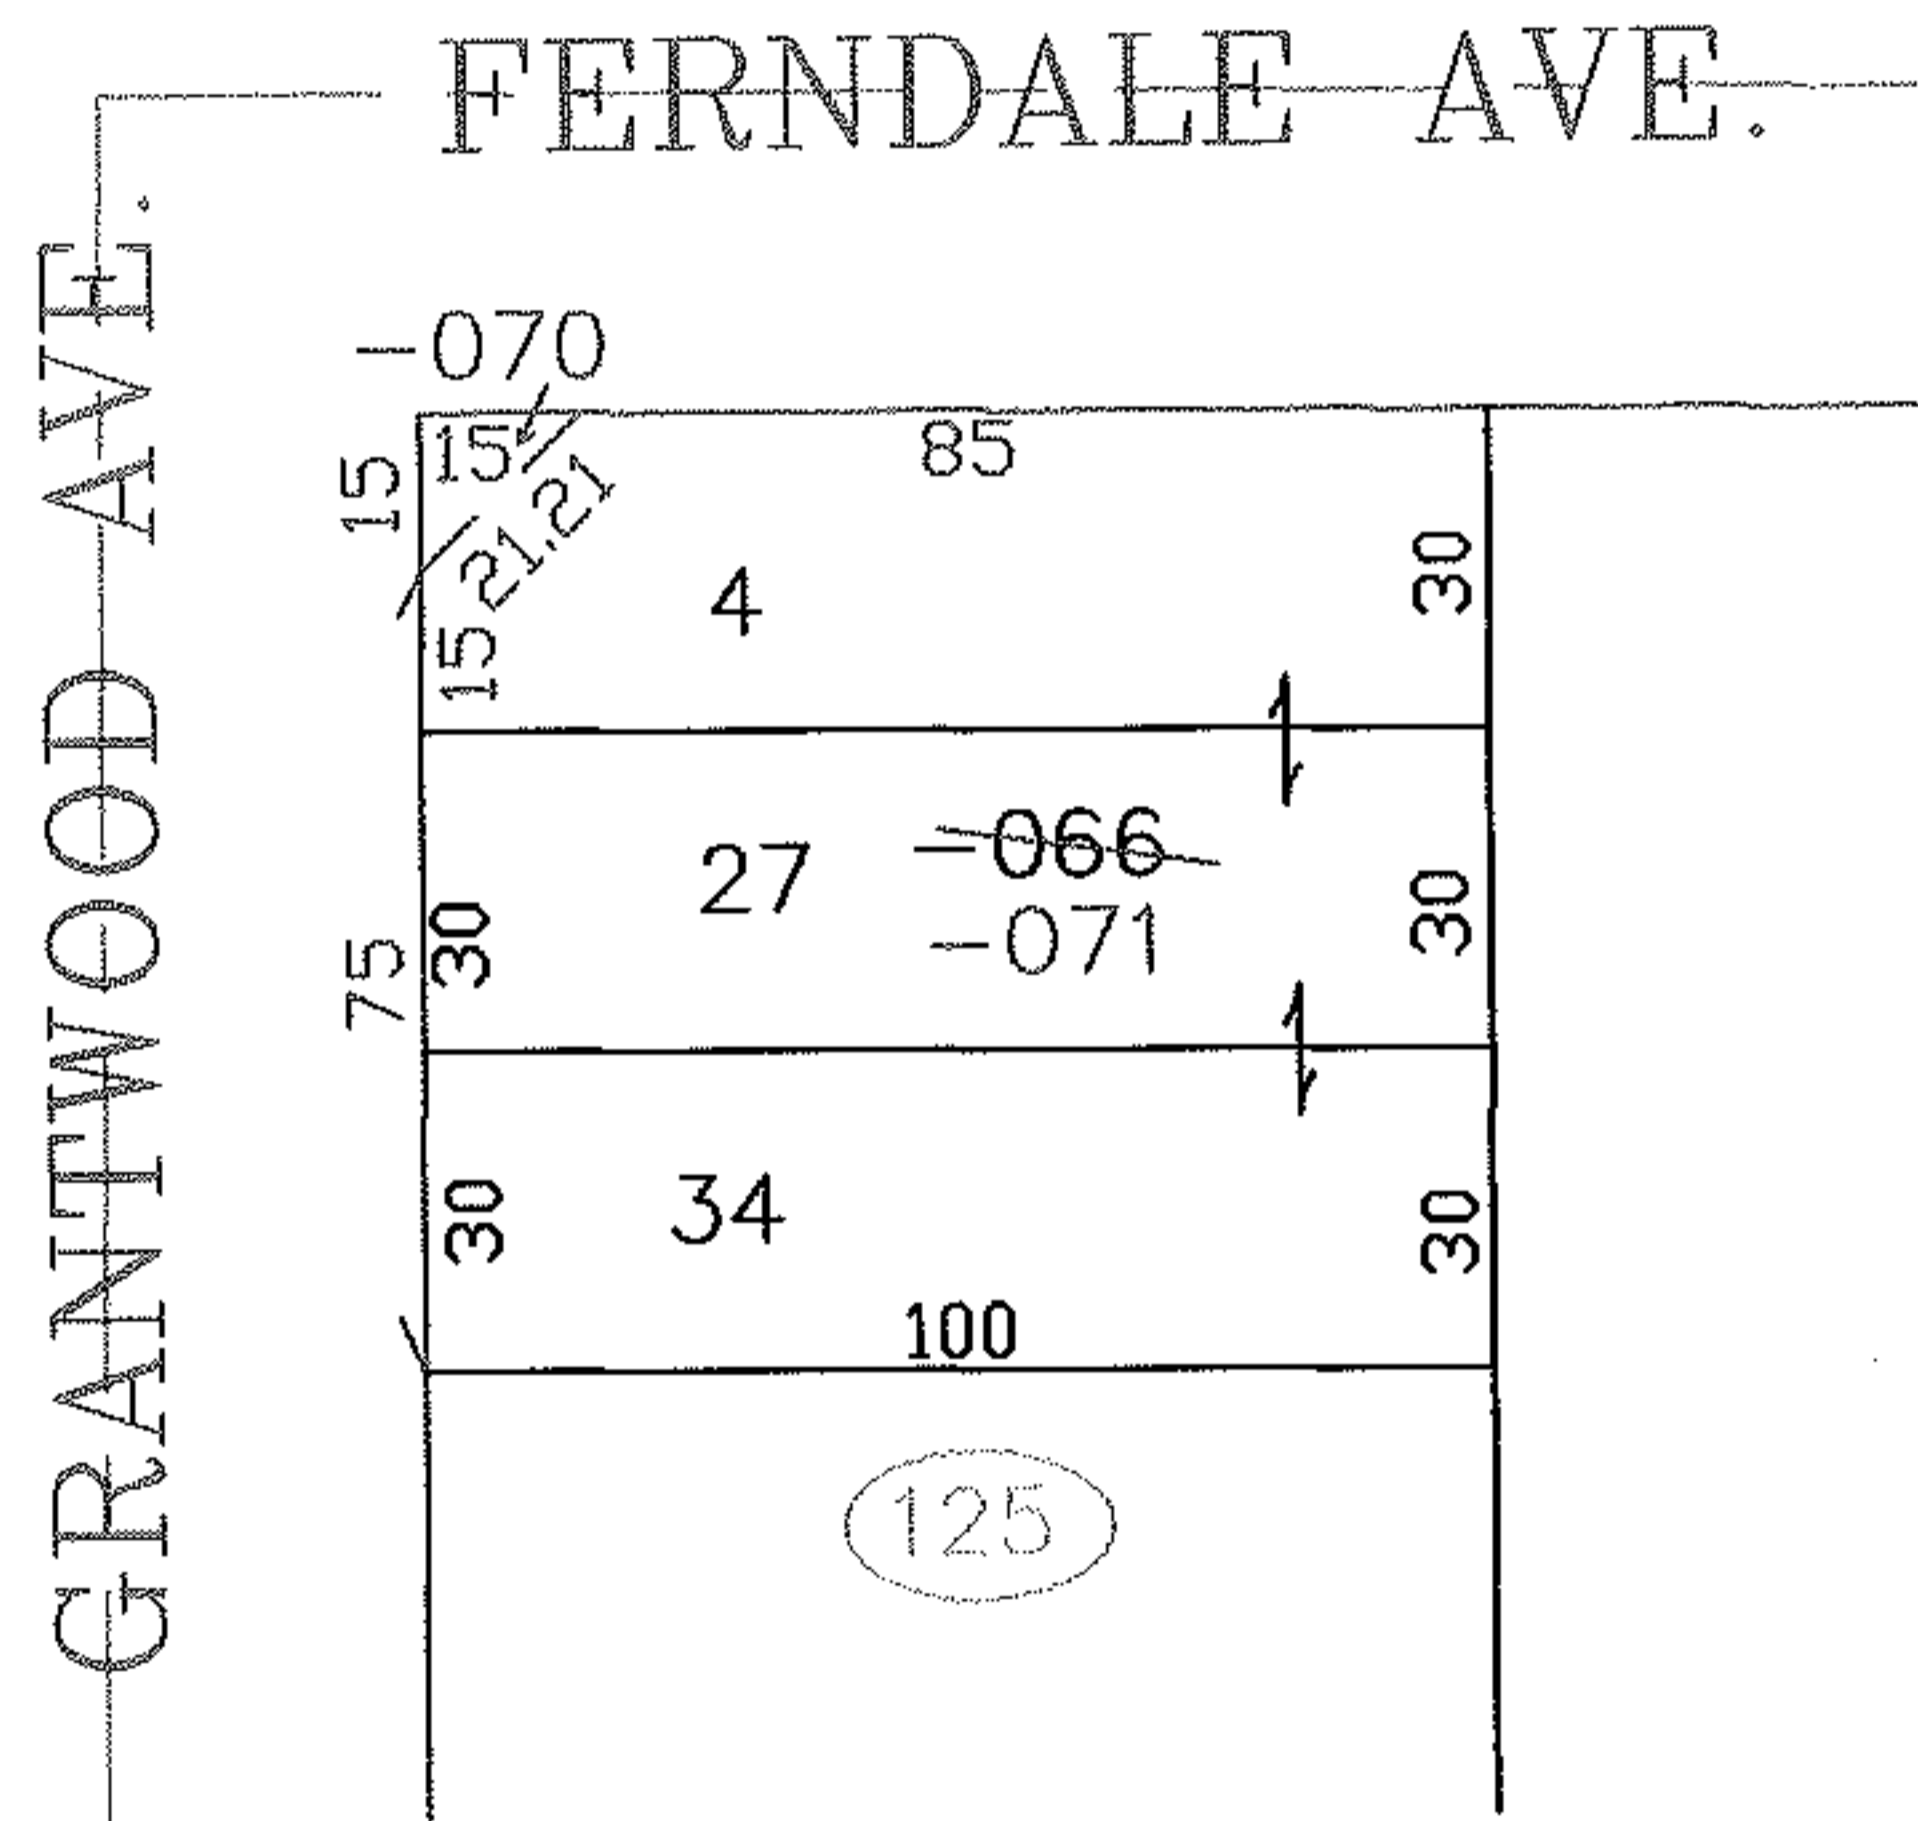


PARENT PARCEL: 03-00-040-125-066

CHILD PARCEL: 03-00-040-125-070, -071

STARTING POINT: SIDELINE OF FERNDALE AVE. & GRANTWOOD AVE.

NO. 00031

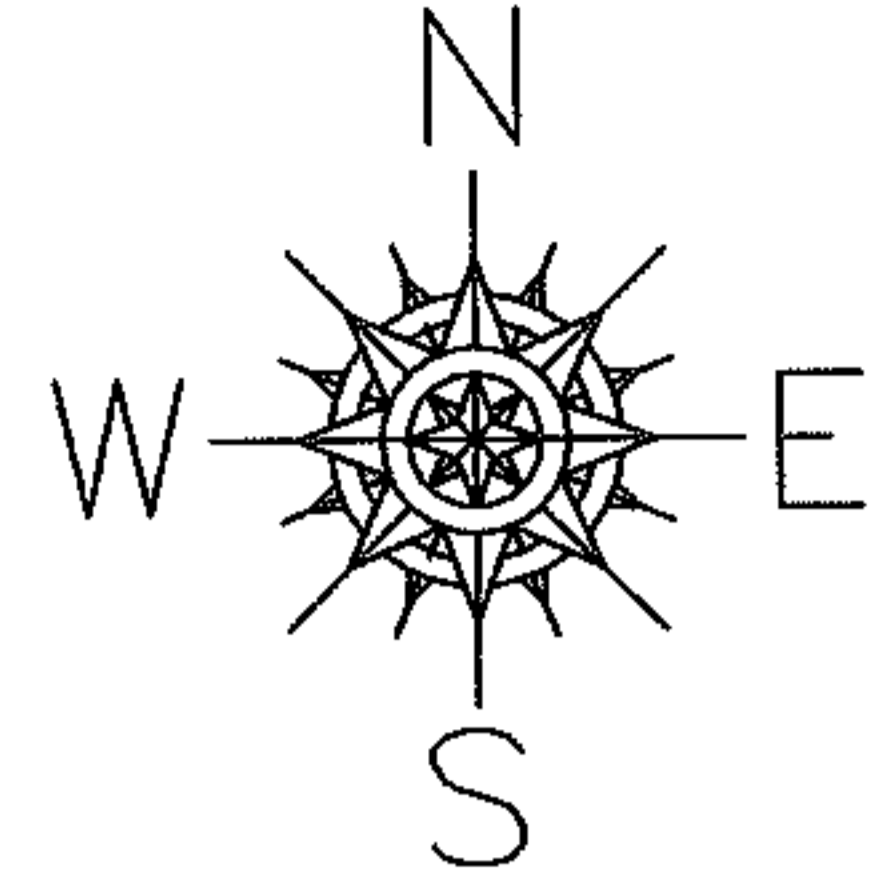

SPLITS/DEEDS PROCESSED
 LORAIN COUNTY TAX MAP DEPARTMENT
 226 MIDDLE AVE. ELYRIA, OHIO

SURVEYED BY: ROBERT J. MCAULEY
 CLOSURE: 0.00 : 10.000
 MAP PAGE(S): 03-00-040
 APPROVED BY: JAH DATE: 2-3-03
 SCALE: 1" = 50' PRIOR INSTRUMENT: 20010730541