
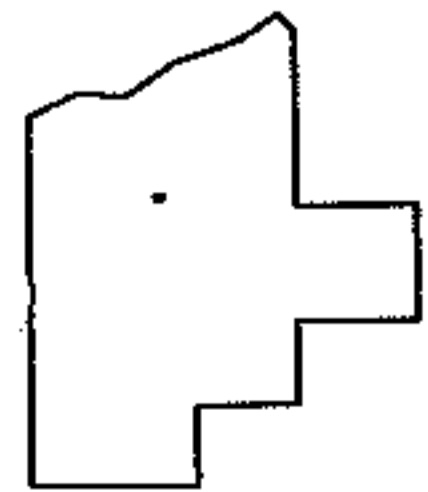
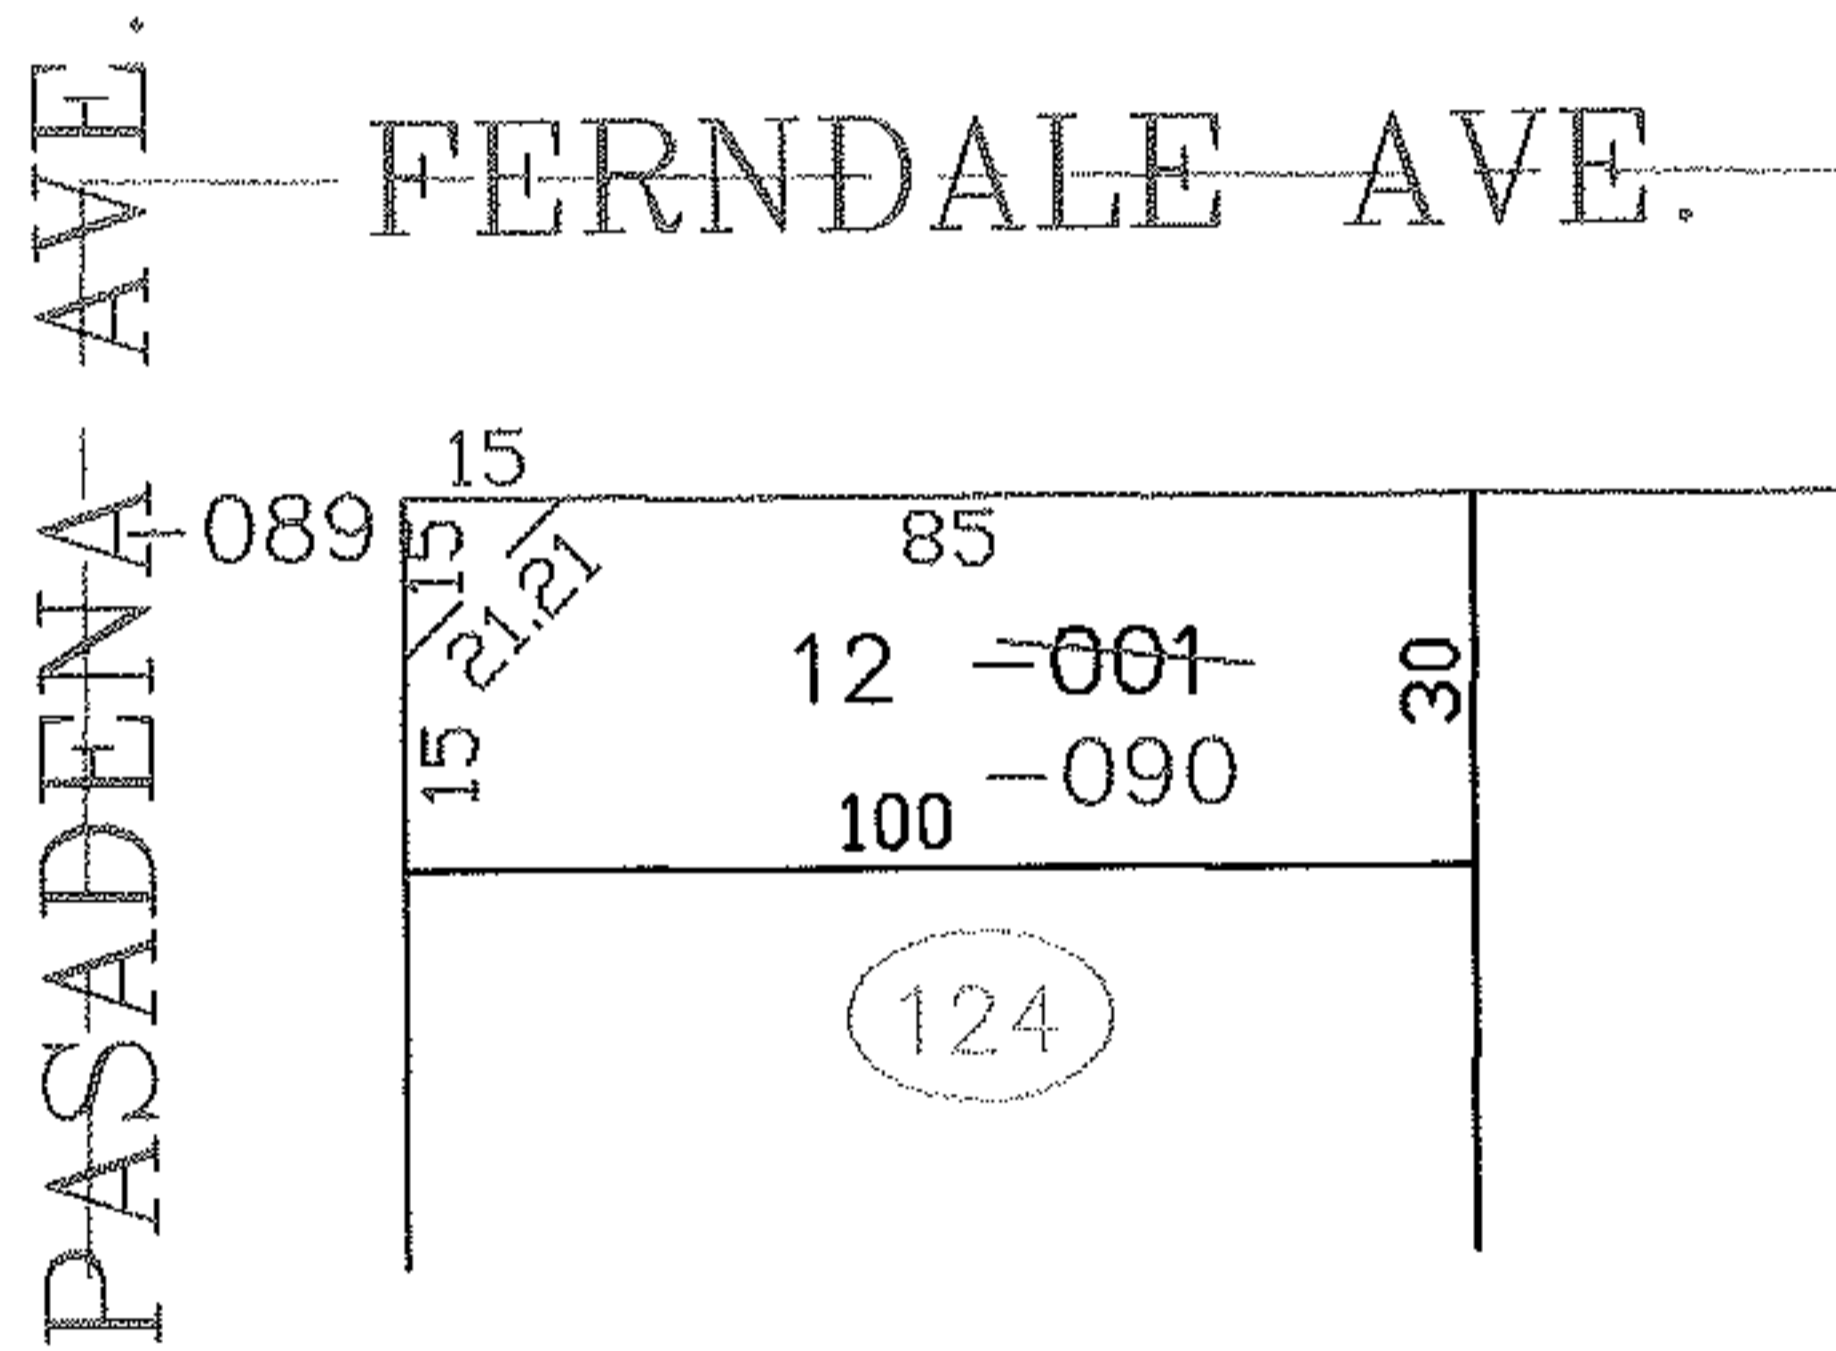


PARENT PARCEL: 03-00-039-124-001

CHILD PARCEL: 03-00-039-124-089, -090

STARTING POINT: SIDELINE OF FERNDALE AVE. & PASADENA AVE.

NO. 00033

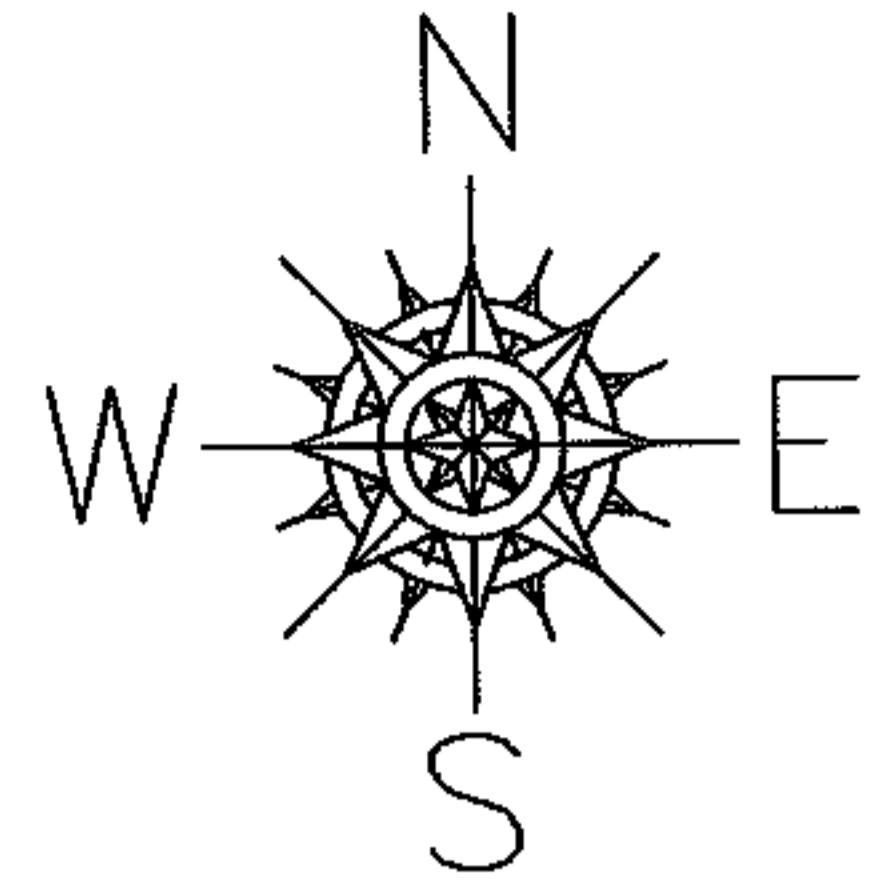

SPLITS/DEEDS PROCESSED
LORAIN COUNTY TAX MAP DEPARTMENT
226 MIDDLE AVE. ELYRIA, OHIO

SURVEYED BY: ROBERT J. MCAULEY
 CLOSURE: 0.00 : 10.000
 MAP PAGE(S): 03-00-039-B
 APPROVED BY: JAH DATE: 2-3-03
 SCALE: 1" = 50' PRIOR INSTRUMENT: 20010749449