


PARENT PARCEL: 03-00-038-122-063


CHILD PARCEL: 03-00-038-122-065, -066

STARTING POINT: SIDELINE OF FERNDALE AVE. & WEST SHORE BLVD.


NO. 00051

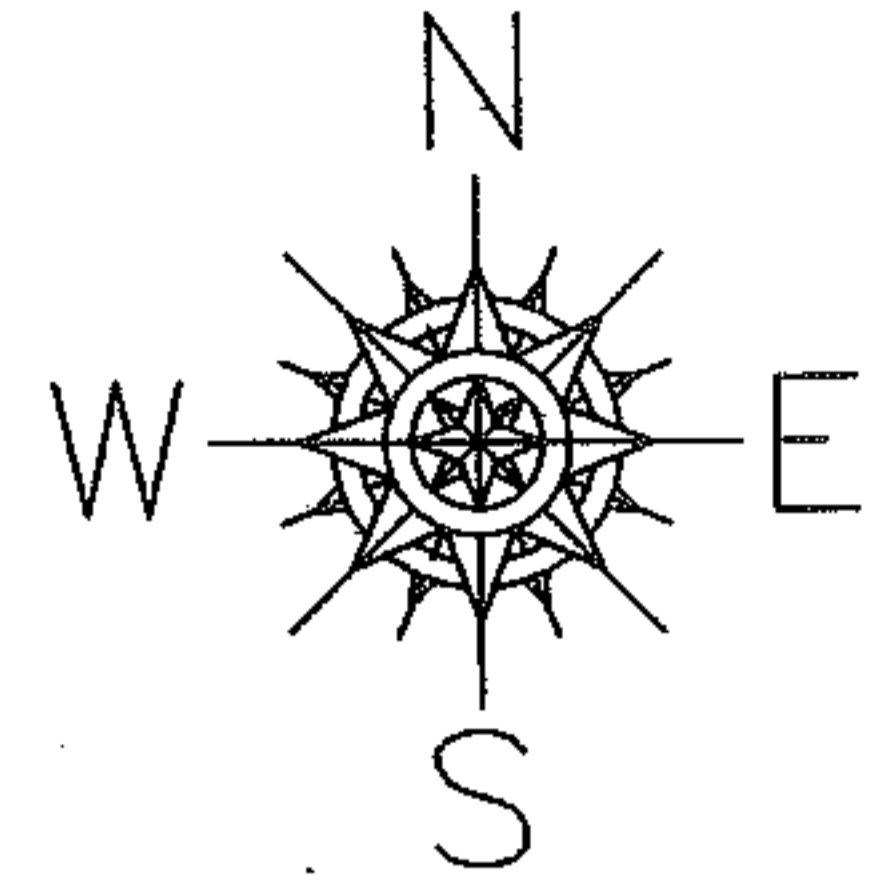

— FERNDALE AVE. —

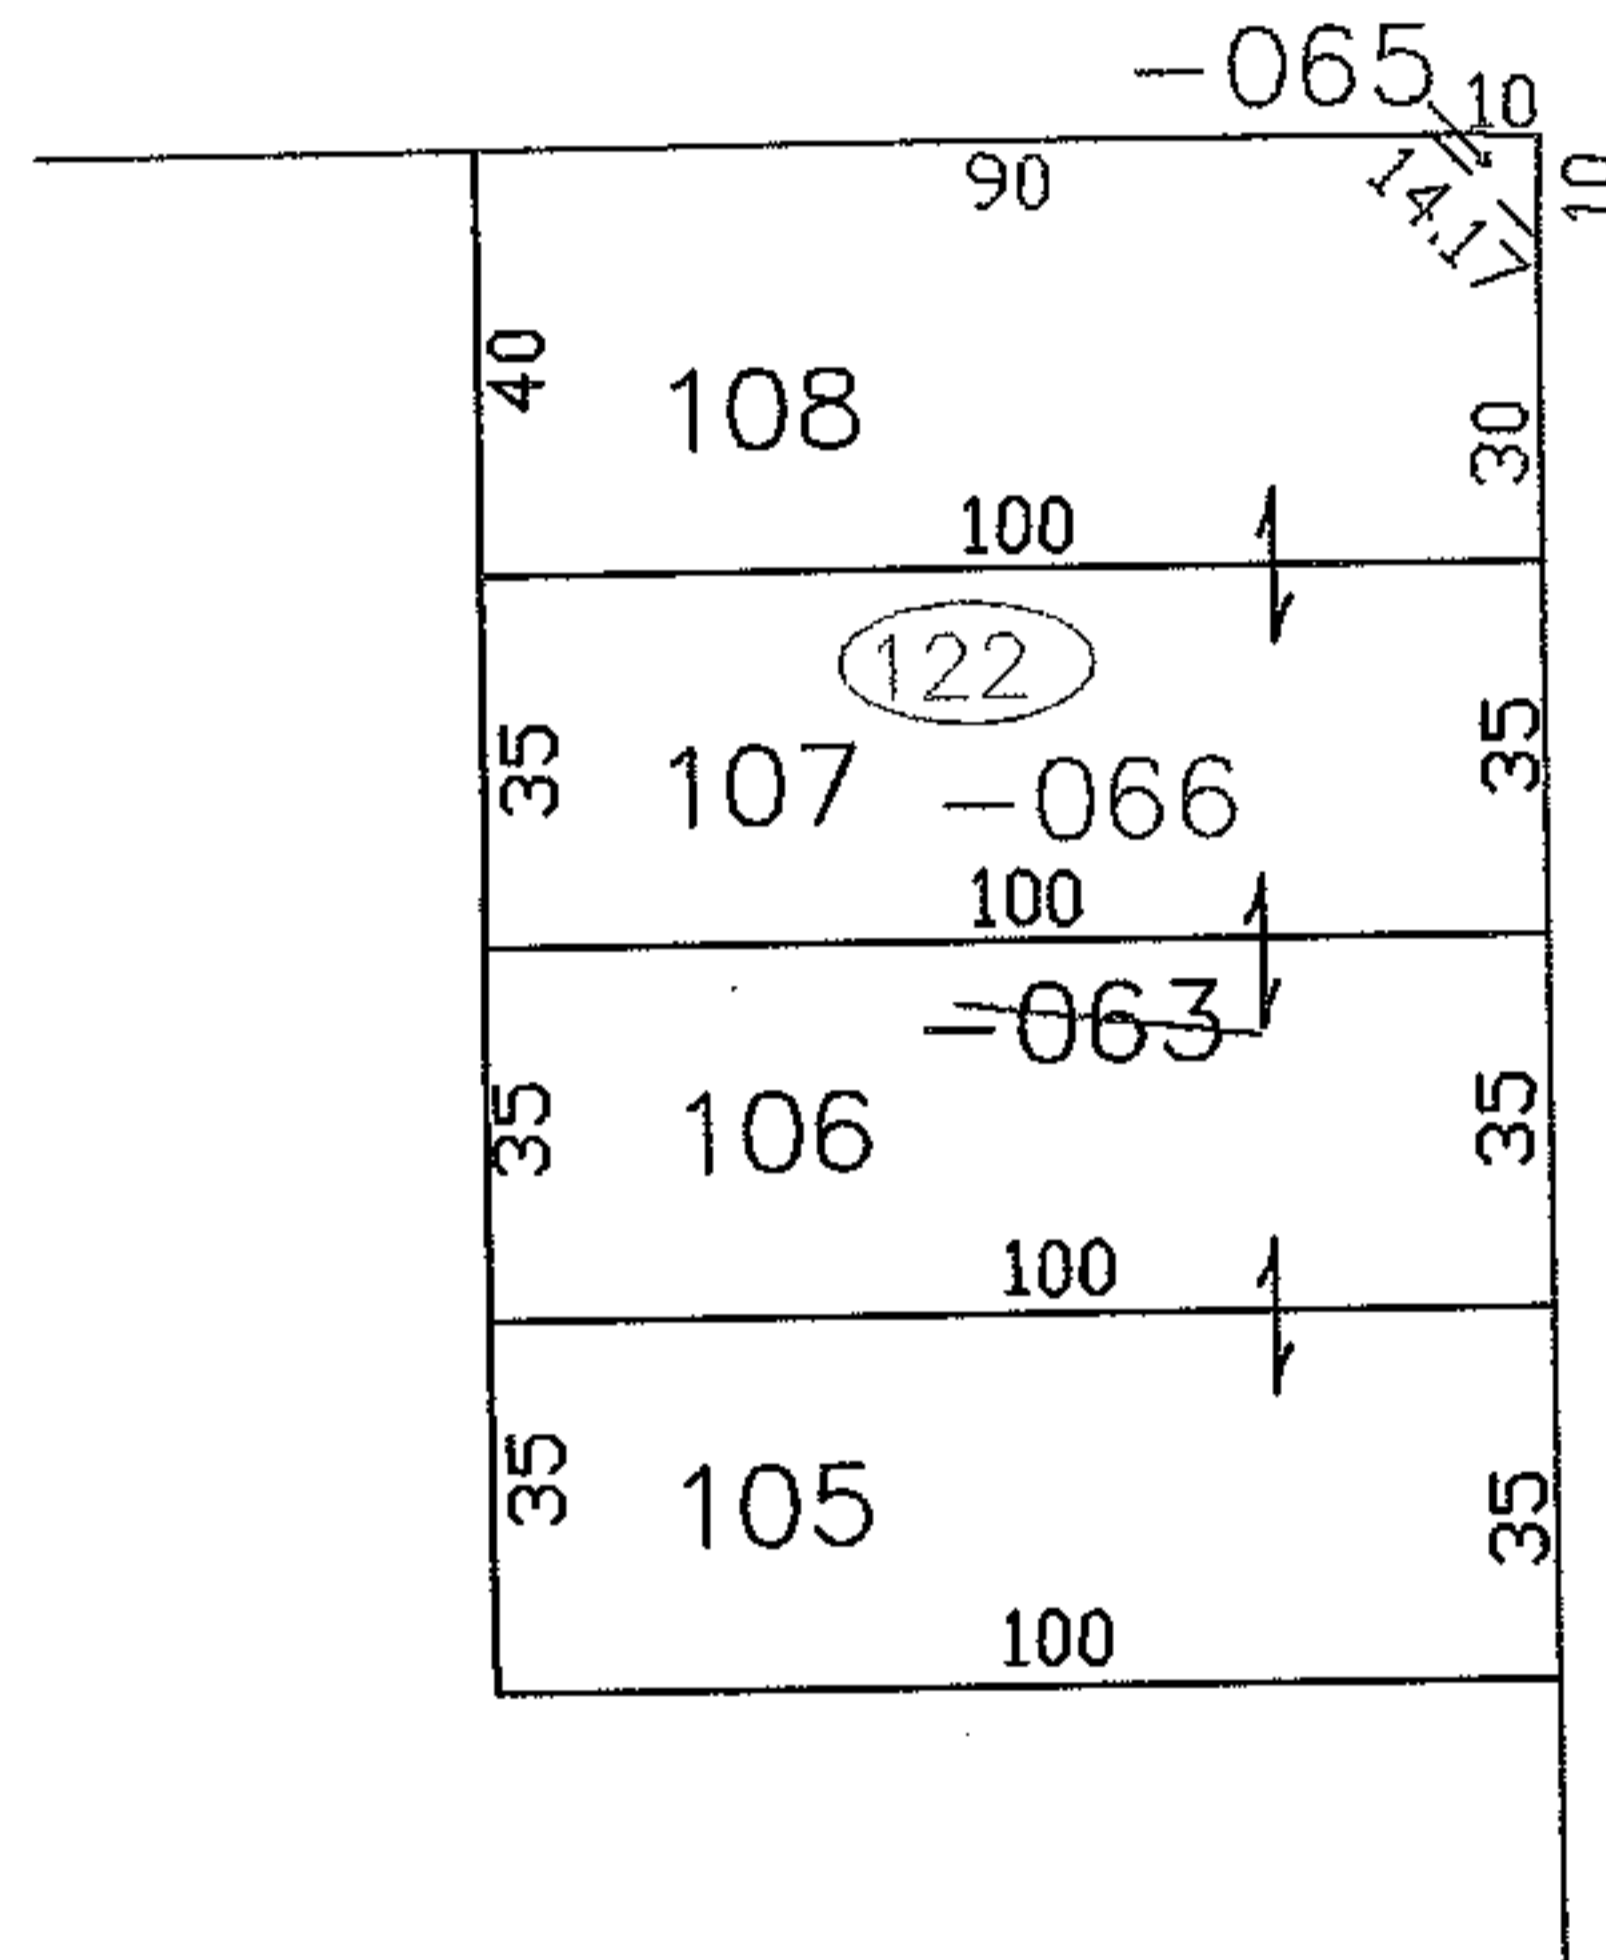

— WEST SHORE BLVD. —

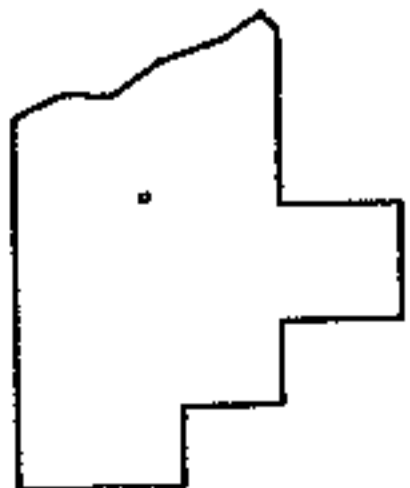

SPLITS/DEEDS PROCESSED
LORAIN COUNTY TAX MAP DEPARTMENT
226 MIDDLE AVE. ELYRIA, OHIO

SURVEYED BY: ROBERT J. MCAULEY

CLOSURE: 0.00 : 10.000

MAP PAGE(S): 03-00-038-B

APPROVED BY: JAH DATE: 3-18-03

SCALE: 1" = 50' PRIOR INSTRUMENT: DV 1406/39

Pastor