


PARENT PARCEL: 03-00-038-119-022


CHILD PARCEL: 03-00-038-119-066, -067

STARTING POINT: SIDELINE OF FERNDALE AVE. & WEST SHORE BLVD.

NO. 00054

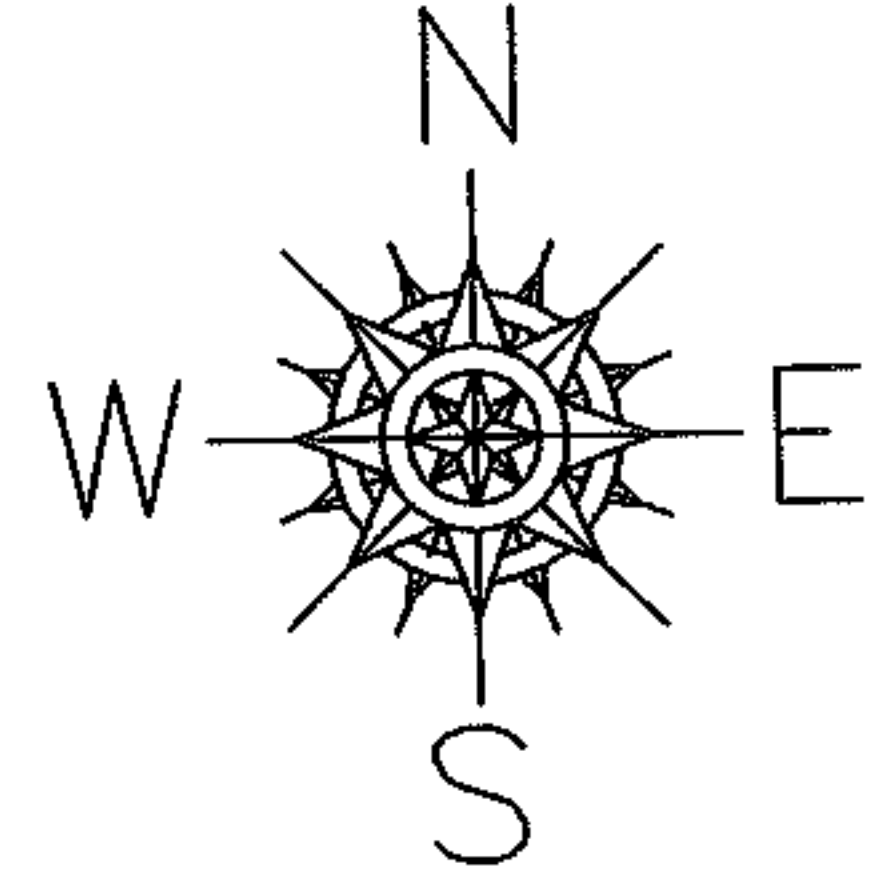

WEST SHORE BLVD.

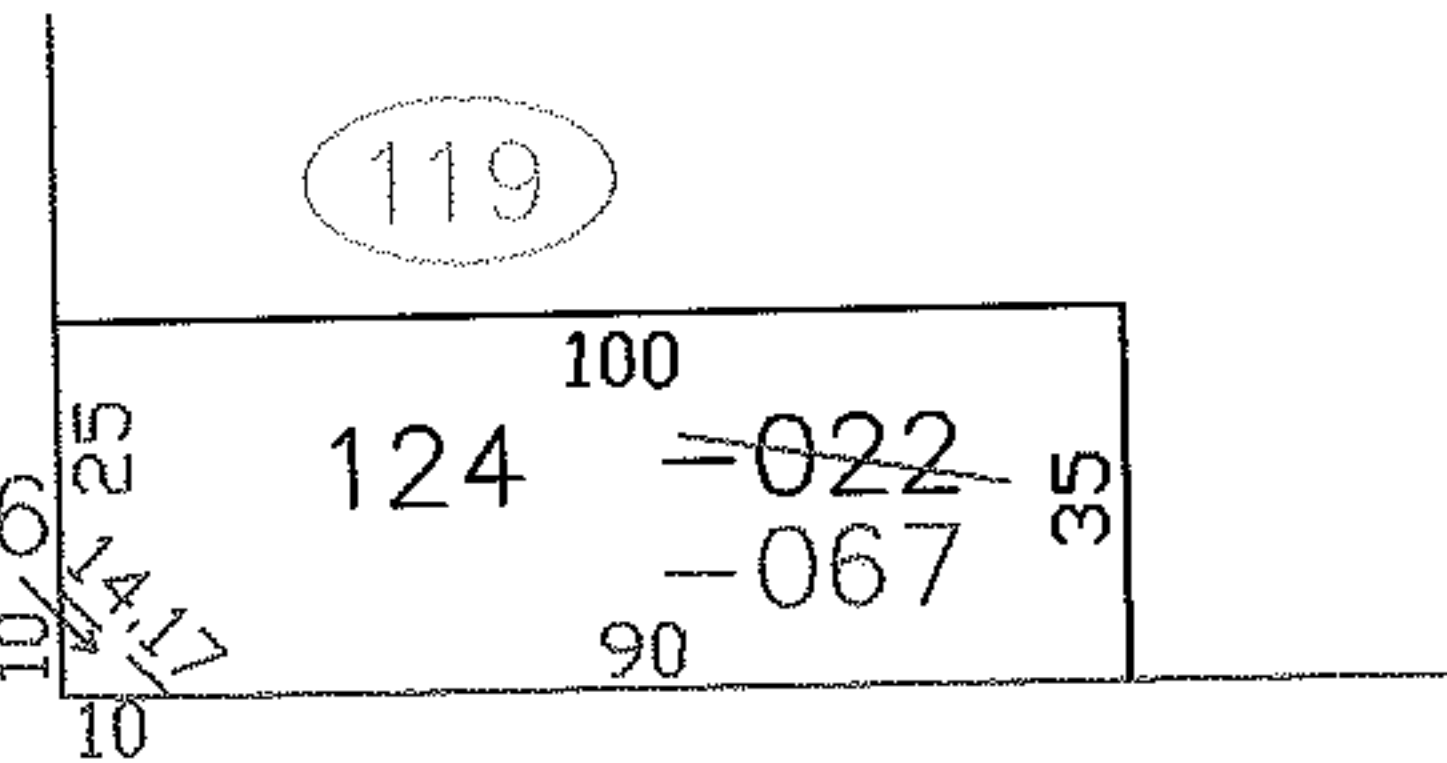

FERNDALE AVE.

SPLITS/DEEDS PROCESSED
 COUNTY TAX MAP DEPARTMENT
 MIDDLE AVE. ELYRIA, OHIO

SURVEYED BY: ROBERT J. MCAULEY
 CLOSURE: 0.00 : 10.000
 MAP PAGE(S): 03-00-038-B
 APPROVED BY: JAH DATE: 3-19-03
 SCALE: 1" = 50' PRIOR INSTRUMENT: 19980569480