
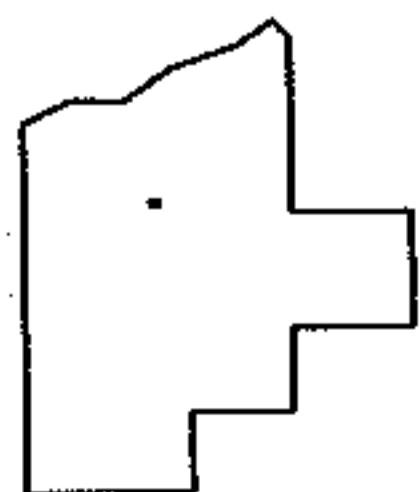
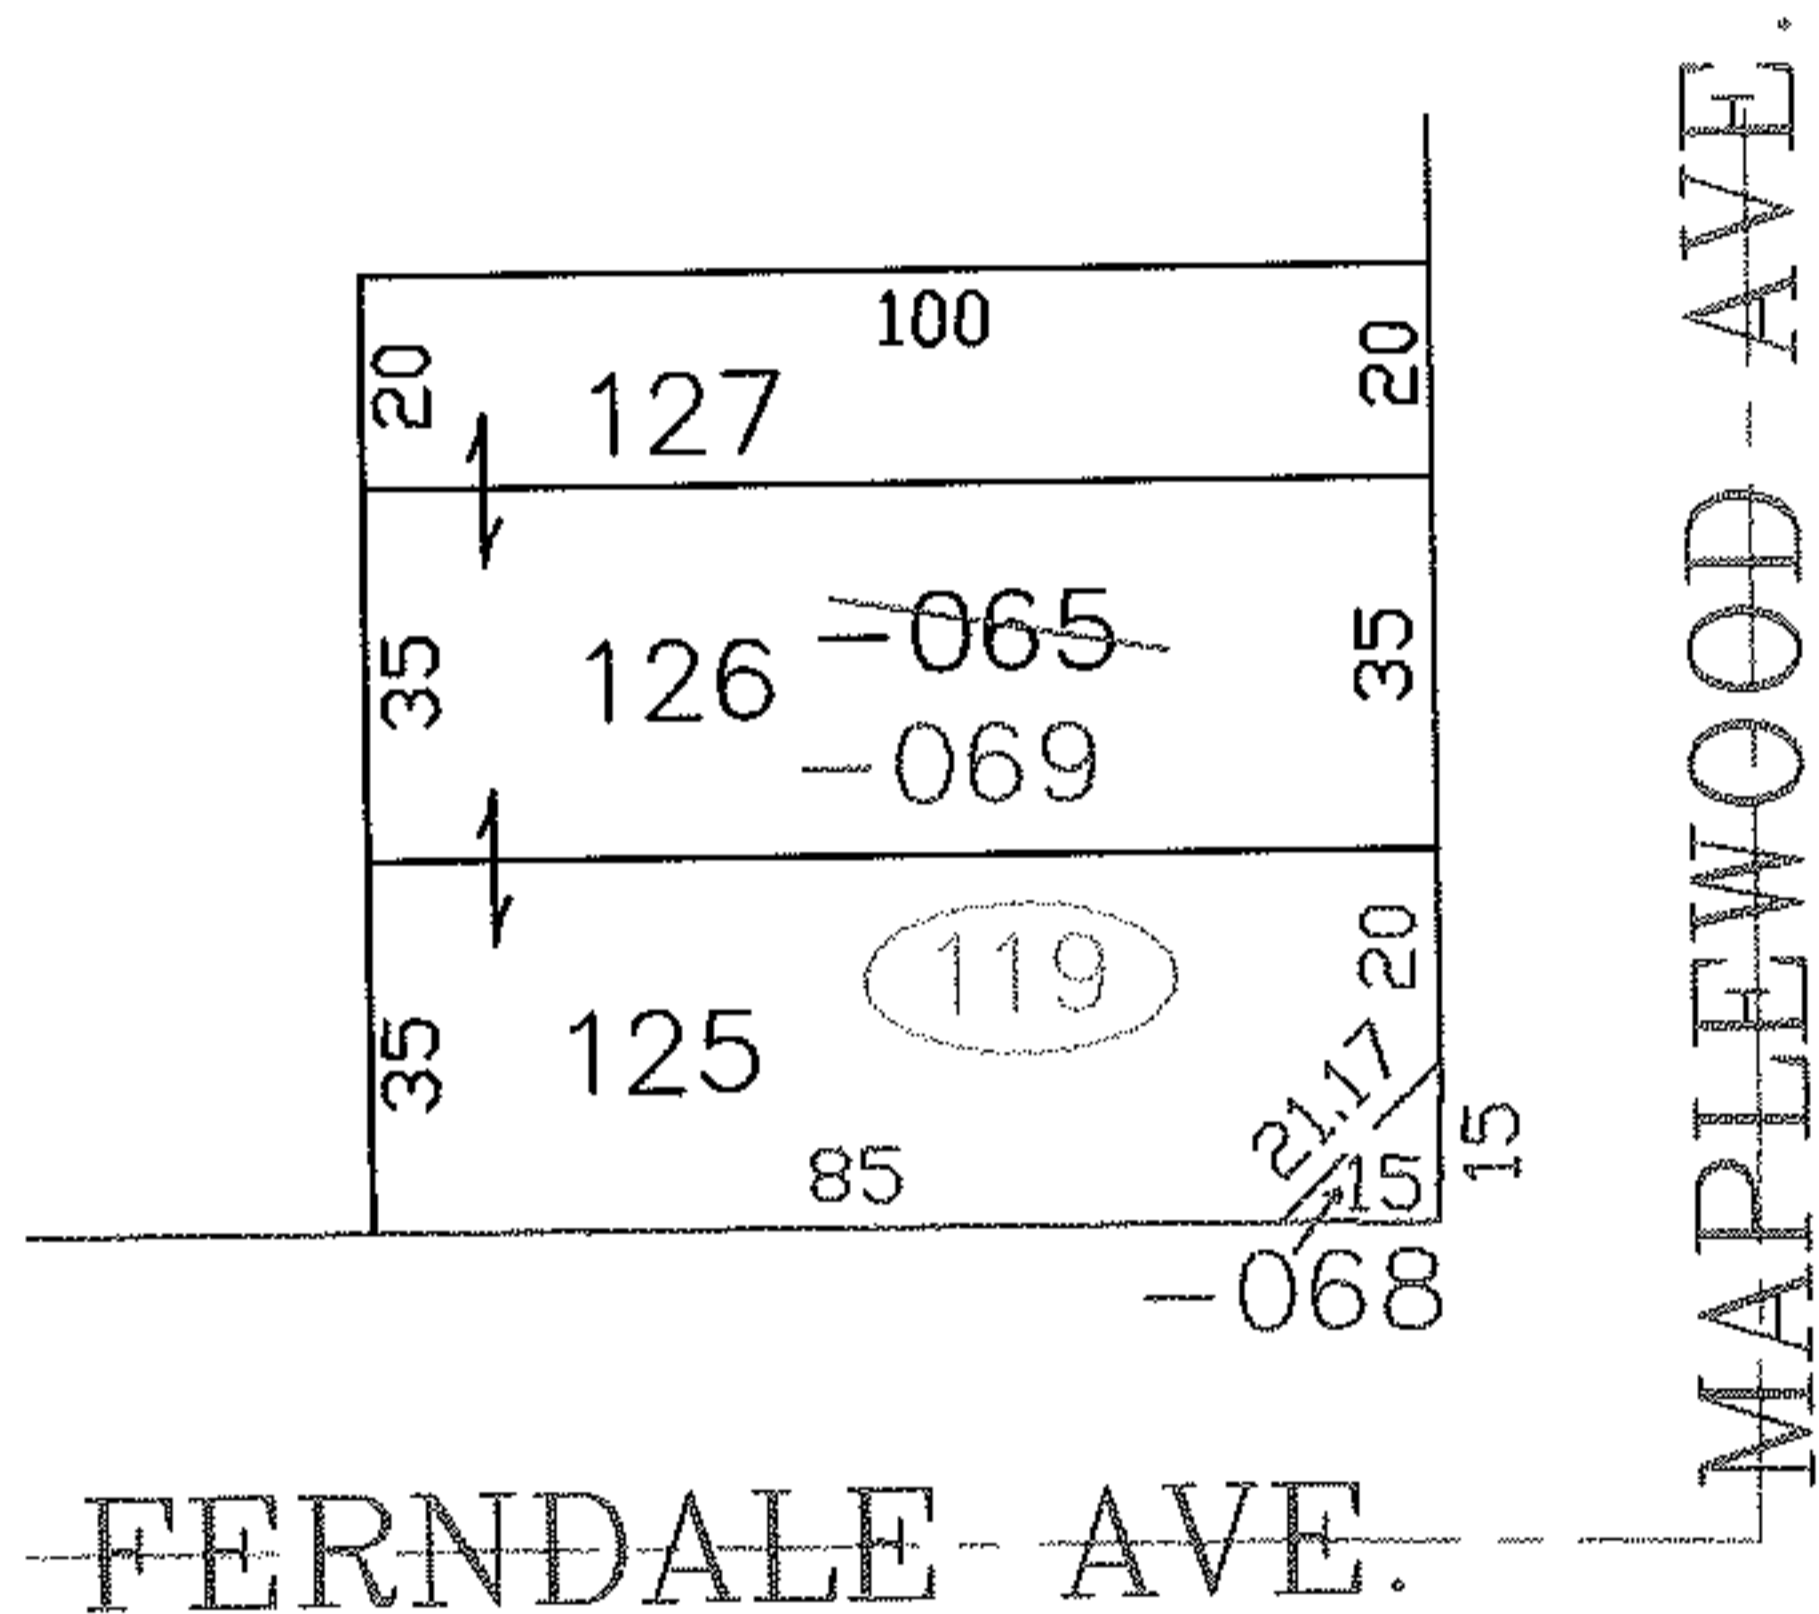


PARENT PARCEL: 03-00-038-119-065

CHILD PARCEL: 03-00-038-119-068, -069

STARTING POINT: SIDELINE OF FERNDALE AVE. & MAPLEWOOD AVE.

NO. 00056

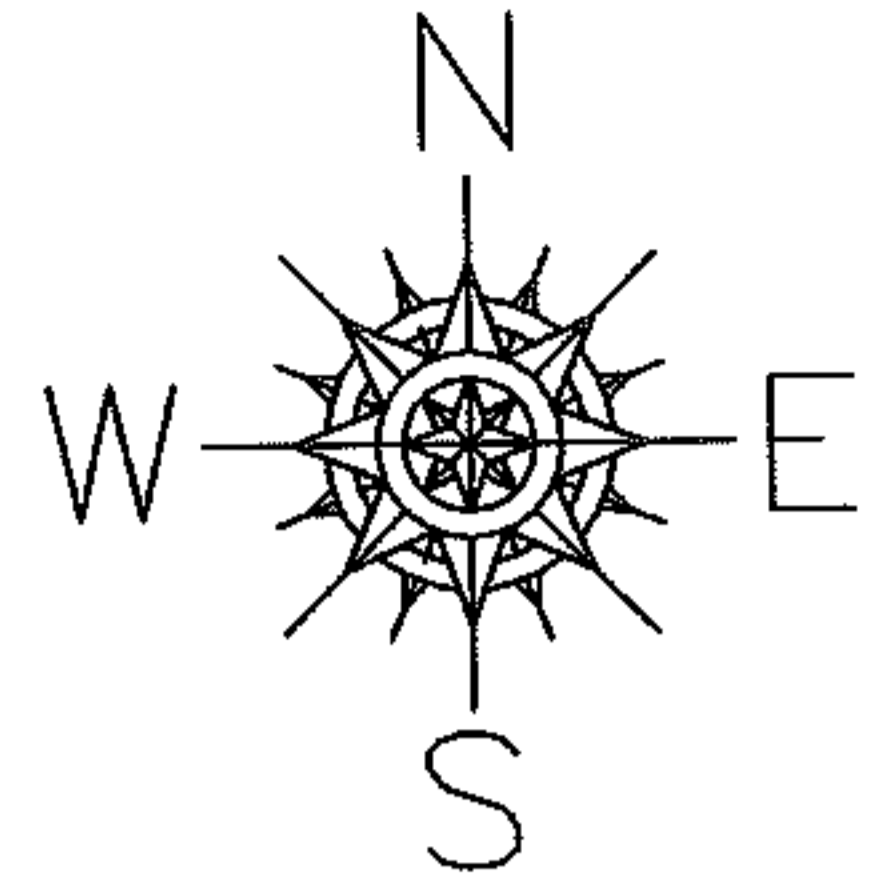

**SPLITS/DEEDS PROCESSED**  
**LORAIN COUNTY TAX MAP DEPARTMENT**  
 226 MIDDLE AVE. ELYRIA, OHIO

SURVEYED BY: ROBERT J. MCAULEY  
 CLOSURE: 0.00 : 10,000  
 MAP PAGE(S): 03-00-038-B  
 APPROVED BY: JAH DATE: 3-20-03  
 SCALE: 1" = 50' PRIOR INSTRUMENT: 19990619061