
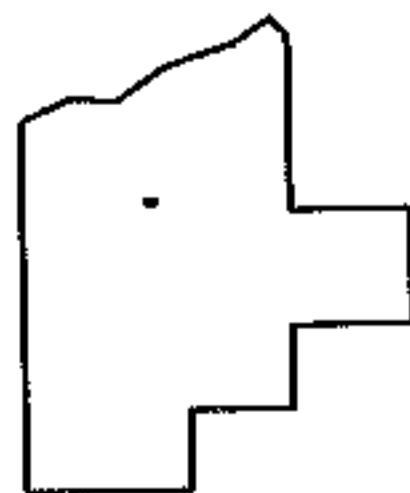
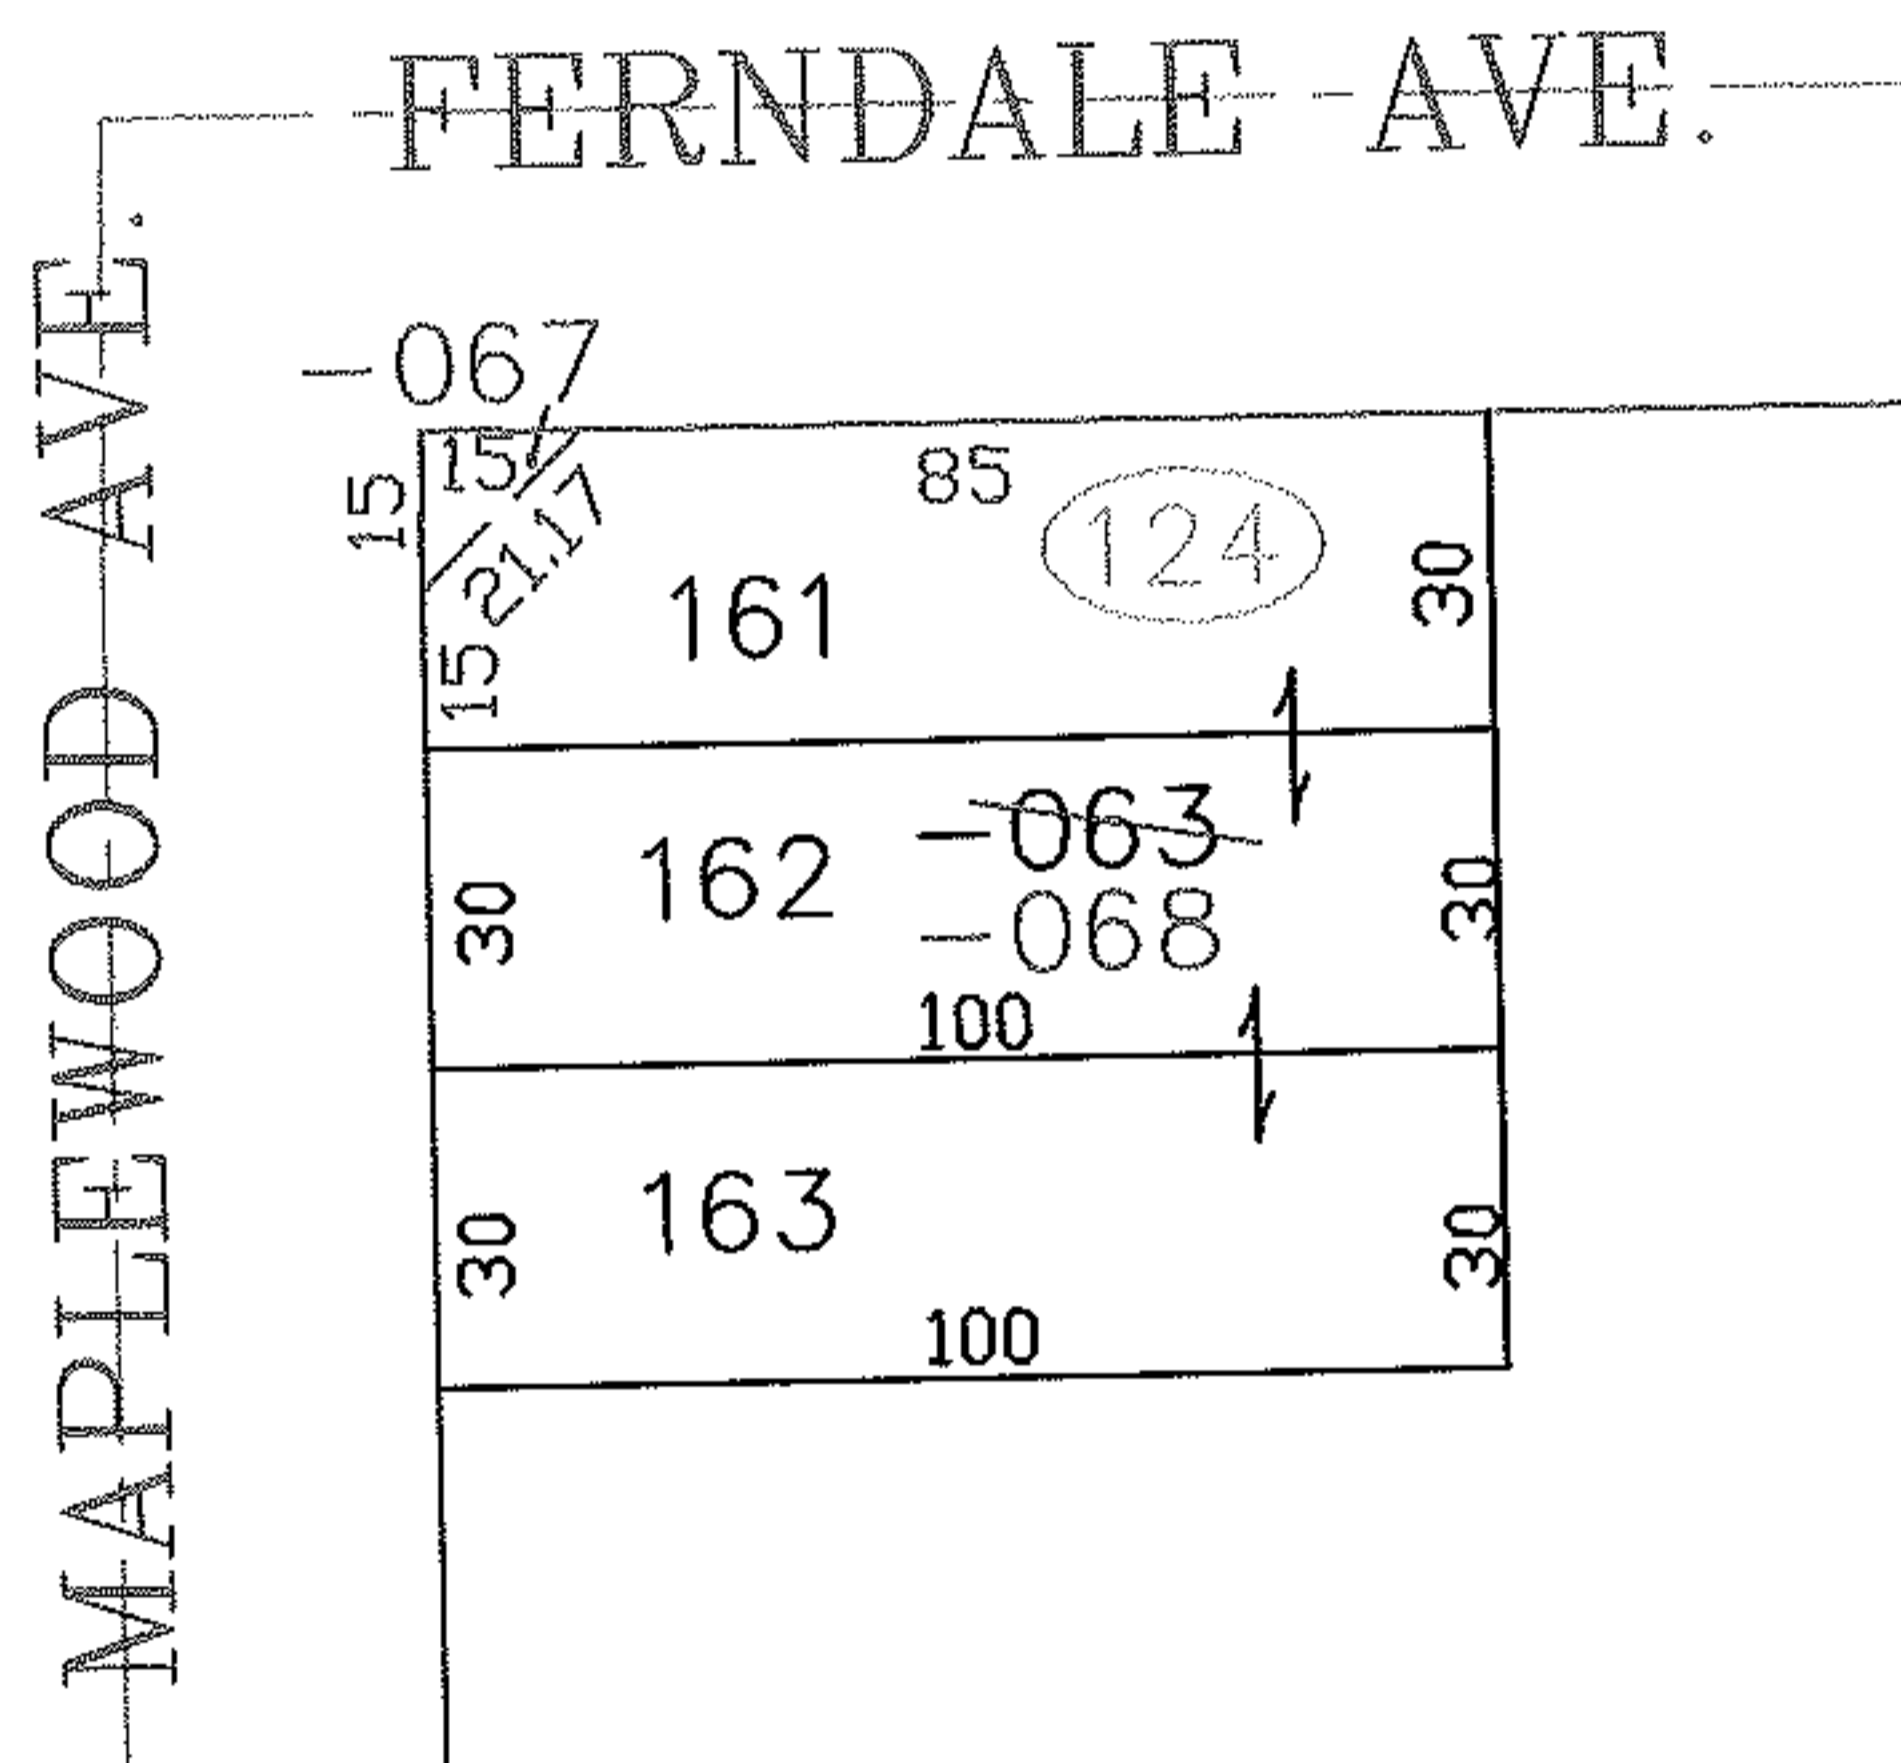


PARENT PARCEL: 03-00-038-124-063

CHILD PARCEL: 03-00-038-124-067, -068

STARTING POINT: SIDELINE OF FERNDALE AVE. & MAPLEWOOD AVE.

NO. 00057

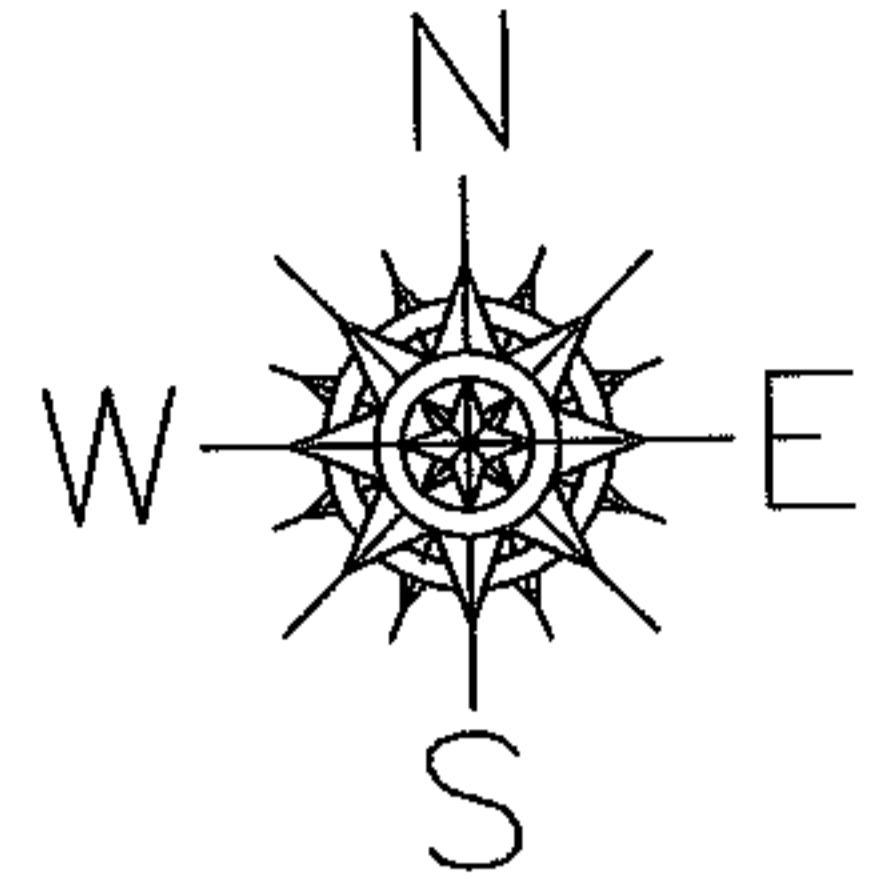

SPLITS/DEEDS PROCESSED
LORAIN COUNTY TAX MAP DEPARTMENT
 226 MIDDLE AVE. ELYRIA, OHIO

SURVEYED BY: ROBERT J. MCAULEY
 CLOSURE: 0.00 : 10,000
 MAP PAGE(S): 03-00-038-B
 APPROVED BY: JAH DATE: 3-20-03
 SCALE: 1" = 50' PRIOR INSTRUMENT: 19980533189