


PARENT PARCEL: 03-00-038-120-062


CHILD PARCEL: 03-00-038-120-081, -082

STARTING POINT: SIDELINE OF MAPLEWOOD AVE. & FERNDALE AVE.


NO. 00058

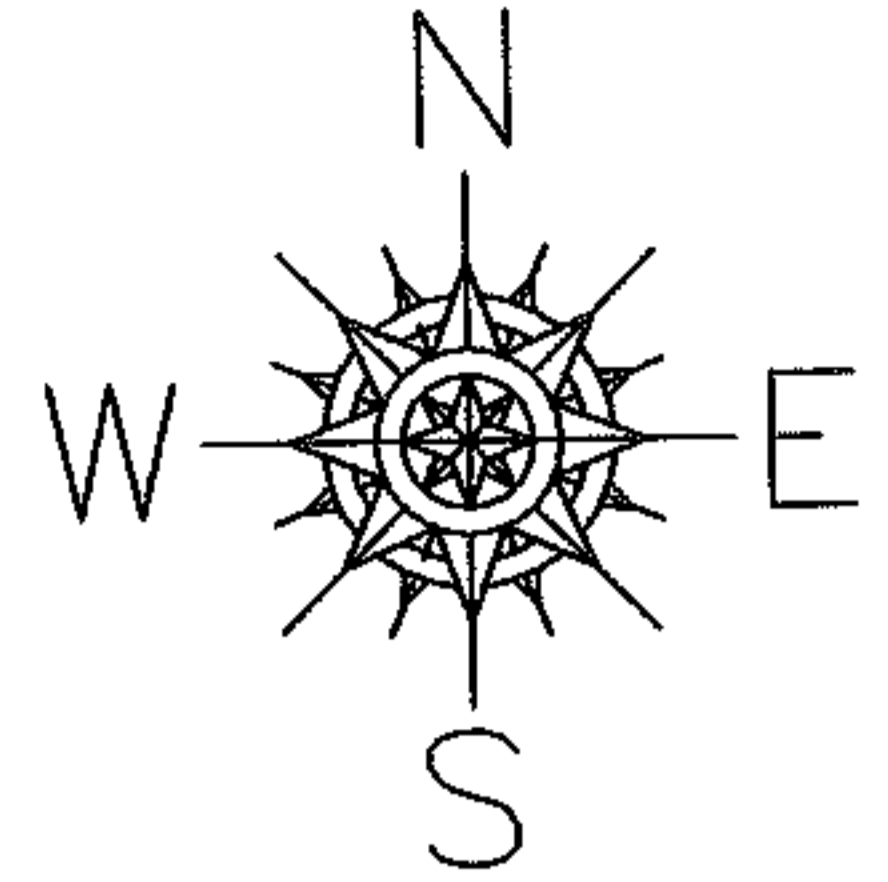

MAPLEWOOD AVE.

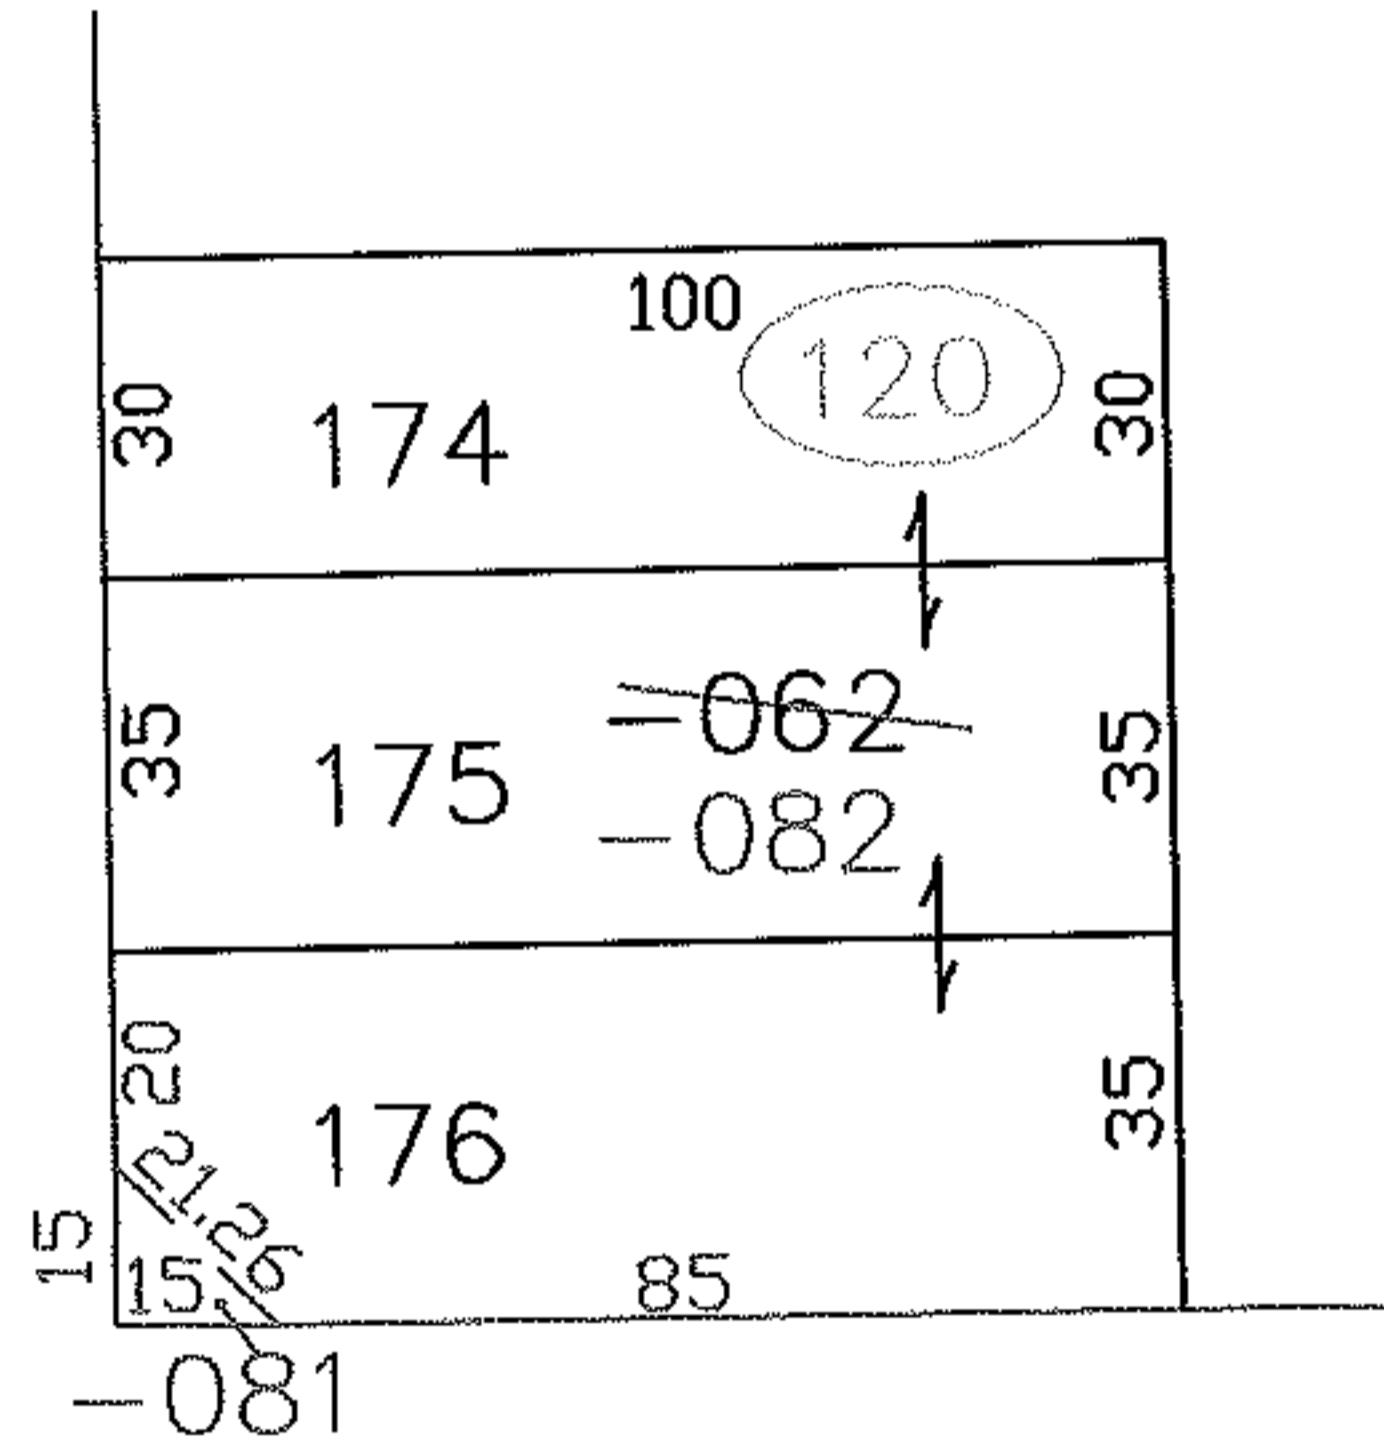

FERNDALE AVE.

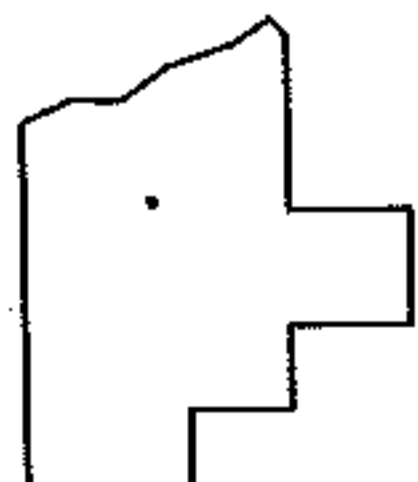

SPLITS/DEEDS PROCESSED
LORAIN COUNTY TAX MAP DEPARTMENT
226 MIDDLE AVE. ELYRIA, OHIO

SURVEYED BY: ROBERT J. MCAULEY
CLOSURE: 0.00 : 10.000
MAP PAGE(S): 03-00-038-B
APPROVED BY: JAH DATE: 3-24-03
SCALE: 1" = 50' PRIOR INSTRUMENT: 20010768817