


PARENT PARCEL: 03-00-038-124-028


CHILD PARCEL: 03-00-038-124-069, -070

STARTING POINT: CENTERLINE OF FERNDALE AVE. & ROBINWOOD AVE.


NO. 00059

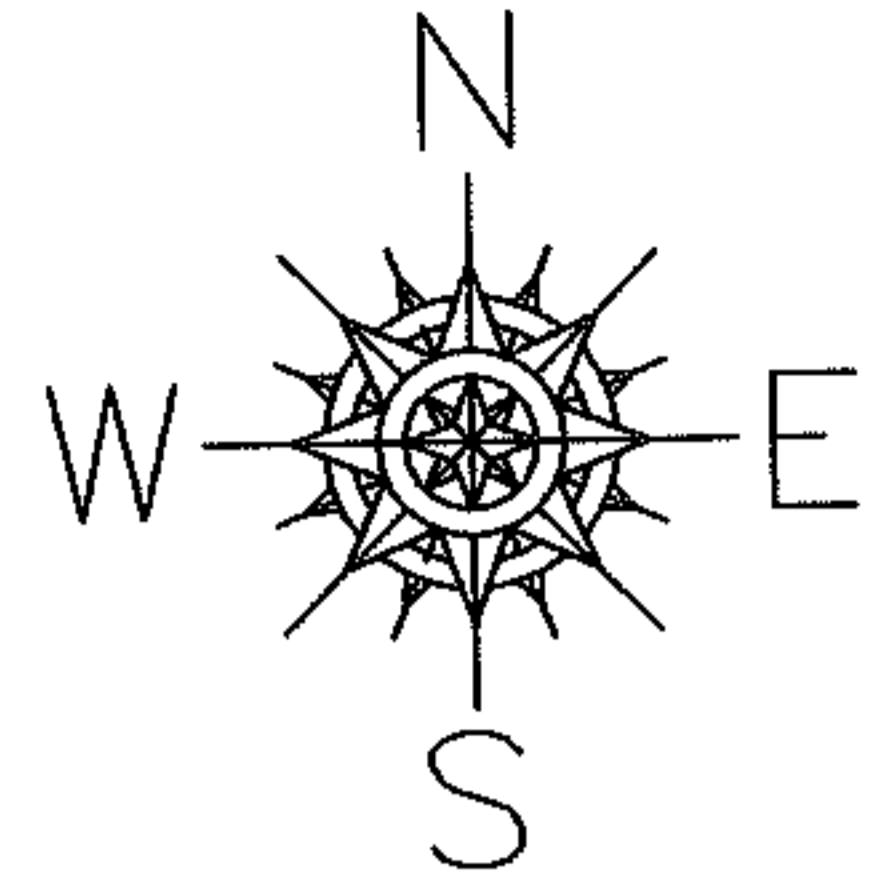

FERNDALE AVE.

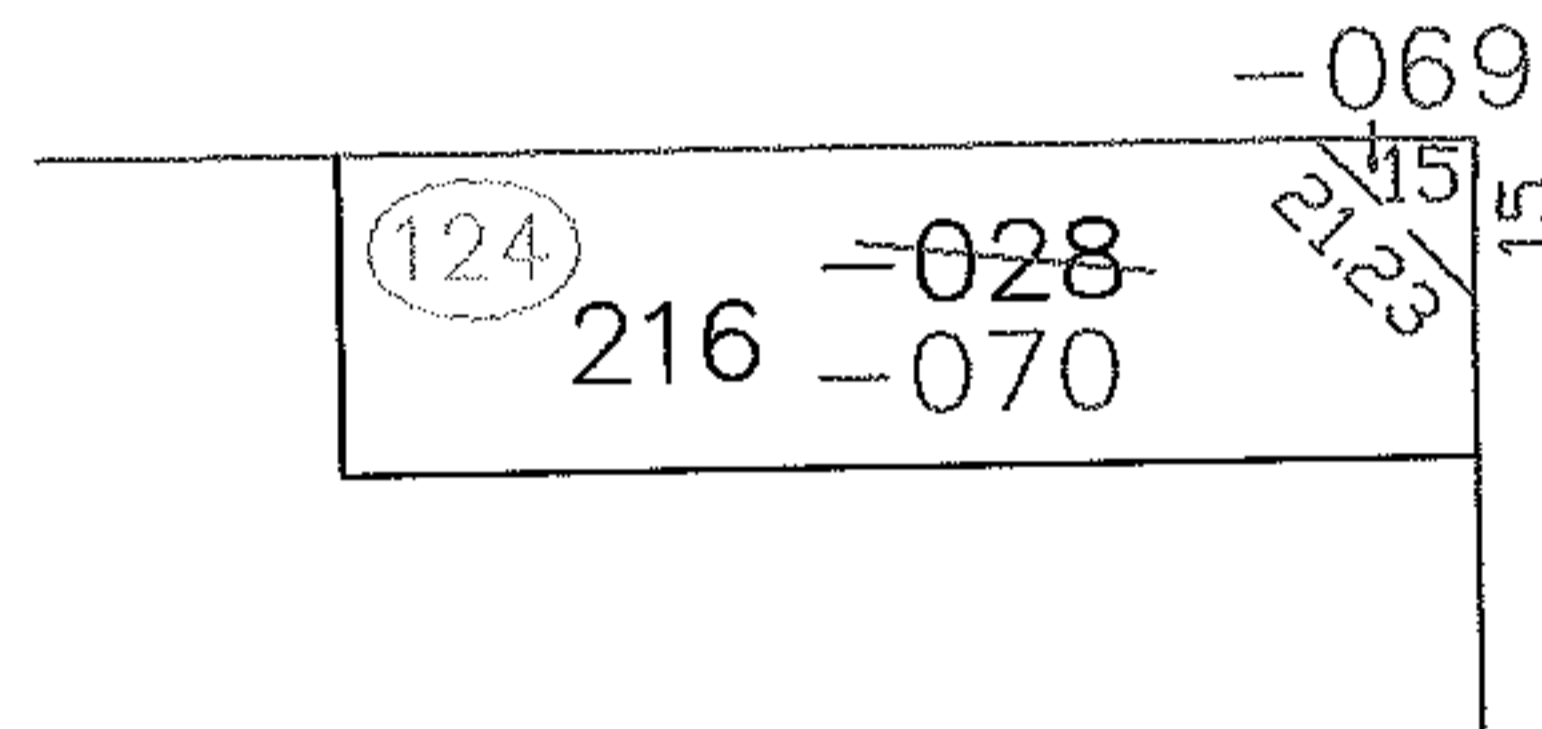

ROBINWOOD AVE.

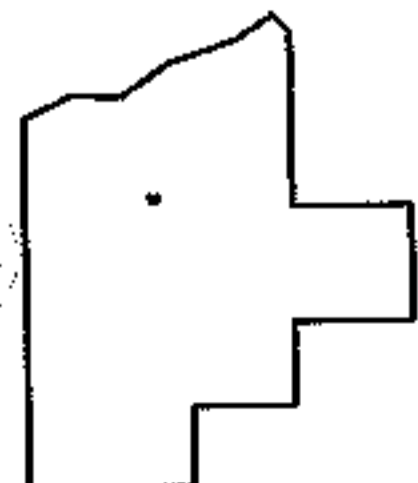

**SPLITS/DEEDS PROCESSED**  
LORAIN COUNTY TAX MAP DEPARTMENT  
226 MIDDLE AVE. ELYRIA, OHIO

SURVEYED BY: ROBERT J. MCAULEY

CLOSURE: 0.00 : 10.000

MAP PAGE(S): 03-00-038-B

APPROVED BY: JAH DATE: 3-24-03

SCALE: 1" = 50' PRIOR INSTRUMENT: DV 1326/551