
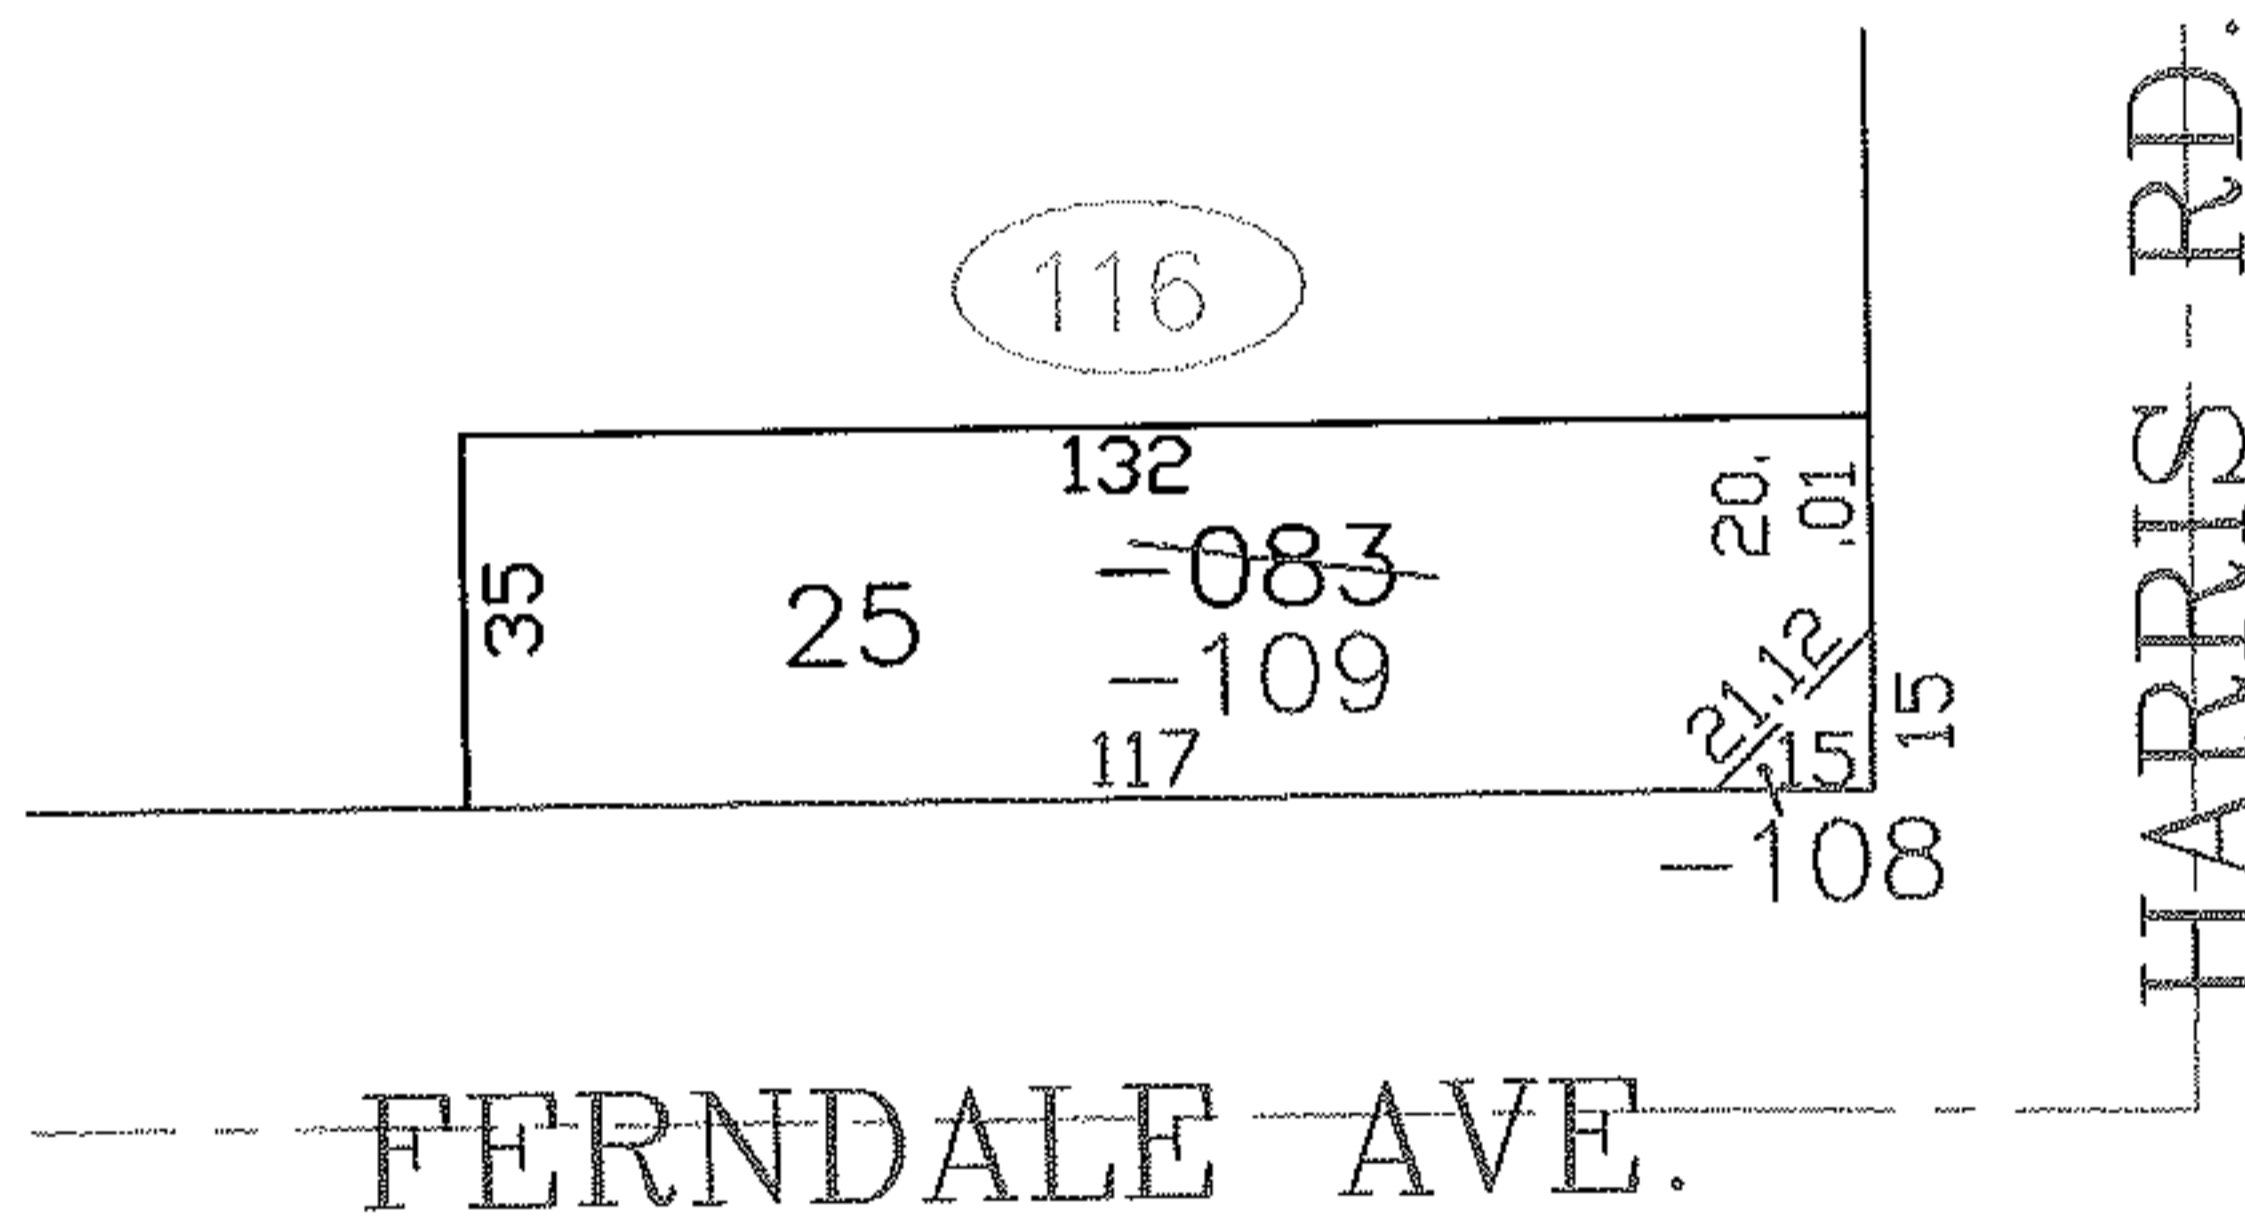


PARENT PARCEL: 03-00-038-116-083

CHILD PARCEL: 03-00-038-116-108, -109


STARTING POINT: SIDELINE OF FERNDALE AVE. & HARRIS RD.

NO. 00063

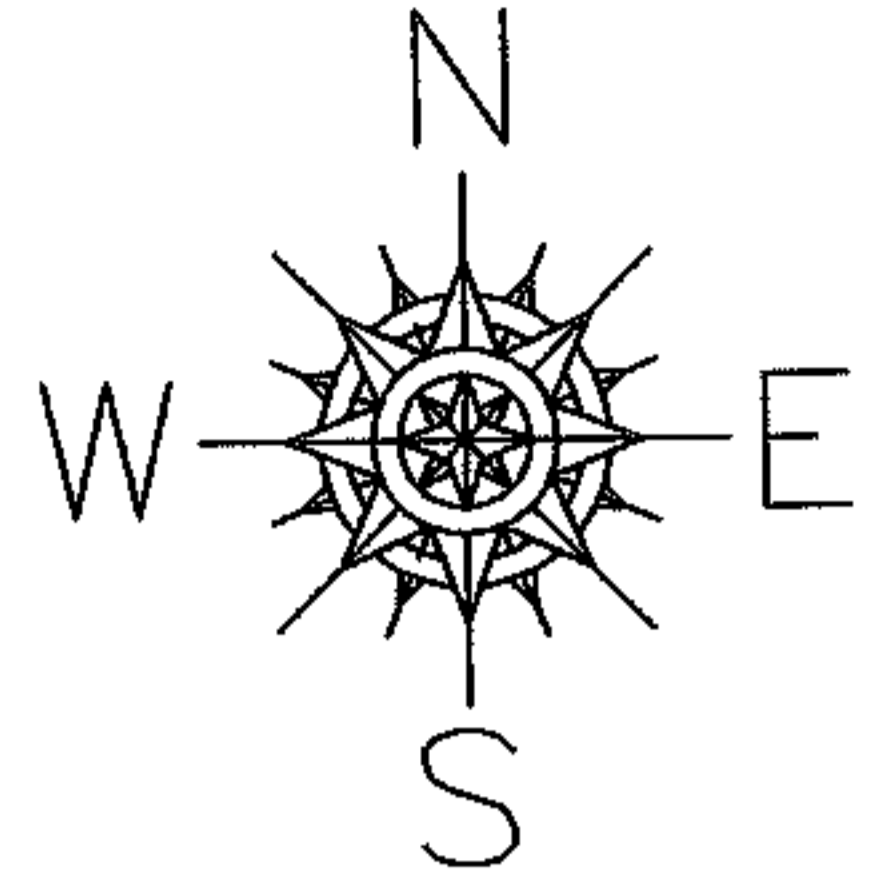

HARRIS - RD.

FERNDALE AVE.

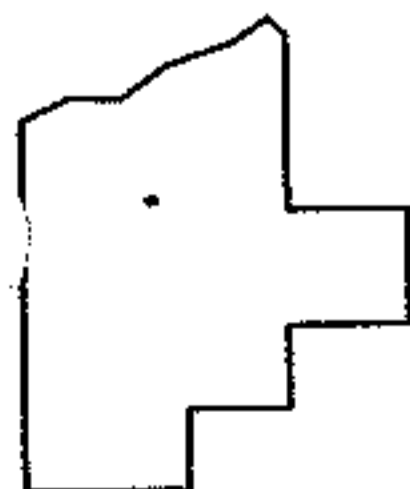

SPLITS/DEEDS PROCESSED
 LORAIN COUNTY TAX MAP DEPARTMENT
 226 MIDDLE AVE. ELYRIA, OHIO

SURVEYED BY: ROBERT J. MCAULEY
 CLOSURE: 0.00 : 10.000
 MAP PAGE(S): 03-00-038-B
 APPROVED BY: JAH DATE: 3-25-03
 SCALE: 1" = 50' PRIOR INSTRUMENT: 20020829024