

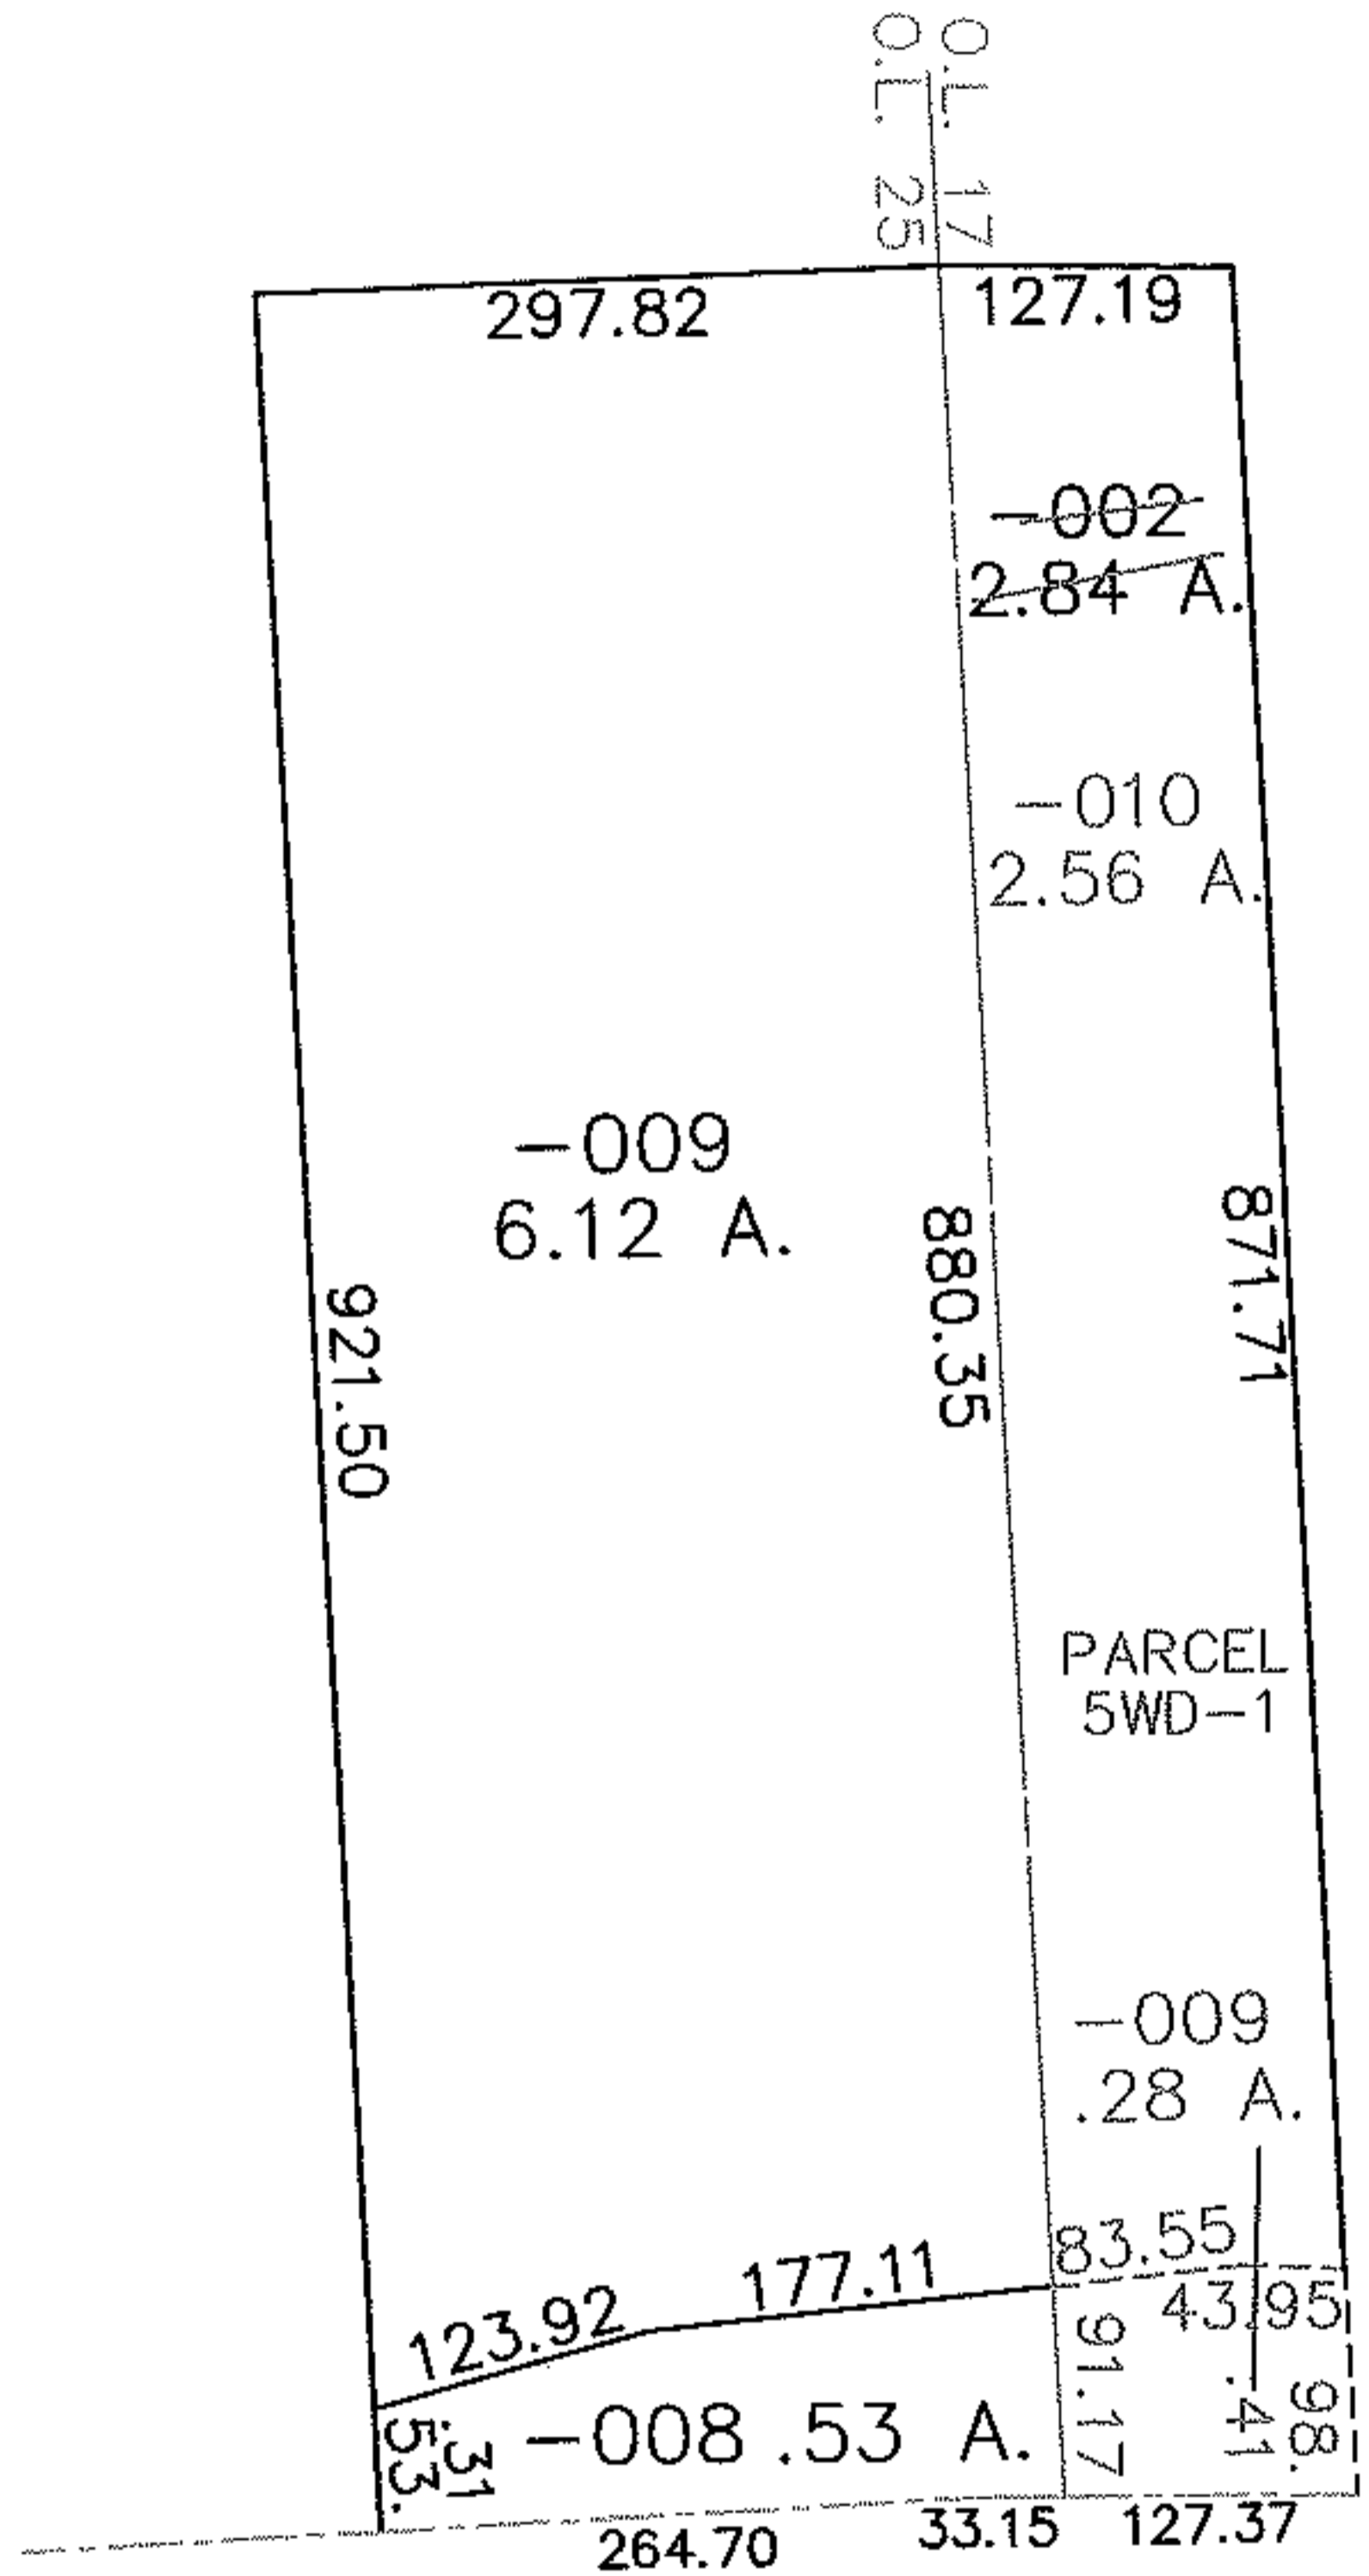


PARENT PARCEL: 21-05-025-000-002  
 CHILD PARCEL: 21-05-025-000-009, -010  
 STARTING POINT: SW CORNER OF LOT 17

NO. 00066

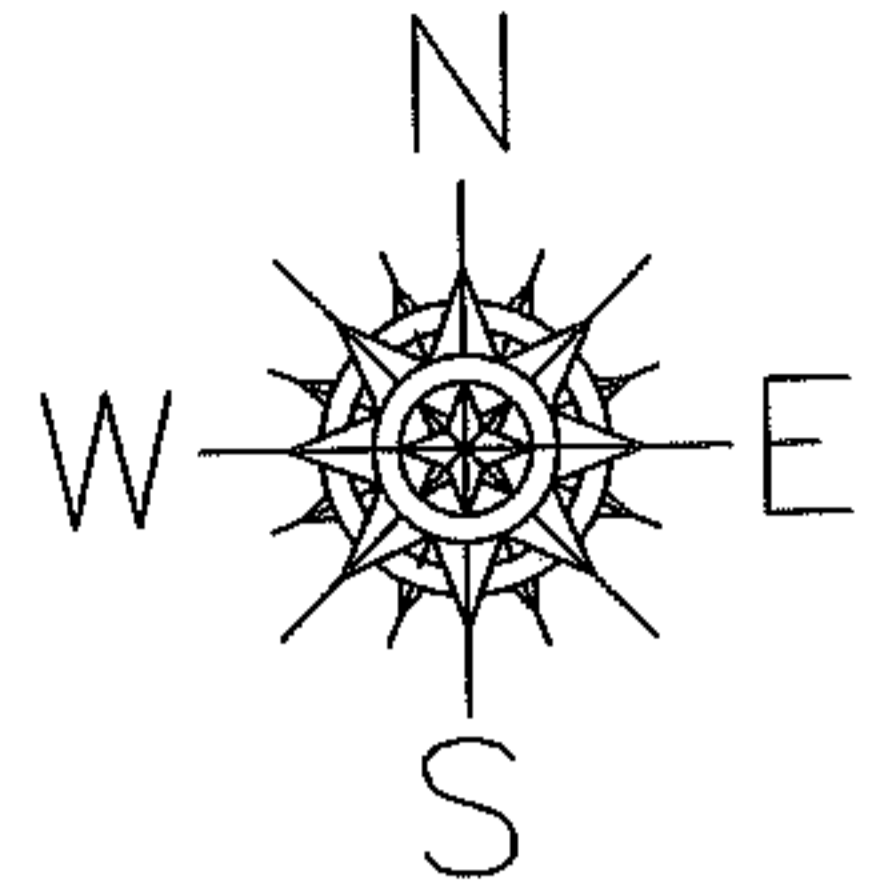

NEW LONDON-LAFAYETTE RD

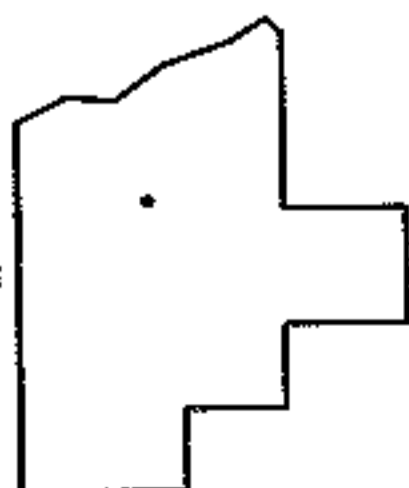

**SPLITS/DEEDS PROCESSED**  
 LORAIN COUNTY TAX MAP DEPARTMENT  
 226 MIDDLE AVE. ELYRIA, OHIO

SURVEYED BY: N/A  
 CLOSURE: N/A  
 MAP PAGE(S): 21-A  
 APPROVED BY: DRH DATE: 3/10/2003  
 SCALE: 1" = 200' PRIOR INSTRUMENT: