
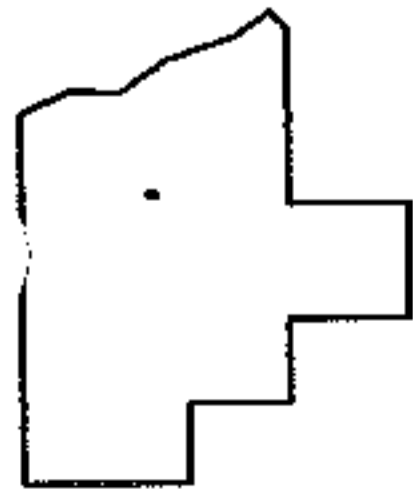
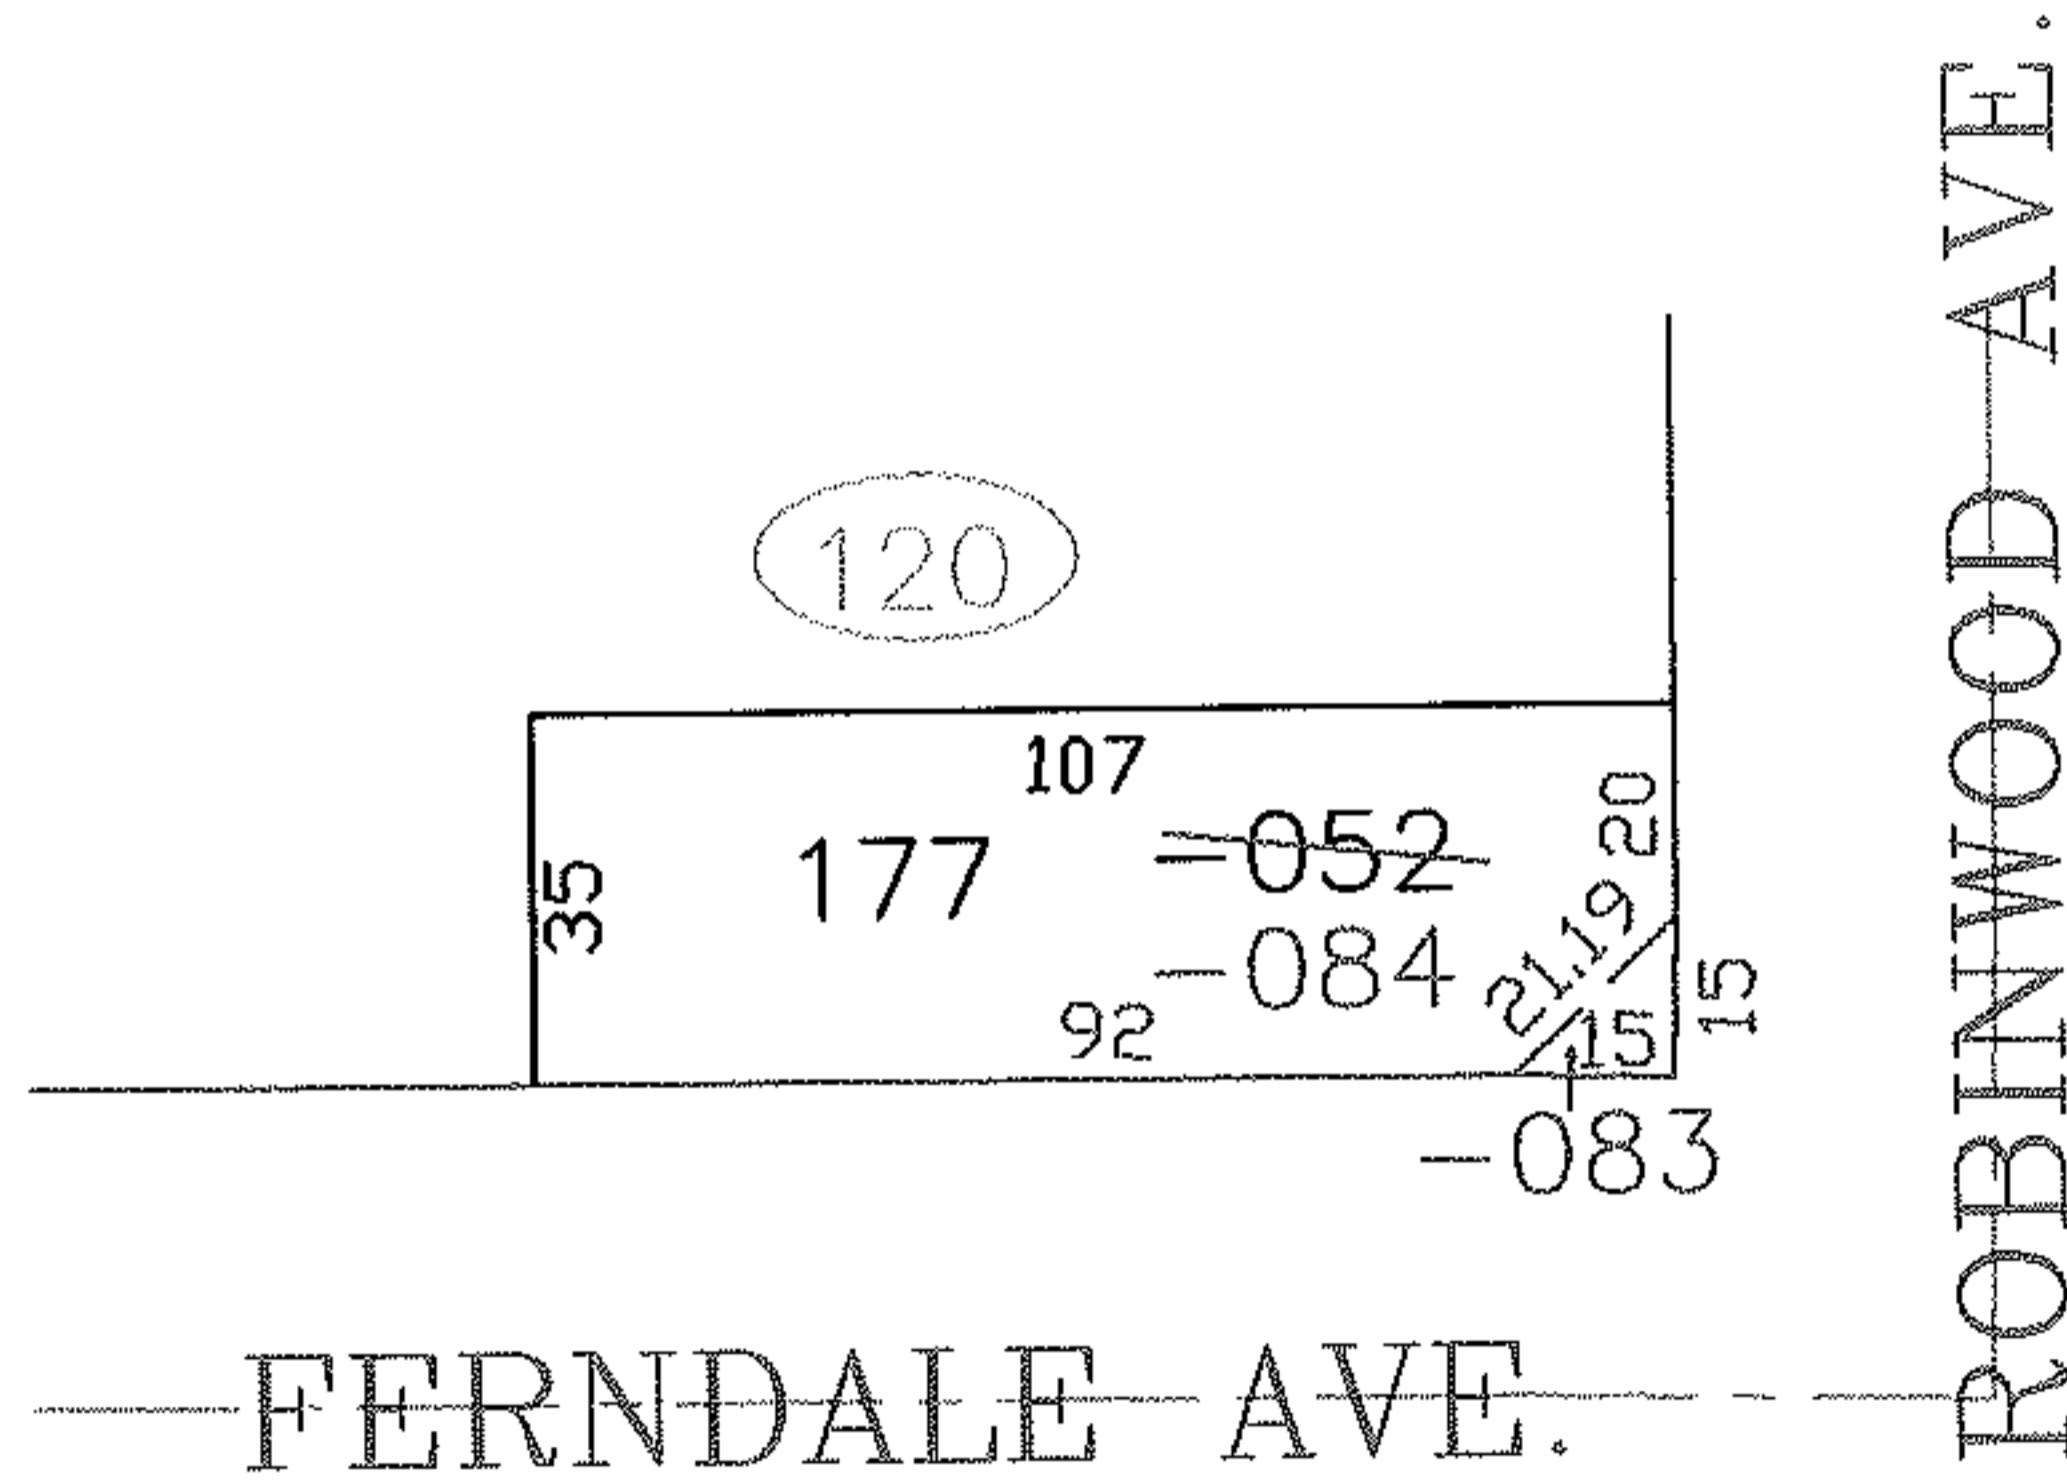


PARENT PARCEL: 03-00-038-120-052

CHILD PARCEL: 03-00-038-120-083, -084

STARTING POINT: SIDELINE OF FERNDALE AVE. & ROBINWOOD AVE.

NO. 00070

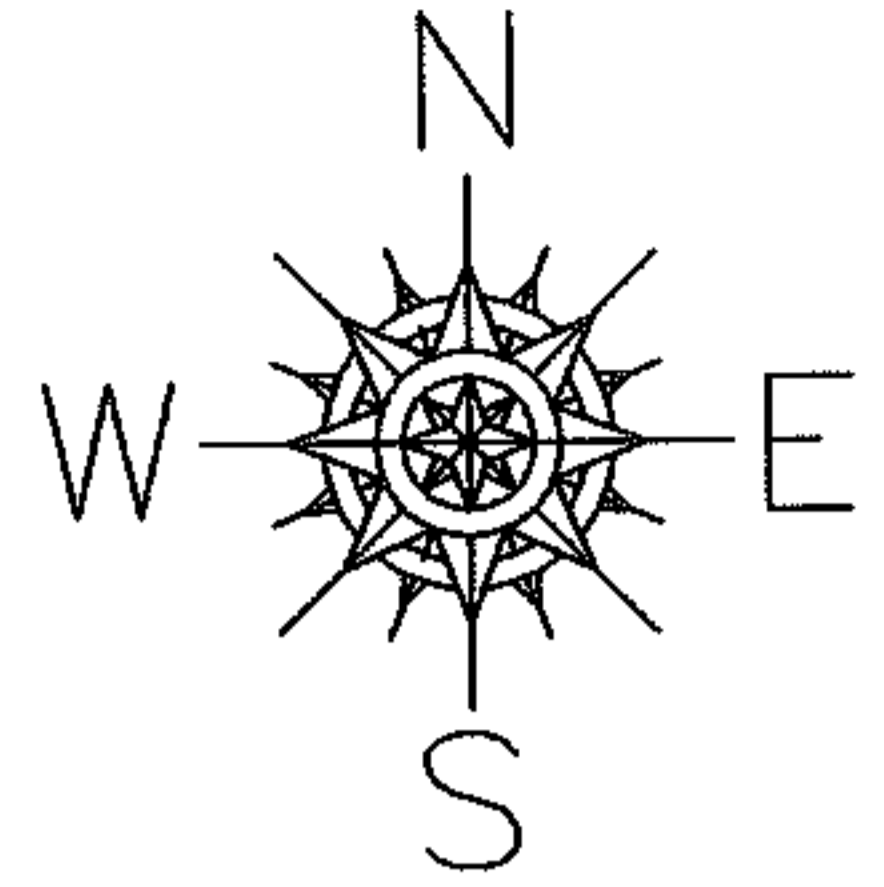

SPLITS/DEEDS PROCESSED

LORAIN COUNTY TAX MAP DEPARTMENT
226 MIDDLE AVE. ELYRIA, OHIO

SURVEYED BY: ROBERT J. MCAULEY

CLOSURE: 0.00 : 10.000

MAP PAGE(S): 03-00-038-B

APPROVED BY: JAH DATE: 3-25-03

SCALE: 1" = 50' PRIOR INSTRUMENT: 20020854844