



PARENT PARCEL: 21-04-000-000-035

CHILD PARCEL: 21-04-000-000-048, -049

STARTING POINT: CL OF SR 102

NO. 00071

S.R. 102

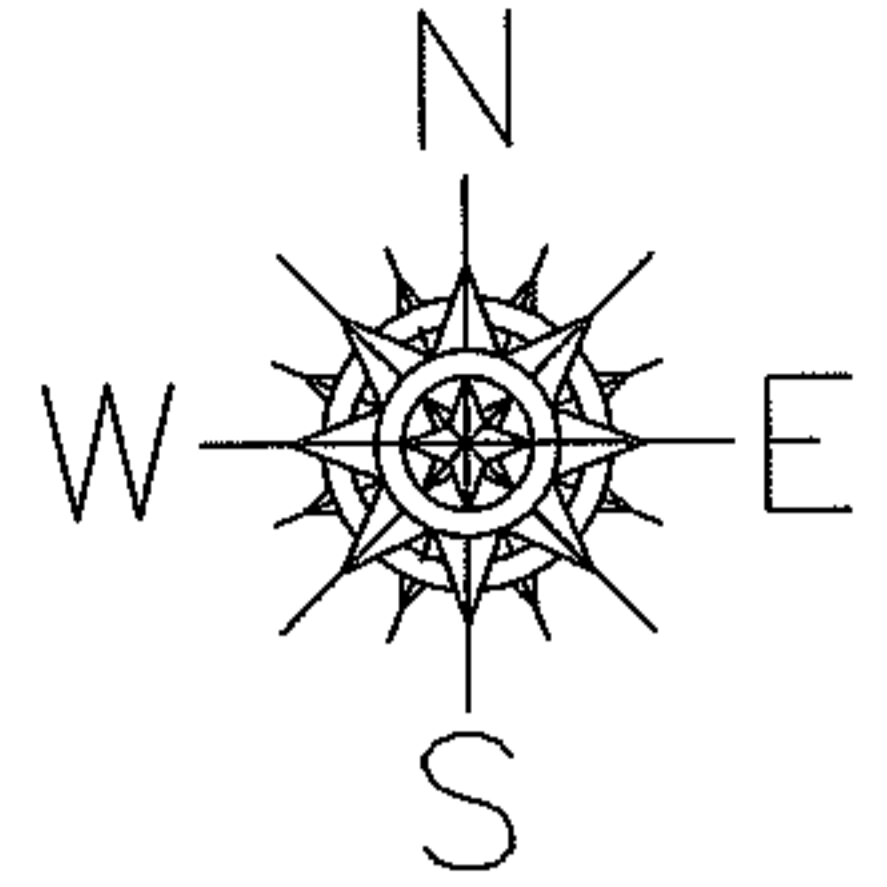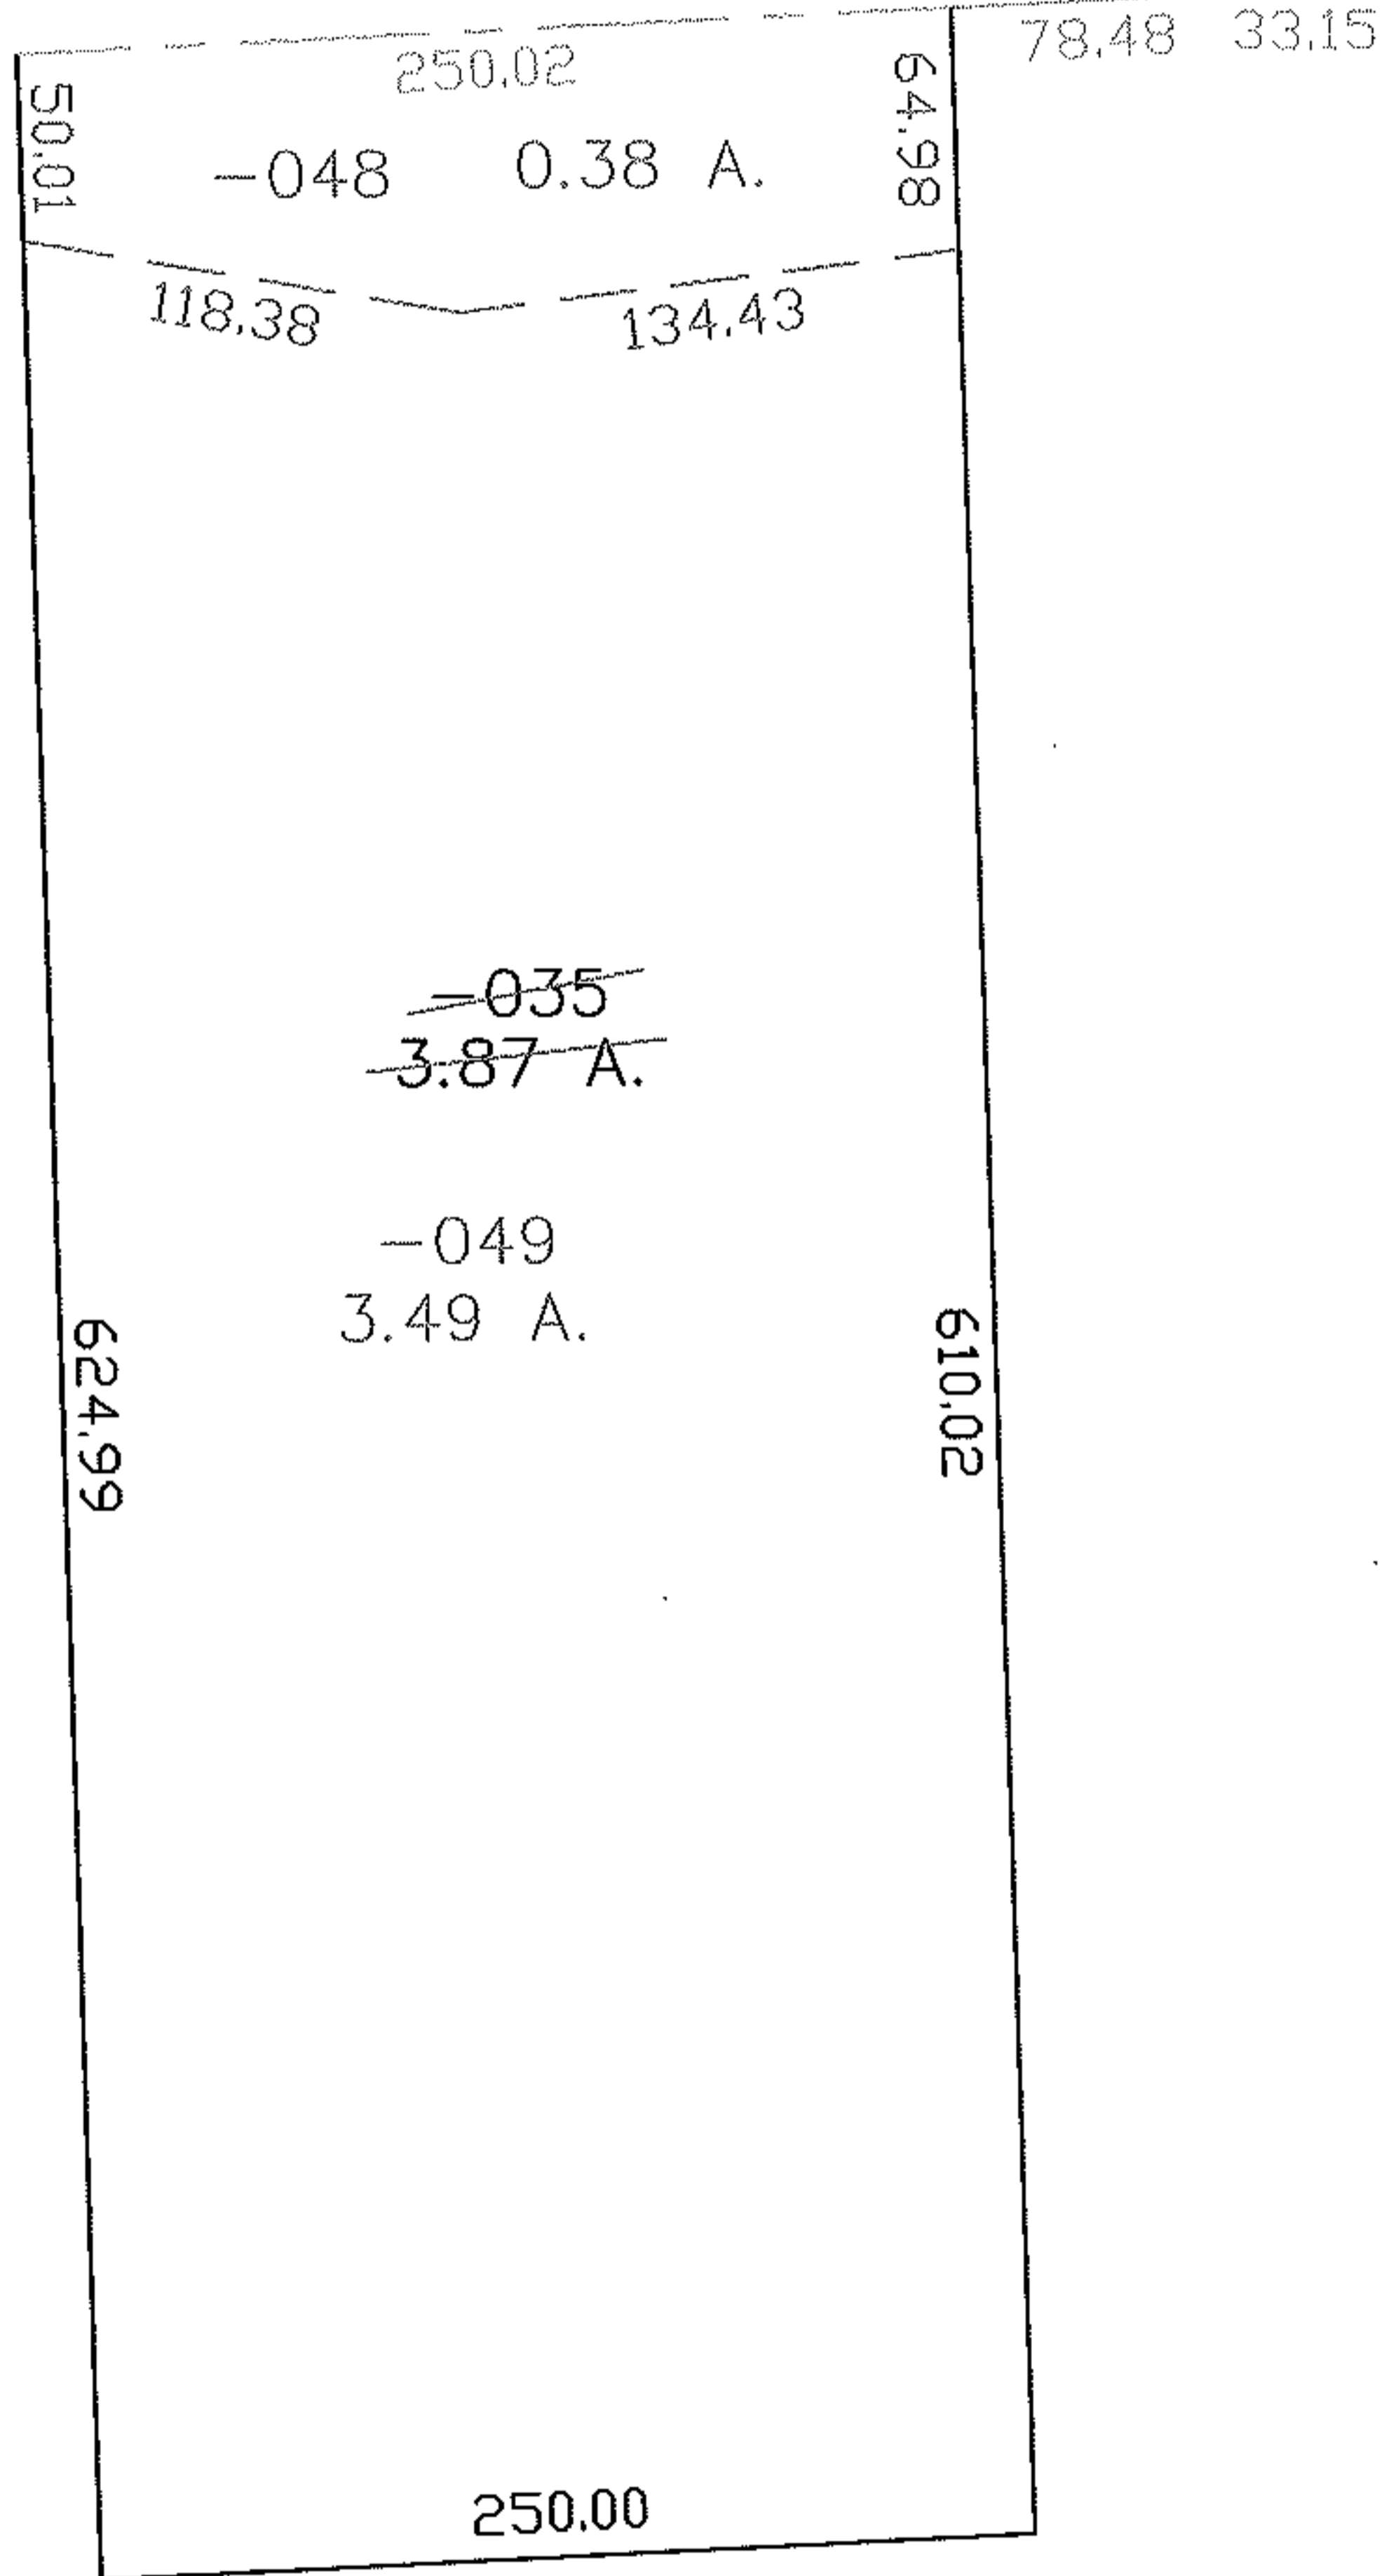

SPLITS/DEEDS PROCESSED

LORAIN COUNTY TAX MAP DEPARTMENT
226 MIDDLE AVE. ELYRIA, OHIO

SURVEYED BY: 0:00

CLOSURE: XXXXXX

MAP PAGE(S): 21-E

APPROVED BY: DRH DATE: 4/30/2003

SCALE: 1" = 100 PRIOR INSTRUMENT: