
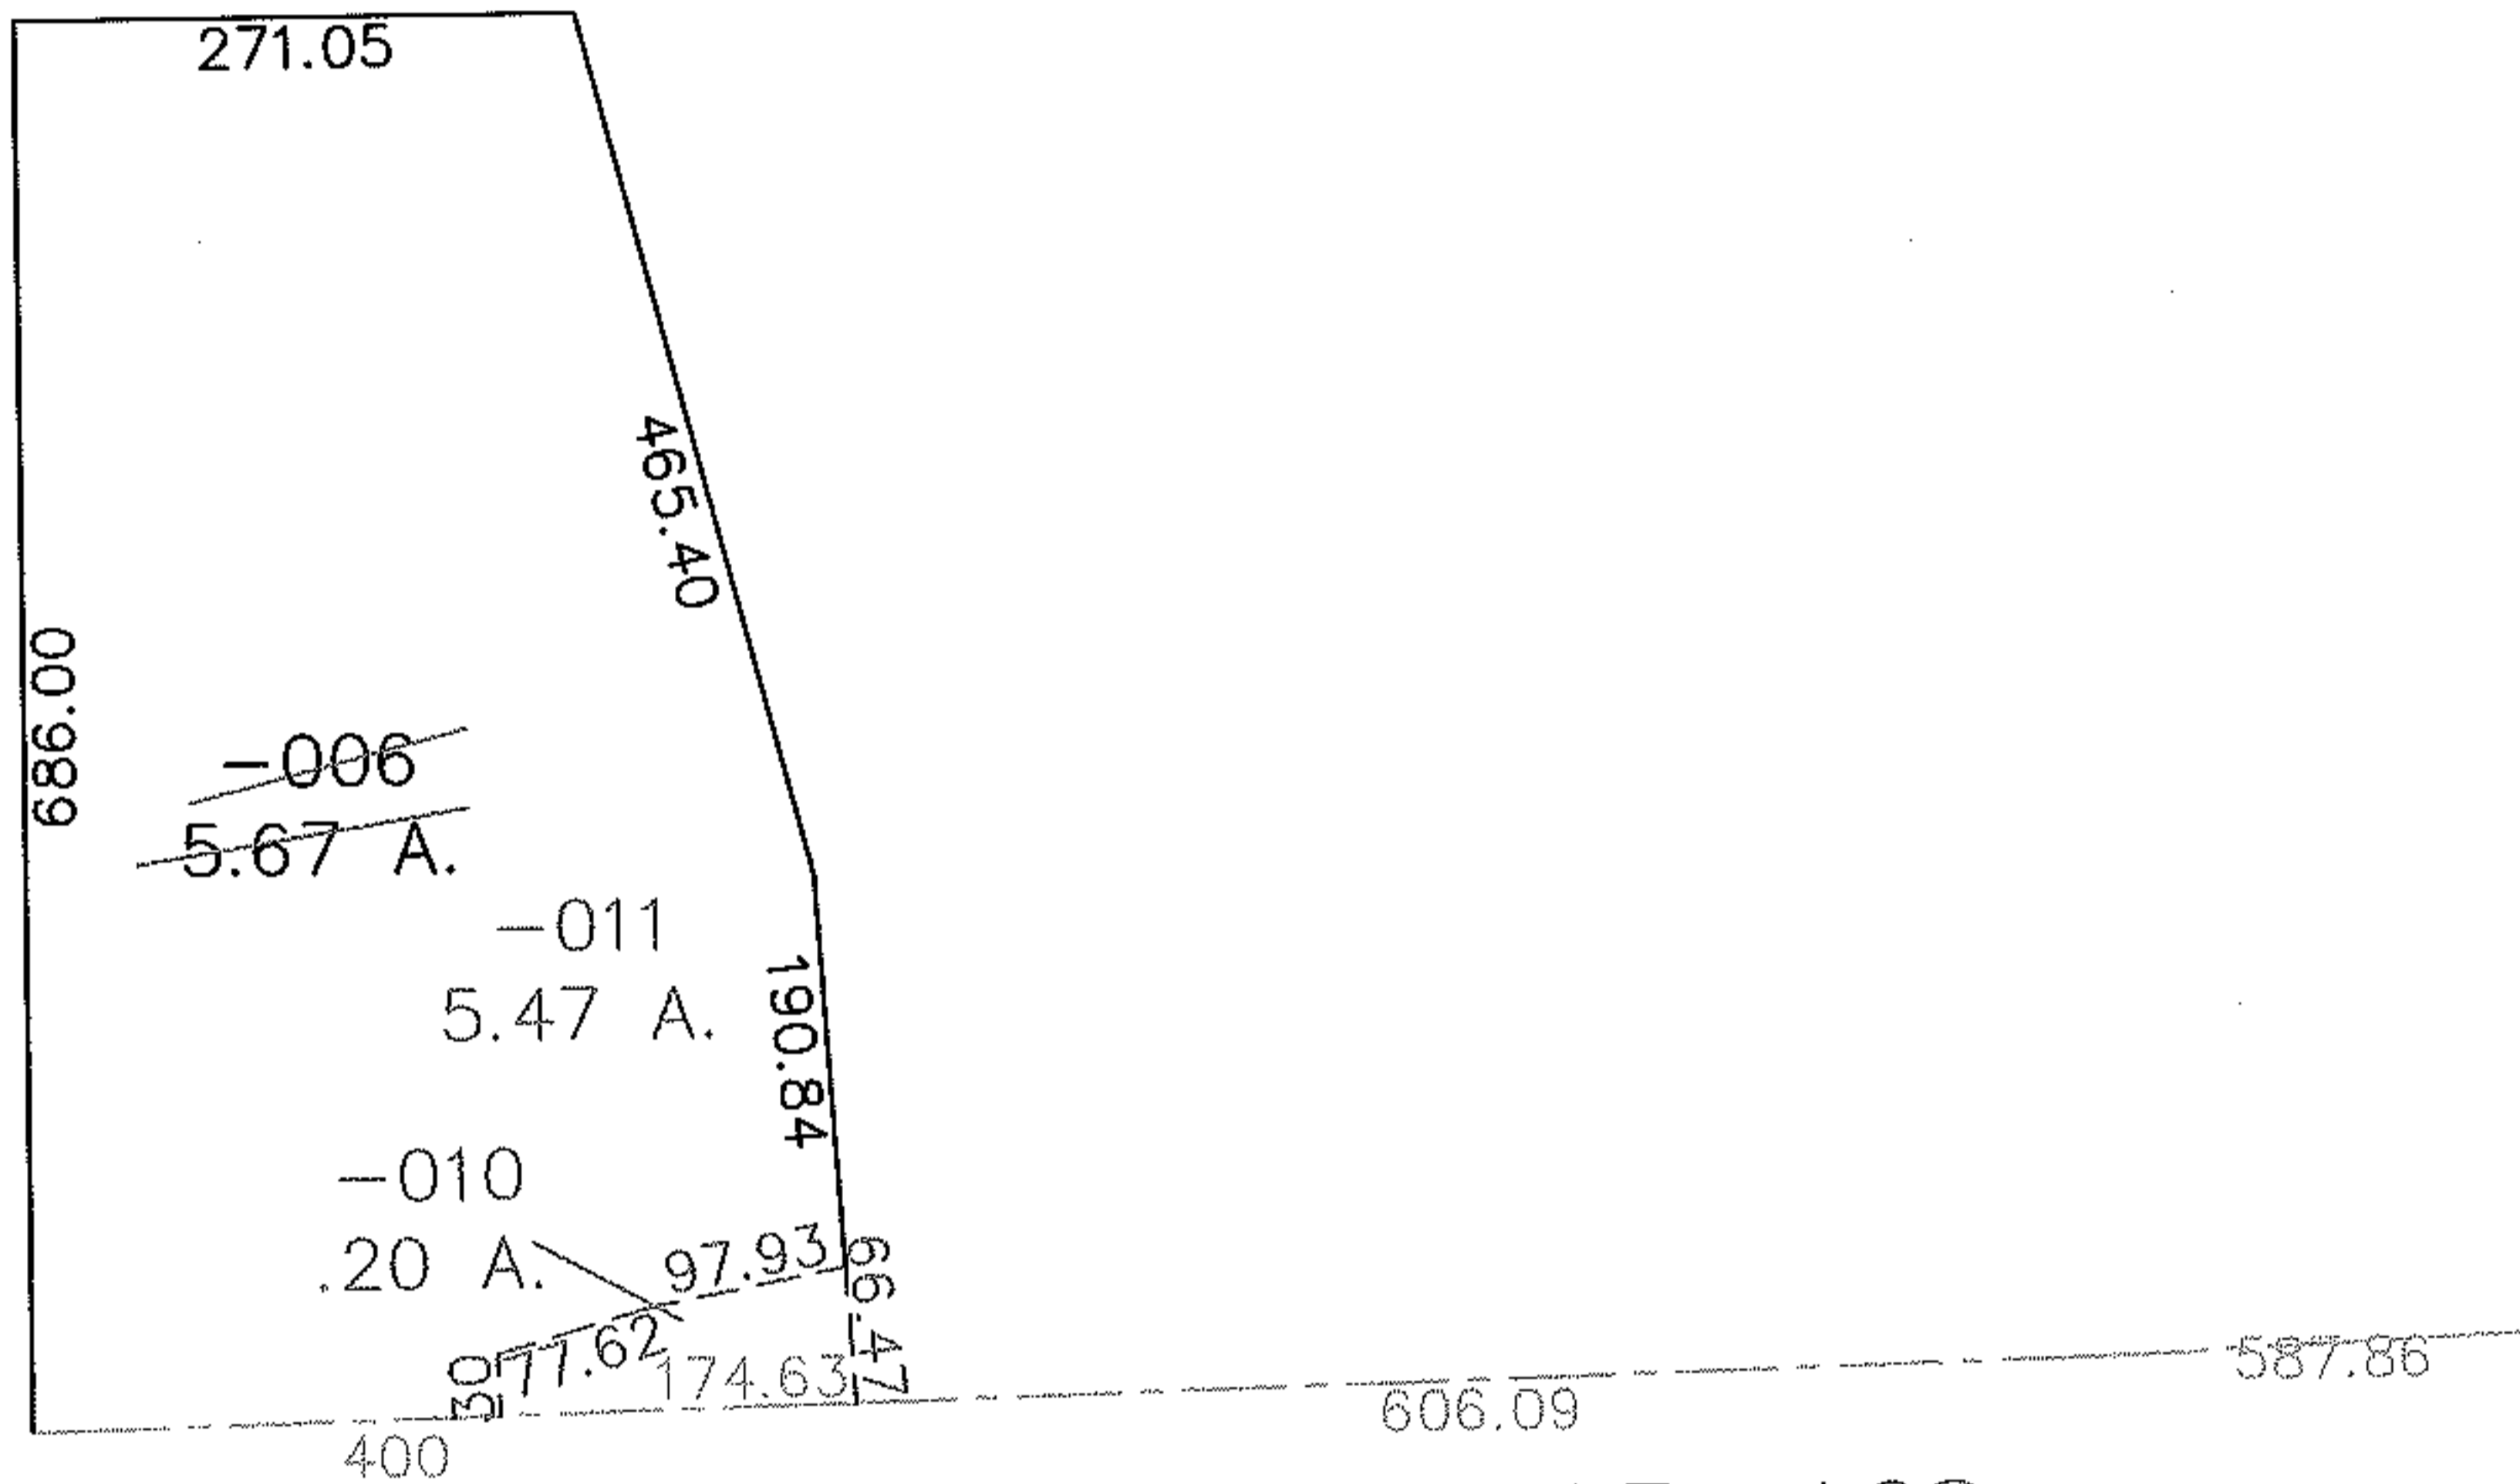


PARENT PARCEL: 21-05-025-000-006

CHILD PARCEL: 21-05-025-000-010, -011

STARTING POINT: CL OF S.R. 162

NO. 00072

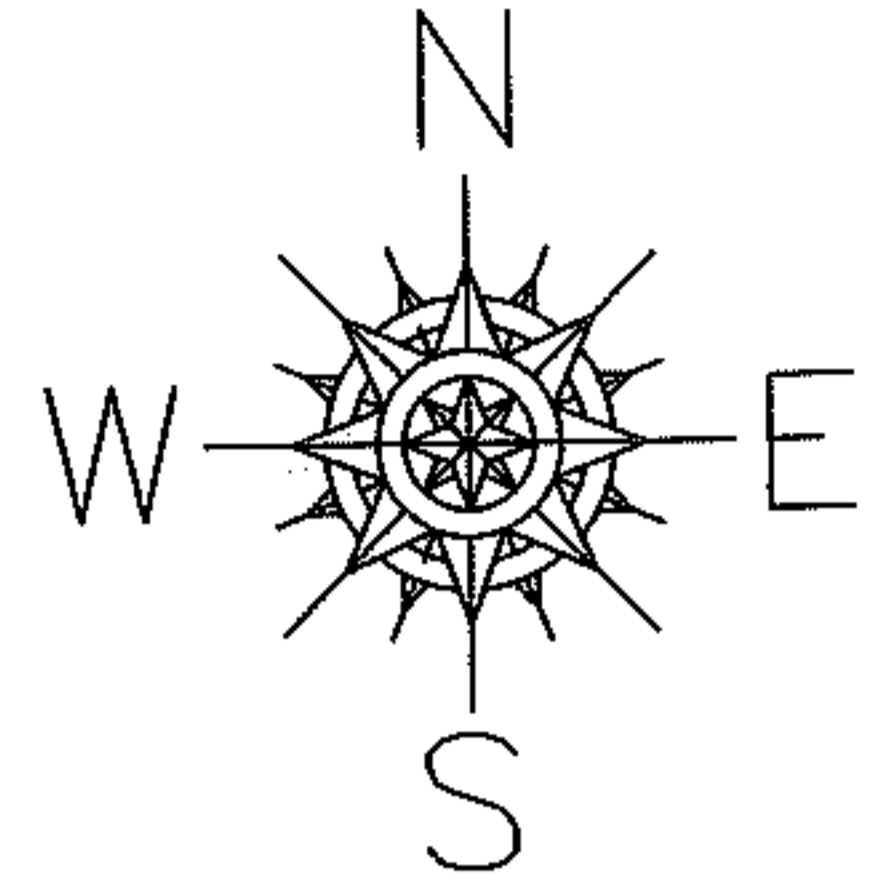

S.R. 162

SURVEYED BY: STATE OF OHIO  
 CLOSURE: 0:00  
 MAP PAGE(S): 21-A  
 APPROVED BY: DRH DATE: 5/1/03  
 SCALE: 1" = 200 PRIOR INSTRUMENT:

**SPLITS/DEEDS PROCESSED**  
 LORAIN COUNTY TAX MAP DEPARTMENT  
 226 MIDDLE AVE. ELYRIA, OHIO