
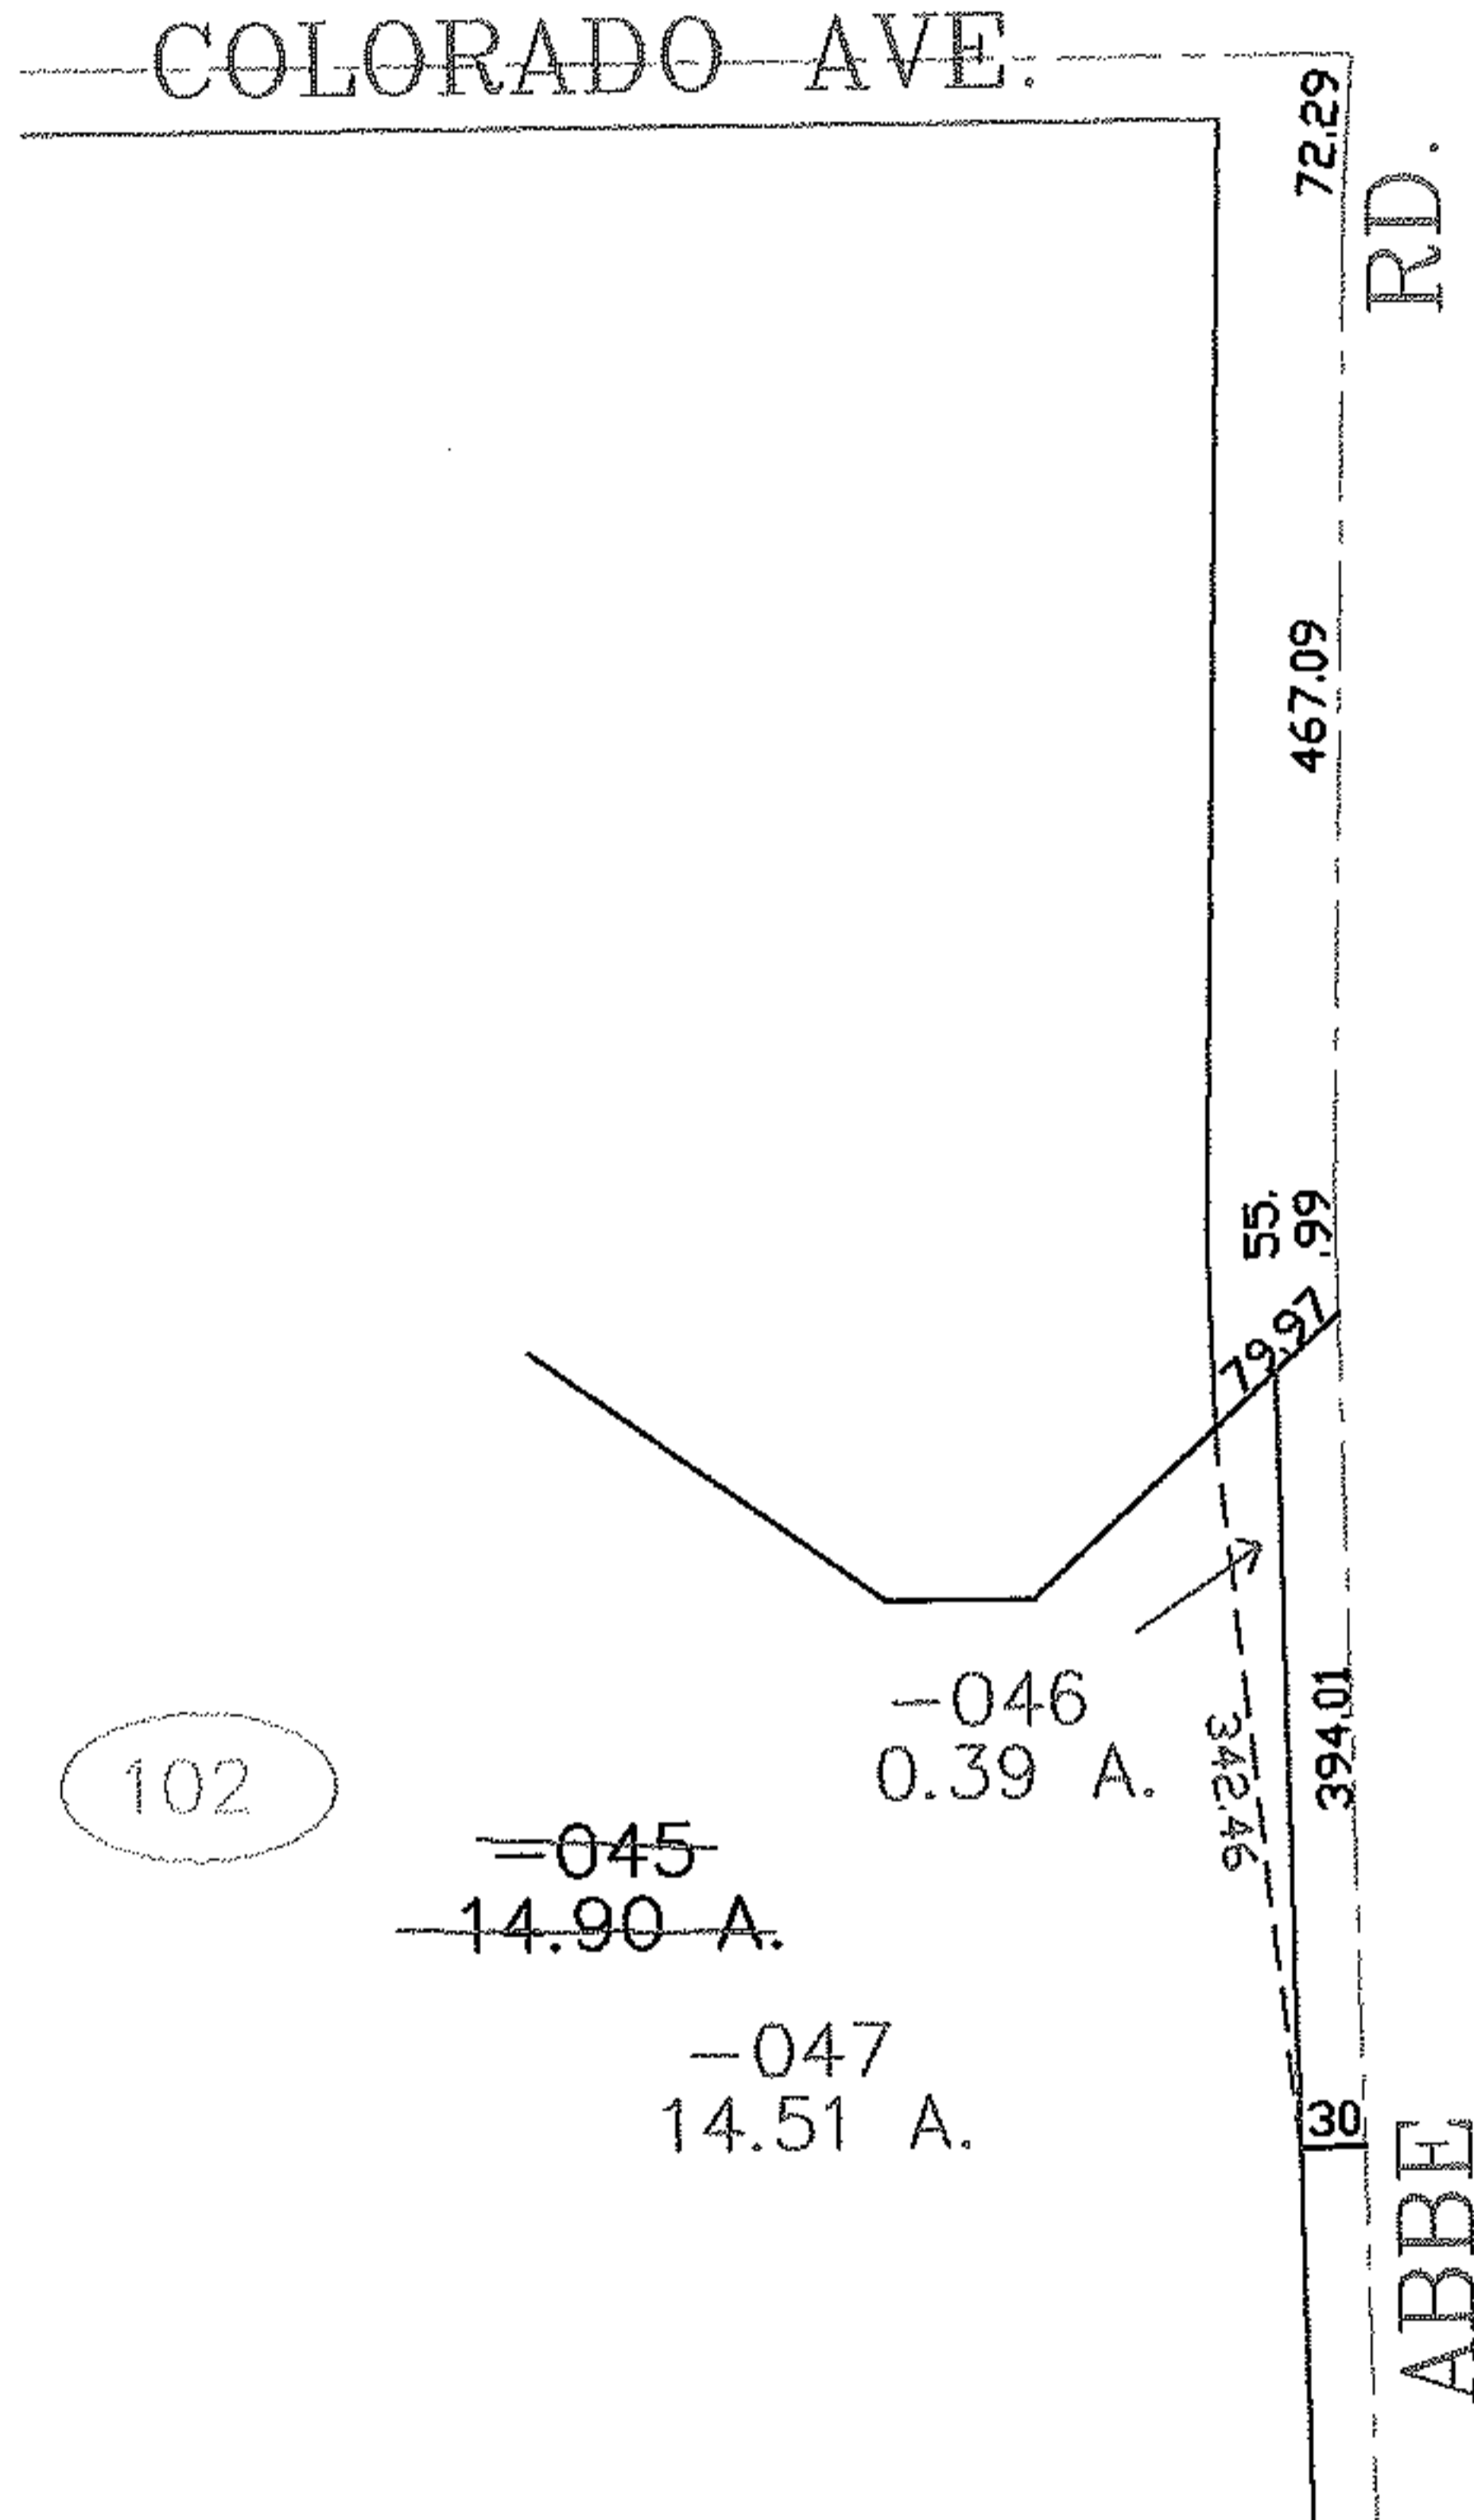


PARENT PARCEL: 03-00-017-102-045

CHILD PARCEL: 03-00-017-102-046, -047

STARTING POINT: CENTERLINE OF COLORADO AVE. & ABBE RD.

NO. 00074

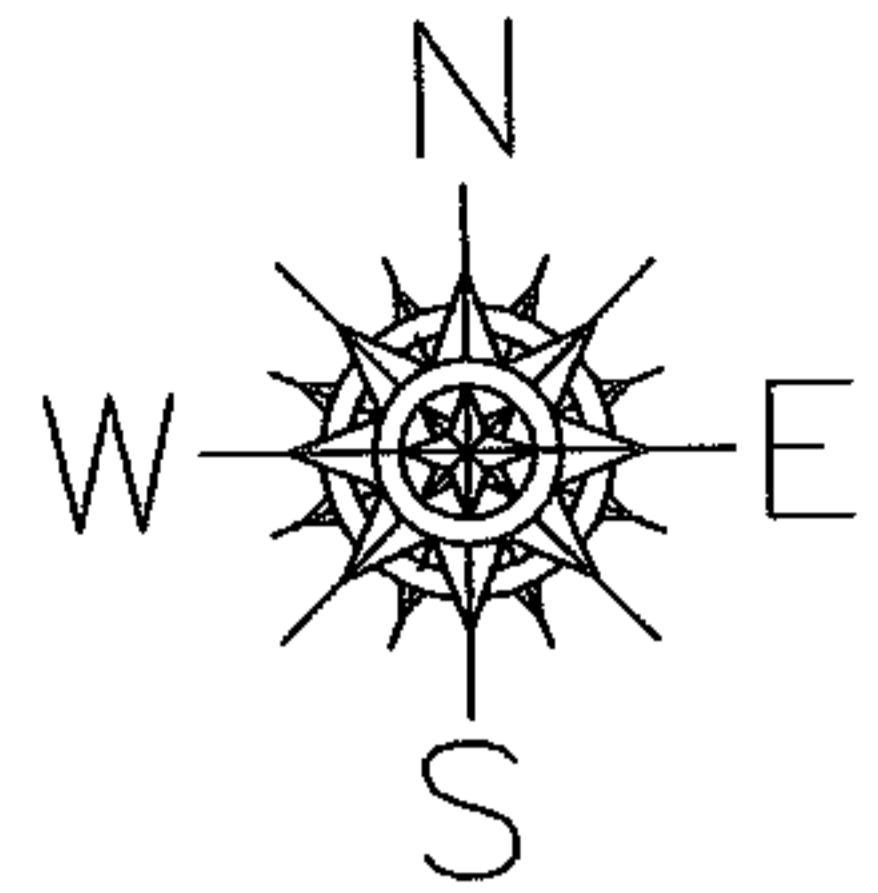

**SPLITS/DEEDS PROCESSED**  
**LORAIN COUNTY TAX MAP DEPARTMENT**  
**226 MIDDLE AVE. ELYRIA, OHIO**

SURVEYED BY: GARY J. DURBIN  
 CLOSURE: 0.00 : 10.000  
 MAP PAGE(S): 03-00-017-B  
 APPROVED BY: JAH DATE: 7-8-03  
 SCALE: 1" = 200 PRIOR INSTRUMENT: 20010744359