



RASTER

PARENT PARCEL: 03-00-068-000-009

CHILD PARCEL:

STARTING POINT: NORTHWEST CORNER OF S/L 19 OF FRENCH CREEK BUSINESS PARK  
(VOL. 65 PGS. 55-56)

NO. 00806-A

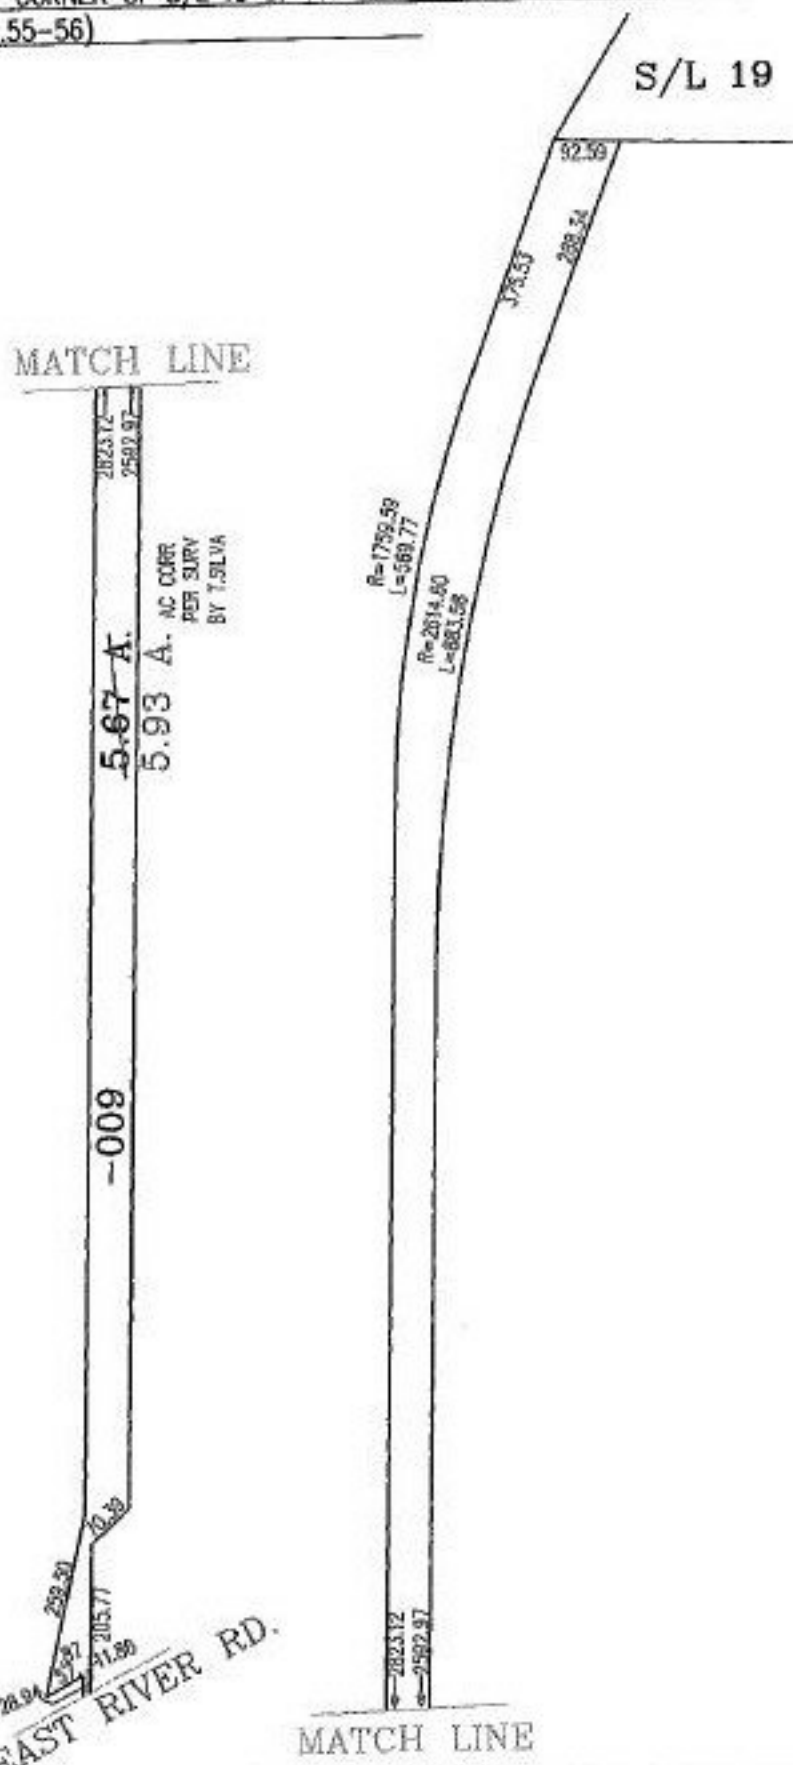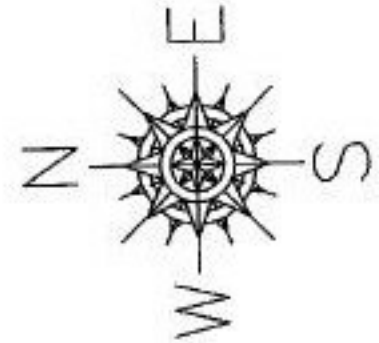

EAST RIVER RD.

MATCH LINE



**SPLITS/DEEDS PROCESSED**  
LORAIN COUNTY TAX MAP DEPARTMENT  
226 MIDDLE AVE. ELYRIA, OHIO

SURVEYED BY: THOMAS E. SILVA  
CLOSURE: N/A  
MAP PAGE(S): 3-K  
APPROVED BY: RRM DATE: 2-10-03  
SCALE: 1" = 300' PRIOR INSTRUMENT: 20000663190