

RASTER

PARENT PARCEL: 11-00-002-900-001

CHILD PARCEL: 11-00-002-900-002 & -003

STARTING POINT: XXXXXX

NO. 00807-C

PARCEL AND SUBDIVISION CORRECTION

~~11-00-002-900-001~~

~~1.05 A.~~


PART SHOULD HAVE GONE INTO WILLOW CREEK SUB NO. 1

11-00-002-900-002 SEE #02-00544

3.72 A. WILLOW CREEK SUB. NO. 1

11-00-002-900-003

0.85 A.

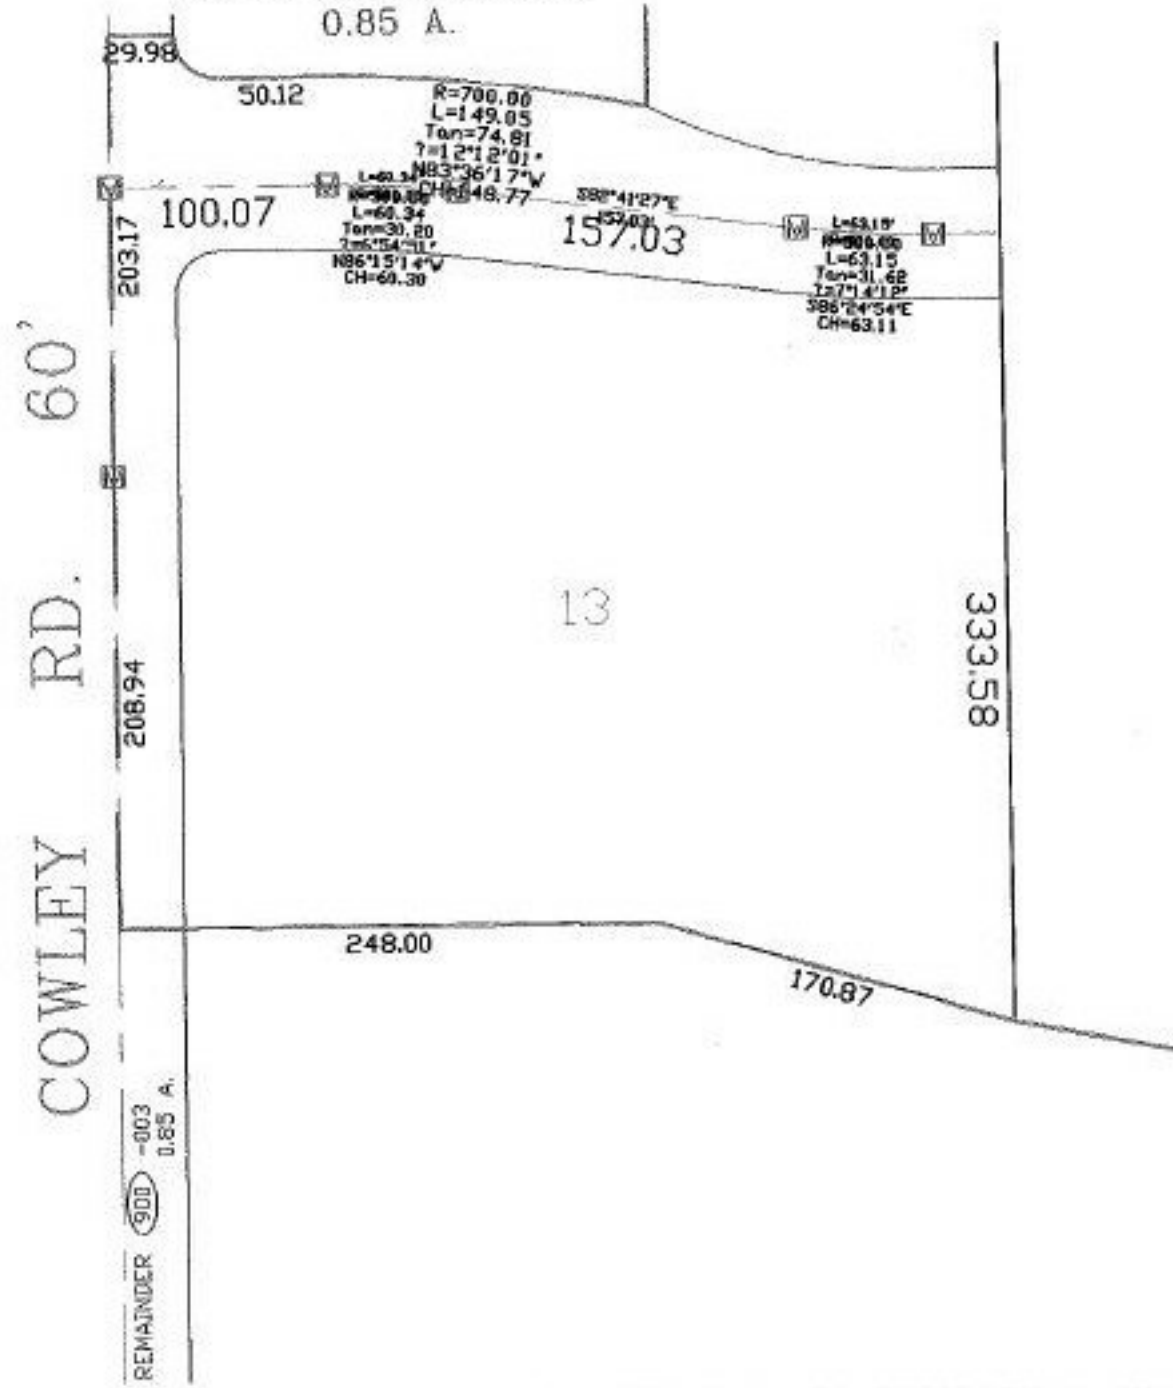

SPLITS/DEEDS PROCESSED
LORAIN COUNTY TAX MAP DEPARTMENT
226 MIDDLE AVE. ELYRIA, OHIO

SURVEYED BY:	ERIC NELSON
CLOSURE:	0.02 : 10.000
MAP PAGE(S):	11-00-002-A
APPROVED BY:	TJS DATE: 2/5/03
SCALE:	1" = 100' PRIOR INSTRUMENT: DV XXXX/XXX